


SHEETS TO BE USED WITH THIS BRIDGE
 SLB 20-CR 30° Skew 20' span With Gravel
 SLAB B' 30° Skew 30' Wings
 SB, 2 Typical Details

SUMMARY OF QUANTITIES
 Structure Excavation Cu. Yd. 250
 Concrete Class A 12-4 " " 34
 " " B 1-2 1/2-5 " " 108
 Reinforcing Structure lbs. 9910
 Temporary Bridge 1 Lump Sum

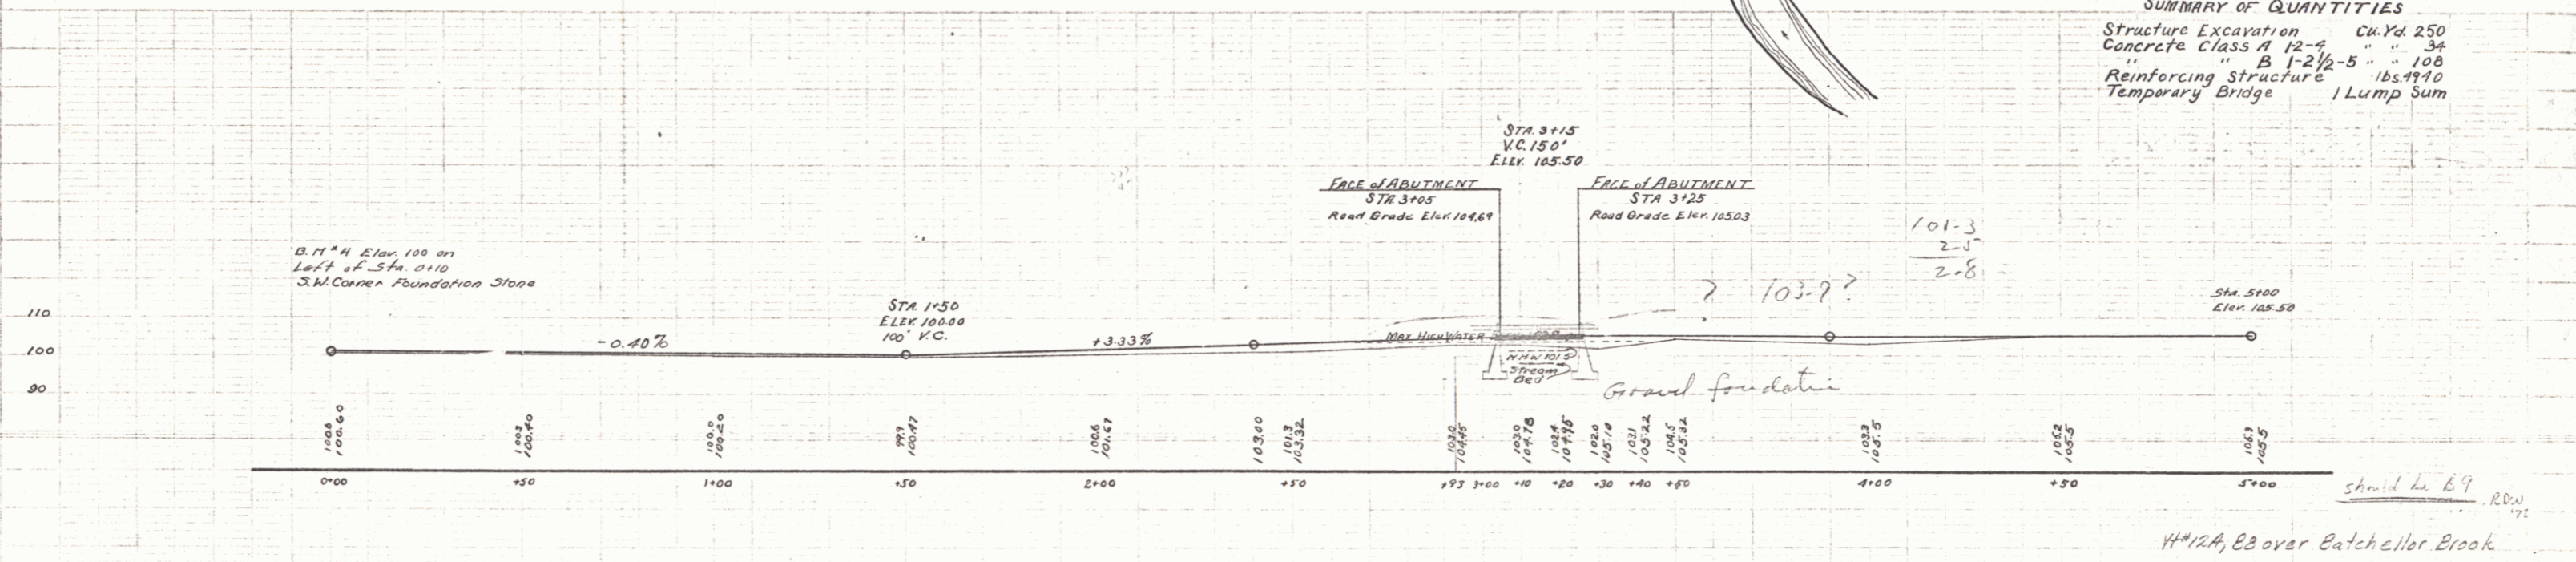

44" x 24" B3 over Betchellor Brook

DISTRICT NO 7
 BRIDGE No 42-129
 BRAINTREE, VT.
 Scales HOR. 1"=20'
 VERT. 1"=20'
 SERIES No. FILED 7-42
 SHEET 14 OF 27 SHEETS

C. D. Bishop