
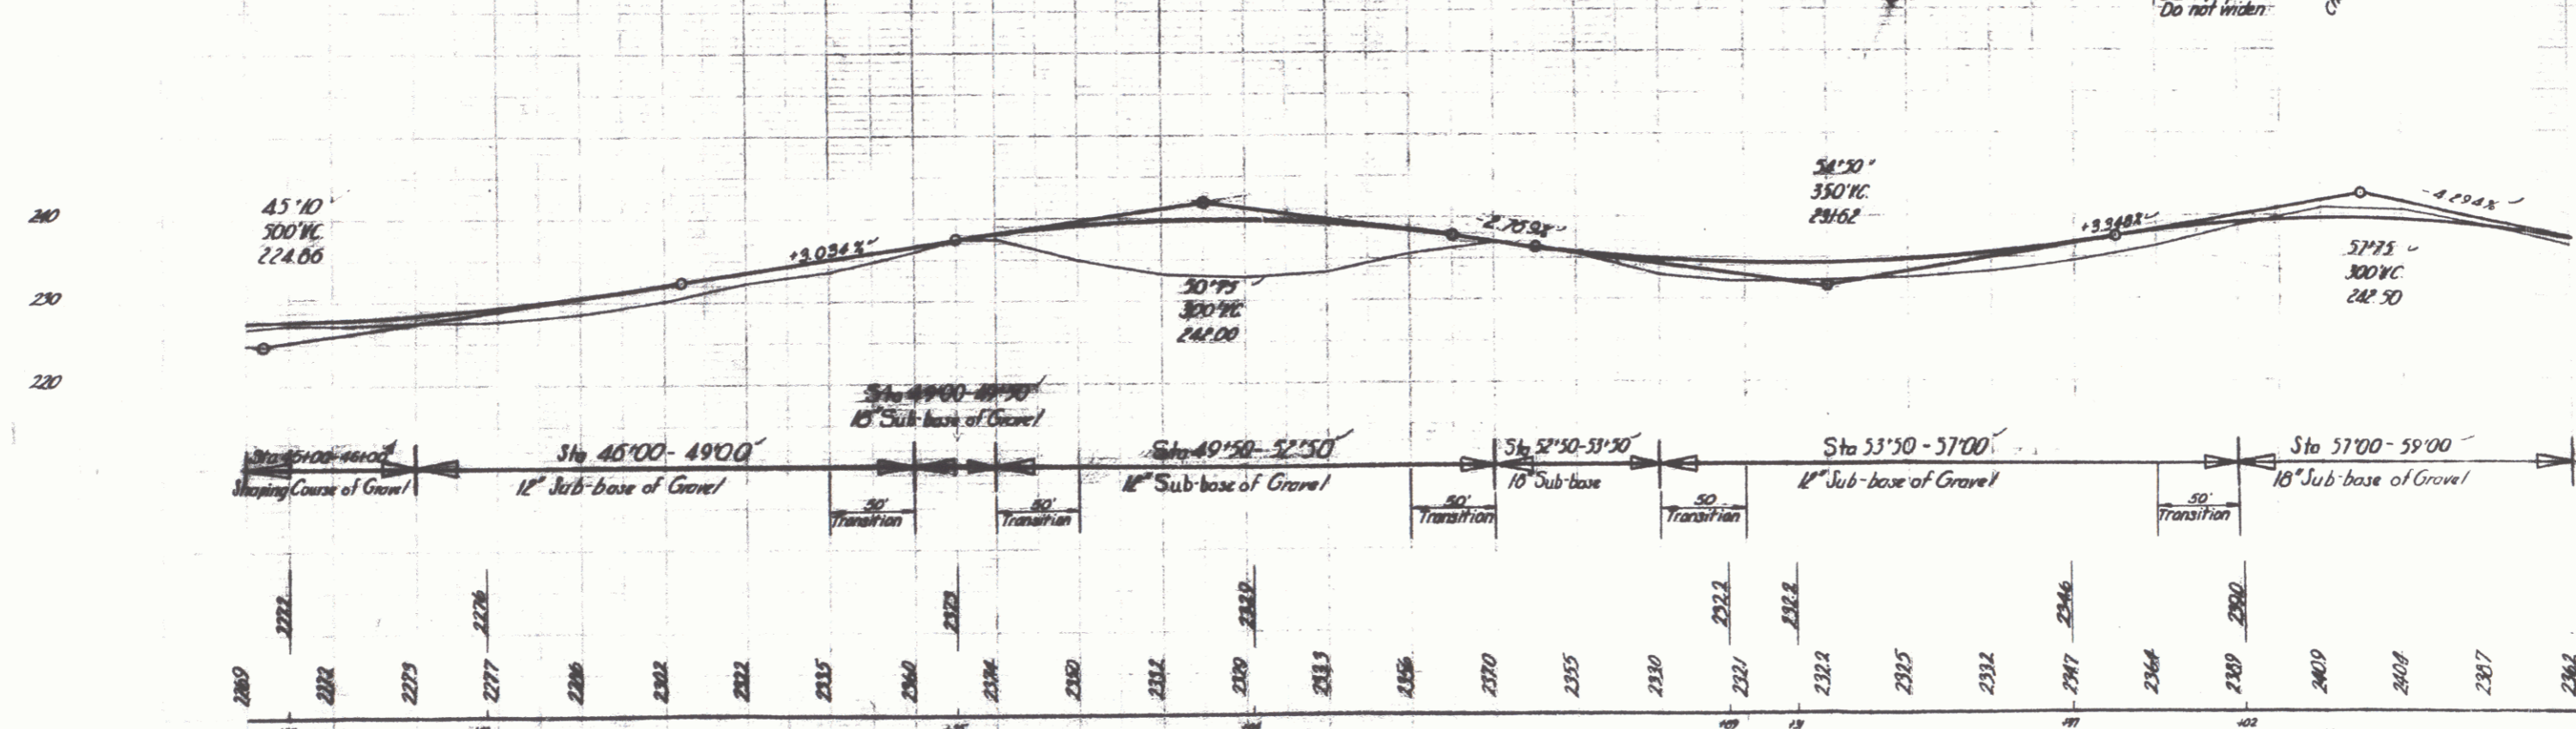


TREES
 O = Remove, then 109

Drives Constructed	STA	POS
	46+70	Lt

FID ROAD 3 FISCAL SHEET TO 4
 DIS NO 14080 PROJ NO 1547 YEAR 70 SHEET 7

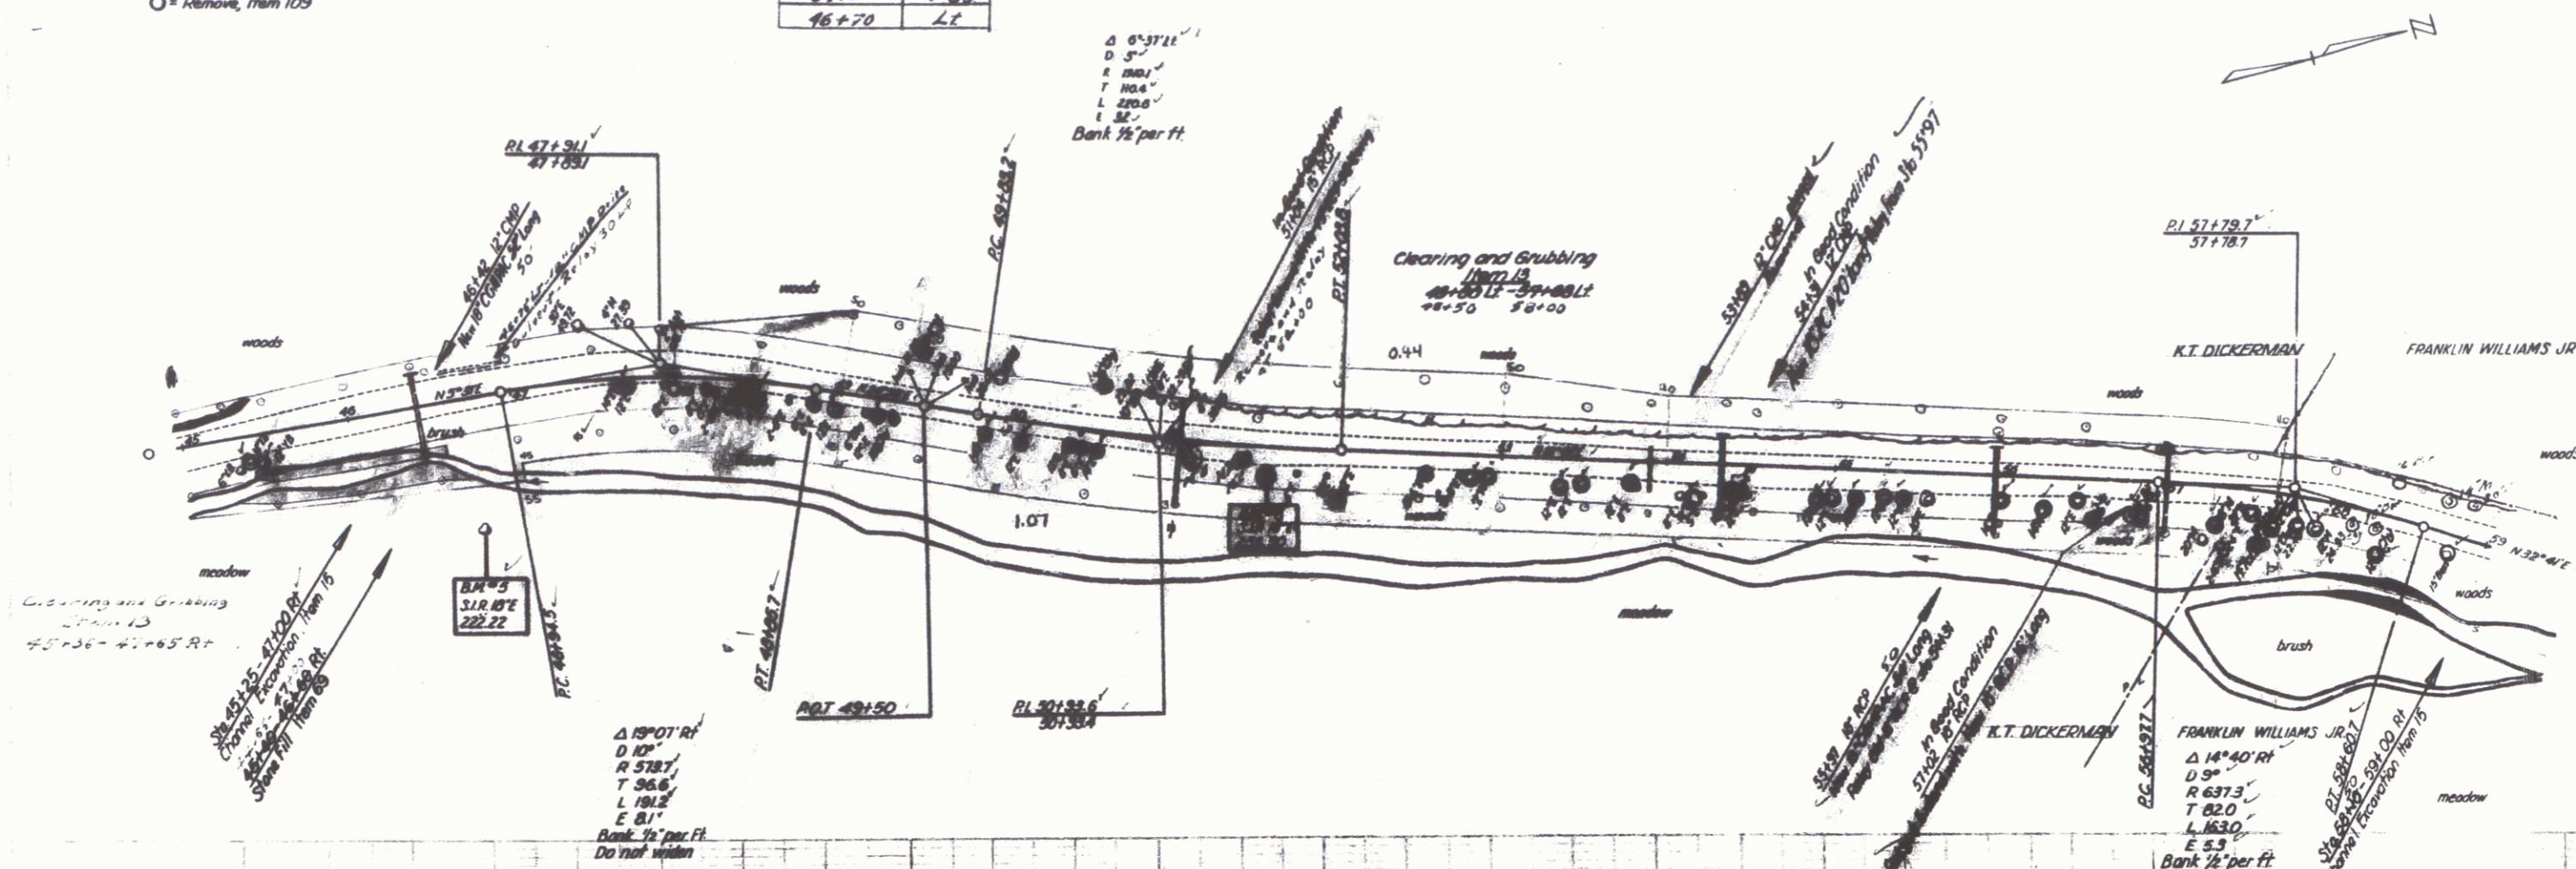

SHEET 7