
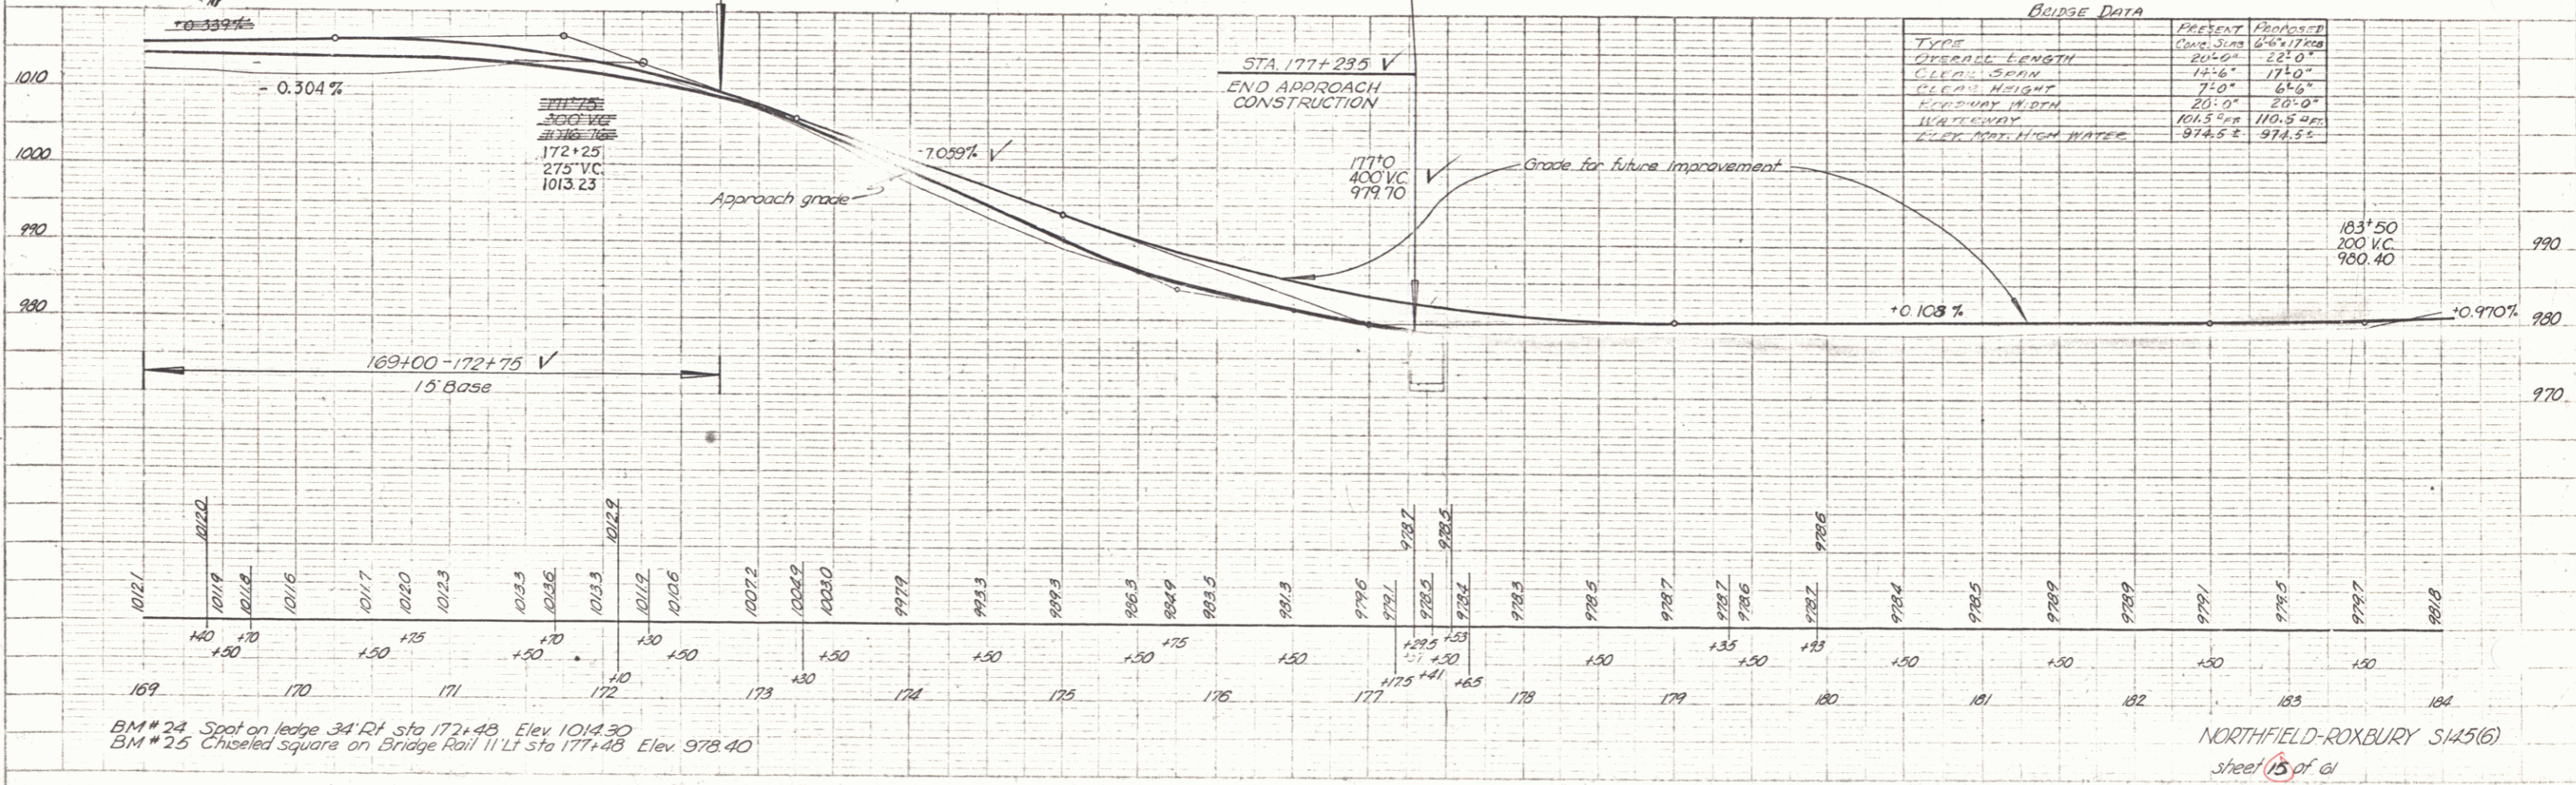


PLAN
 DRAWN BY: G. Lane, E.A. Lavin
 DATE: 7-29-53
 SHEET NO. 15 OF 15

PROFILE
 DRAWN BY: G. Lane, E.A. Lavin
 DATE: 7-29-53
 SHEET NO. 15 OF 15

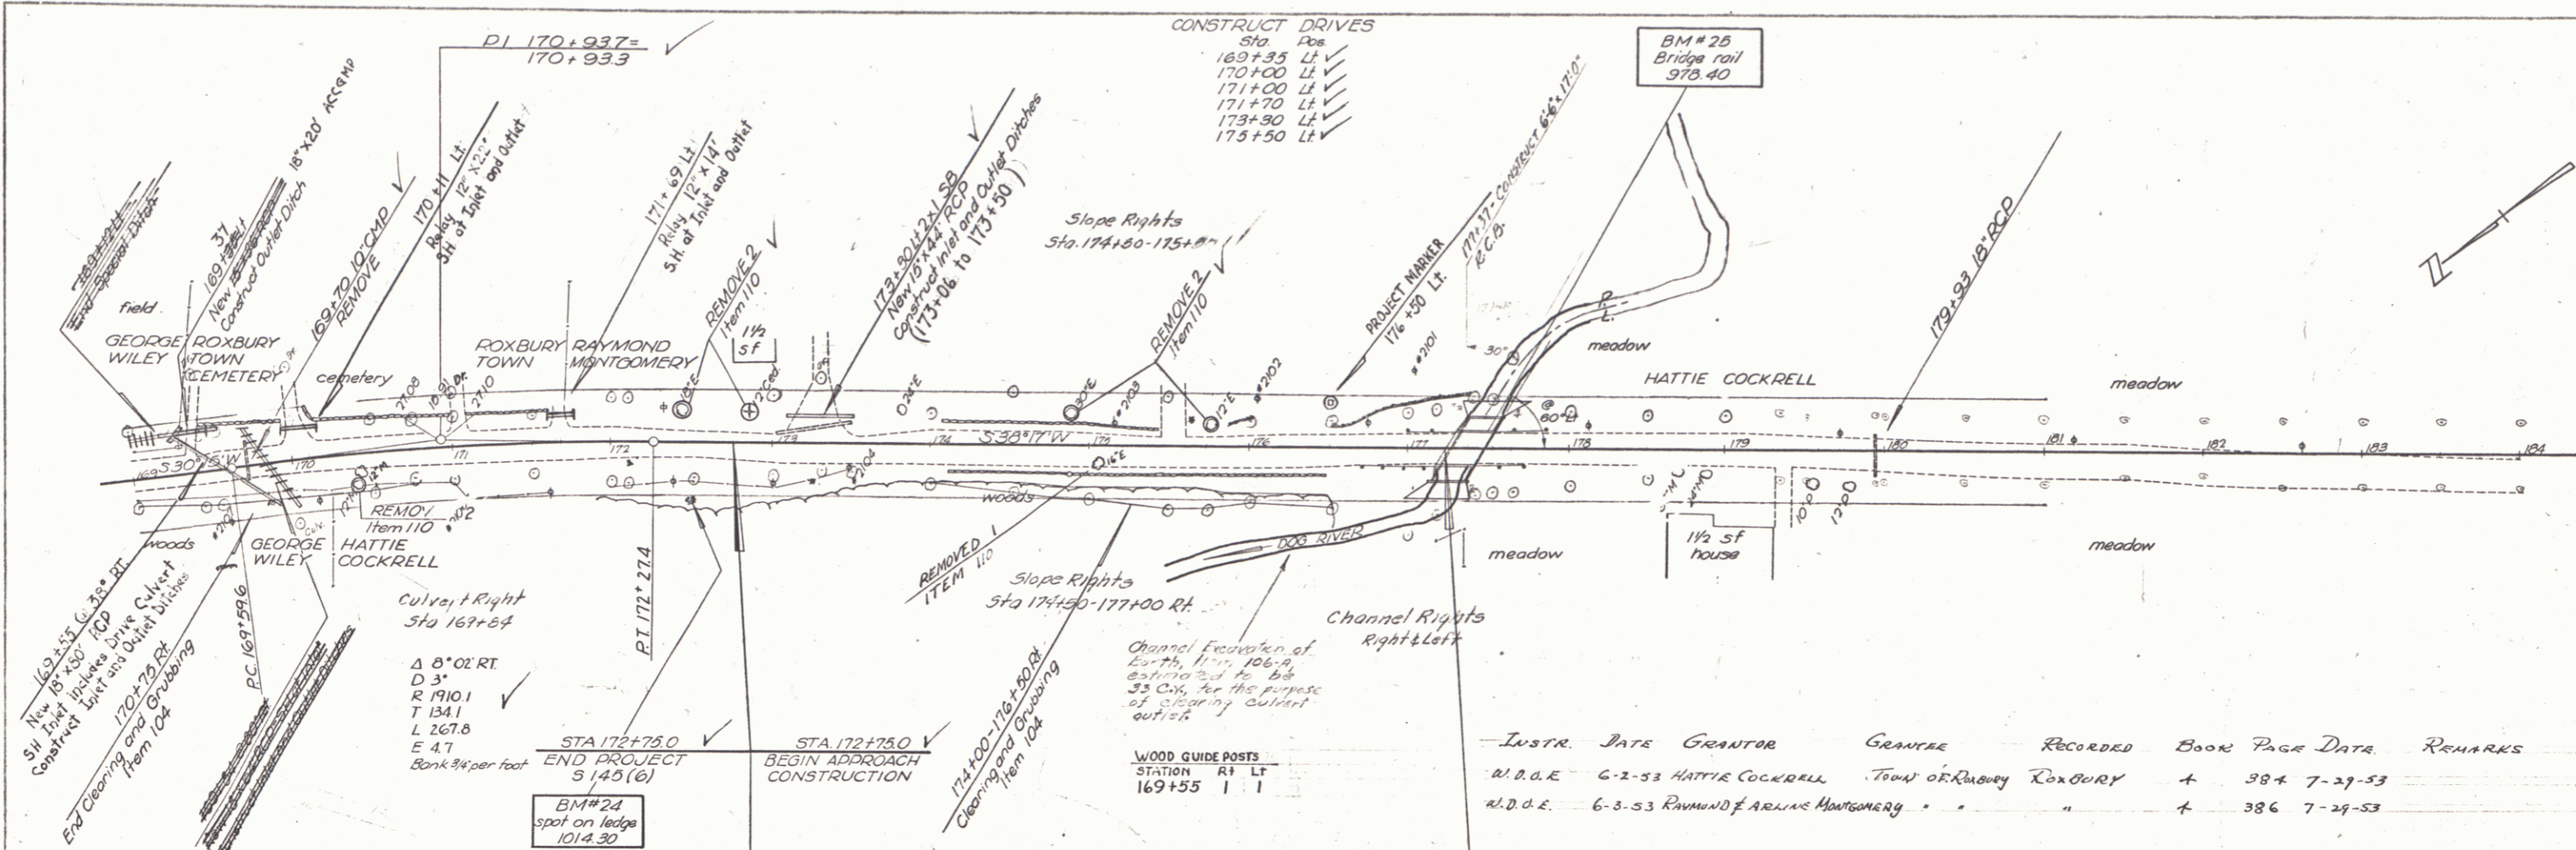

INSTR.	DATE	GRANTOR	GRANTEE	RECORDED	BOOK	PAGE	DATA	REMARKS
M.D.E.	6-2-53	HATTIE COCKRELL	TOWN OF ROXBURY	ROXBURY	+	384	7-29-53	
M.D.E.	6-3-53	RICHARD J. ARIAS MONTGOMERY			+	386	7-29-53	

BM # 24 Spot on ledge 34' Rt sta 172+48 Elev 1014.30
 BM # 25 Chiseled square on Bridge Rail 11' Lt sta 177+48 Elev 978.40

NORTHFIELD-ROXBURY S145(6)
 sheet 15 of 15