



PLAN
 DATE: 1946
 DRAWN BY: S. L. HANNING
 CHECKED BY: S. L. HANNING
 PROJECT NO. 14503

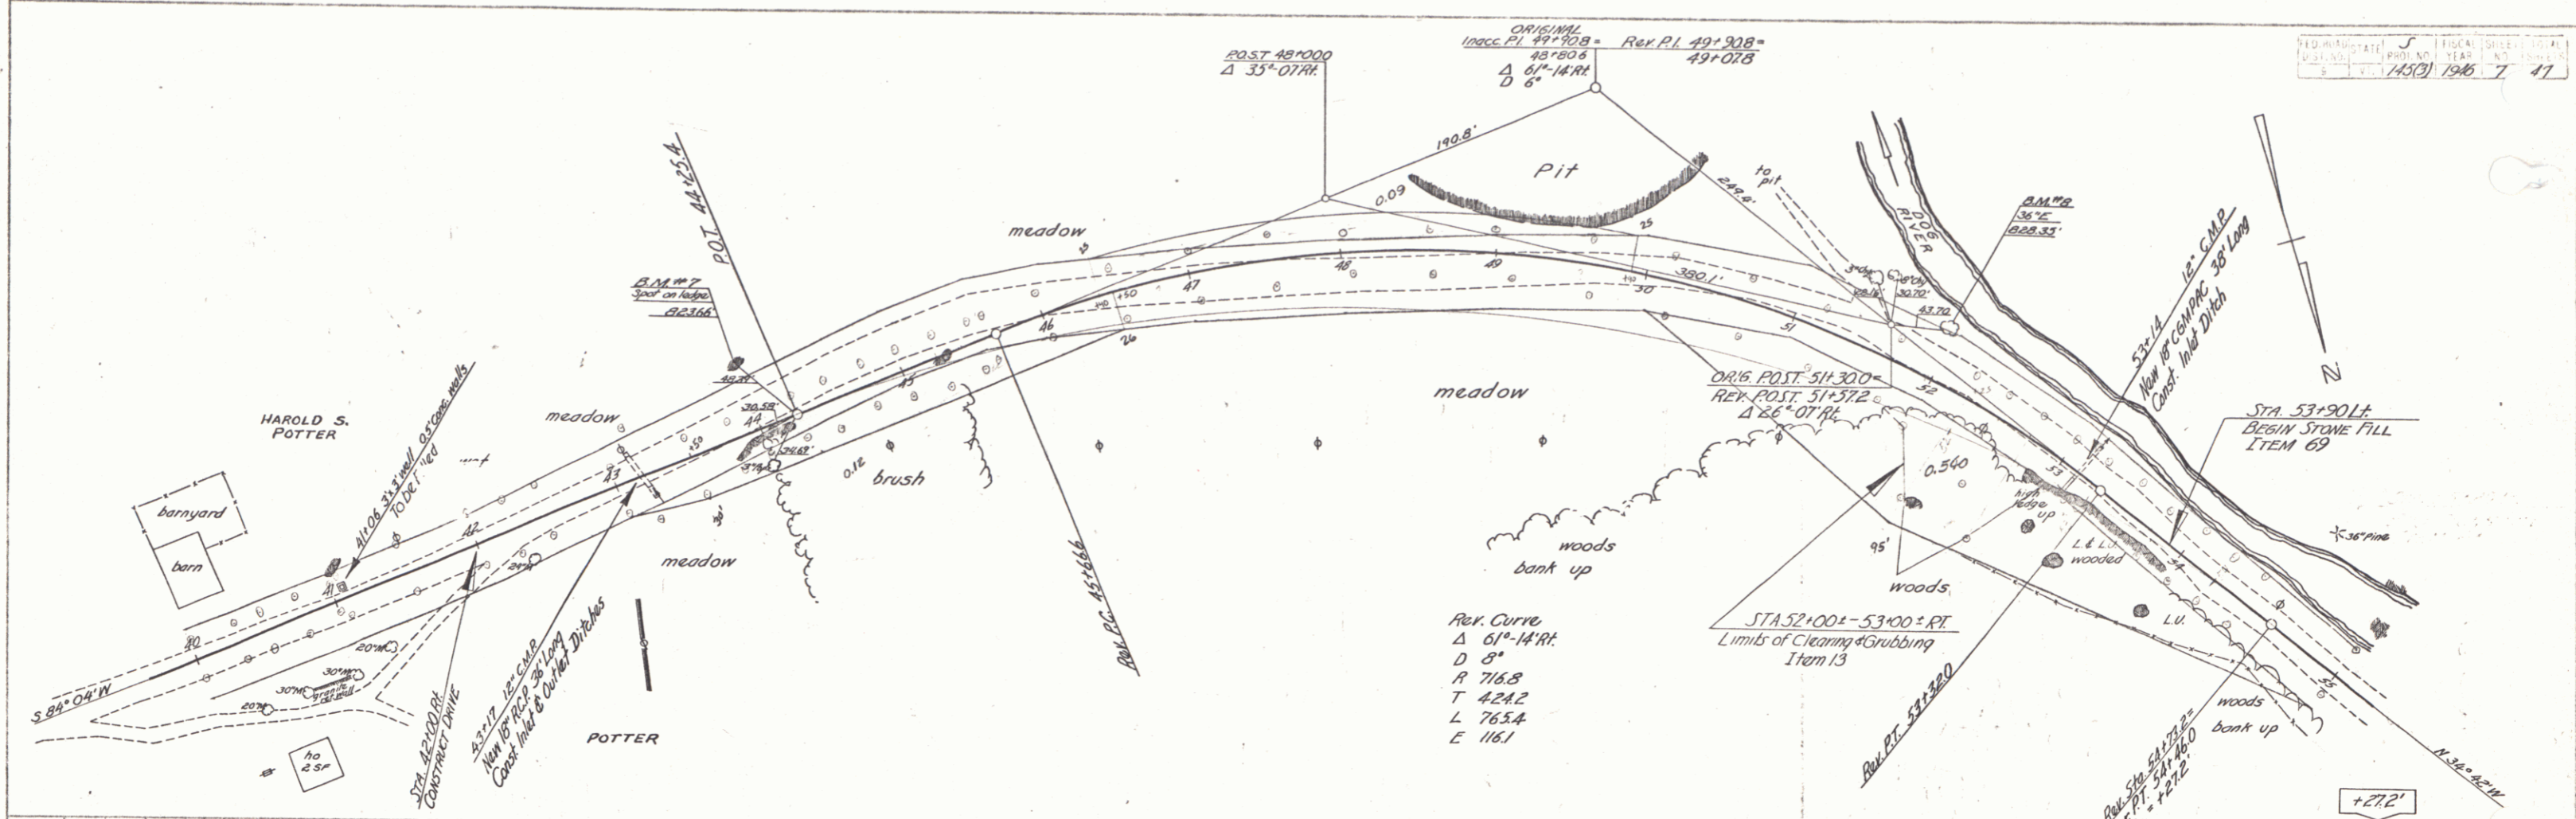

PROFILE
 DATE: 1946
 DRAWN BY: S. L. HANNING
 CHECKED BY: S. L. HANNING
 PROJECT NO. 14503

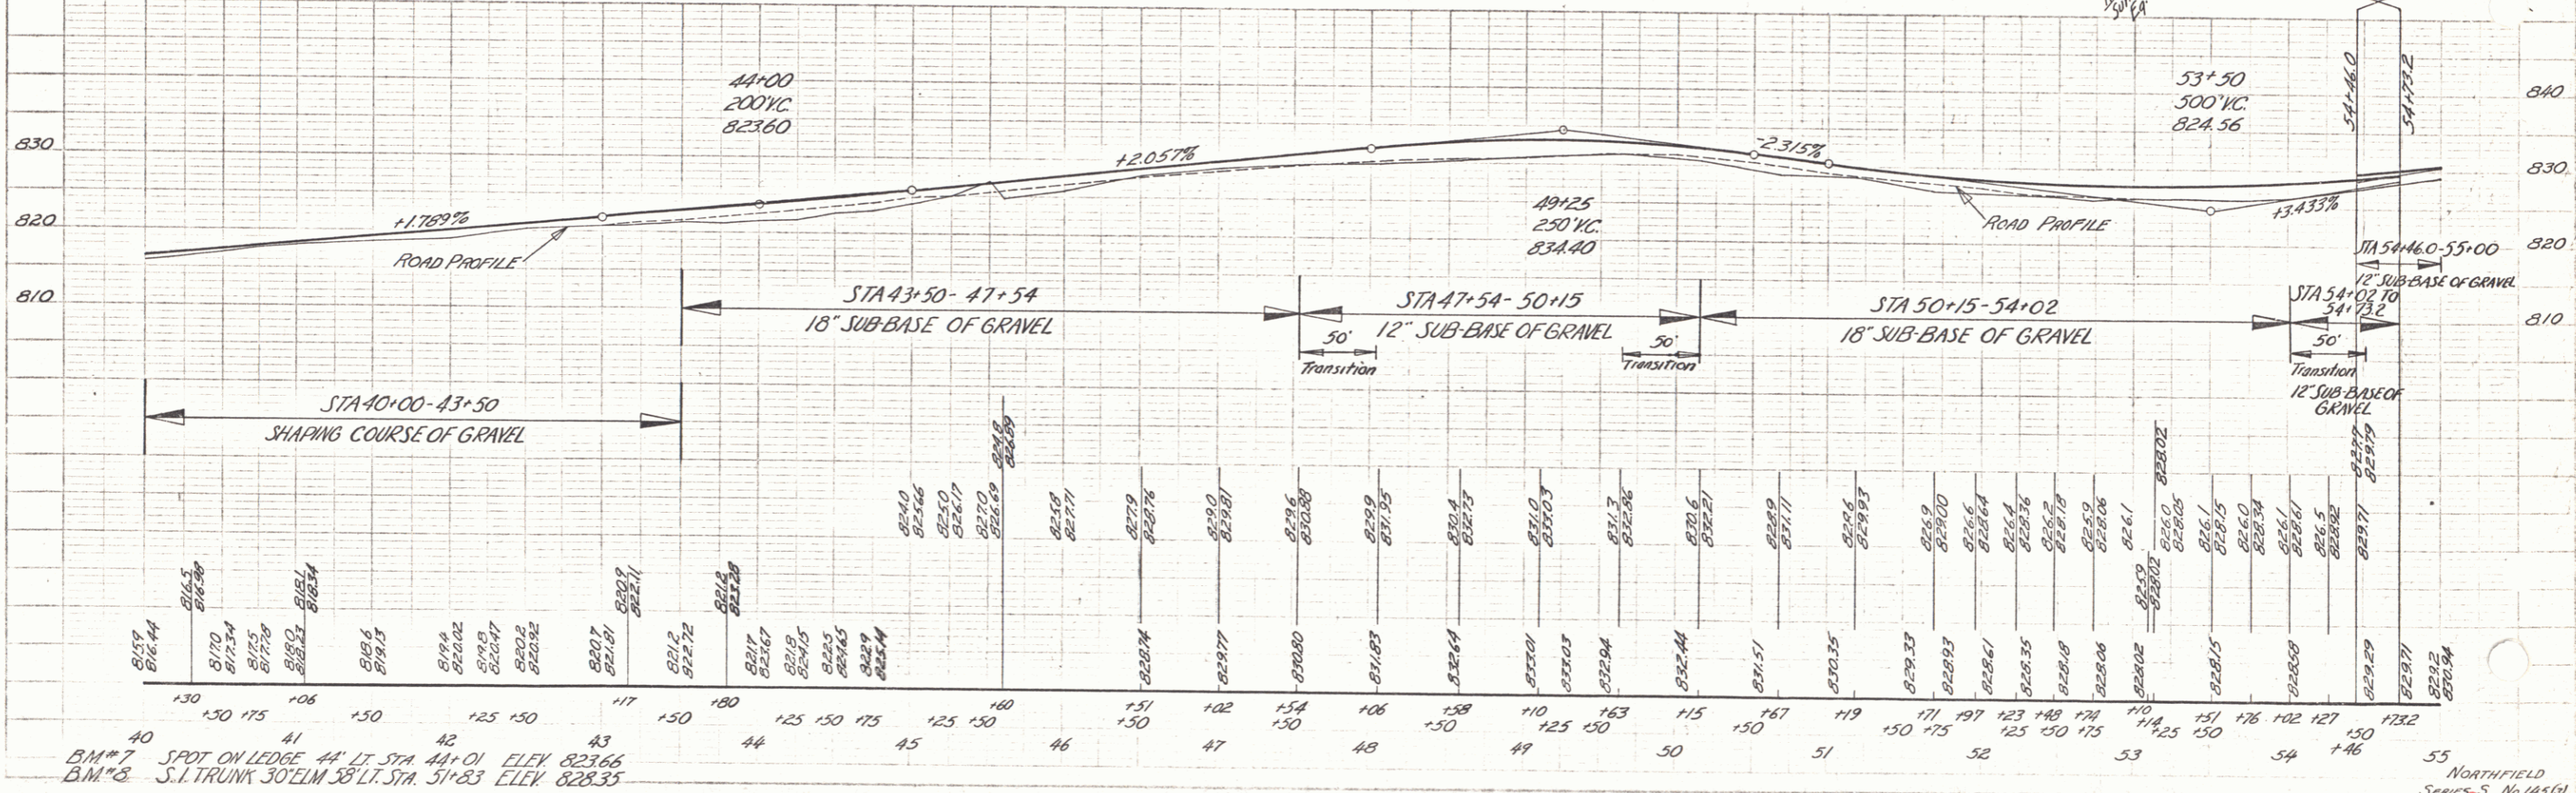

40 B.M. #7 SPOT ON LEDGE 44' LT. STA 44+01 ELEV. 823.66
 41 S.I. TRUNK 30' ELM. 58' LT. STA. 51+83 ELEV. 828.35

NORTHFIELD
 SERIES No. 145(9)
 SHEET 7 of 47

5