

CONSTRUCT DRIVE
 57+25 Lt. ✓
 57+07 Lt. ✓
 59+00 Lt. ✓
 57+25 Rt. ✓

VERTICAL GRANITE CURB, ITEM 556-D
 56+86 - 57+20 Lt.
 57+58 - 57+71 Lt.
 57+92 - 58+32 Lt.
 58+64 - 58+88 Lt.
 59+30 - 59+43 Lt.

CONCRETE RADIUS CURB, ITEM 401-B
 57+03 - 57+08 Rt.
 57+43 - 57+48 Rt.


5" CEMENT CONCRETE SIDEWALK, ITEM 560
 57+40 - 57+65 Lt.
 57+92 - 58+28 Lt.
 58+71 - 58+87 Lt.

8" CEMENT CONCRETE SIDEWALK, ITEM 560
 56+75 - 56+88 Lt.
 58+26 - 58+71 Lt.
 57+65 - 57+97 Lt.
 58+31 - 58+87 Lt.

HARTFORD

SURVEYED BY Jewell DATE 9/65
 DRAWN BY Kacin DATE 10/65
 TRACED BY PFW DATE 11/65

PROJ. F. NO. 020-3(1)
 SHEET 26 OF 136

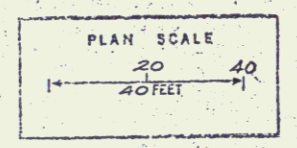

48