


Revised  
Δ 1°00' Lt  
D 0°15'  
R 22918.32  
T 197.97  
L 344.23  
E 0.87

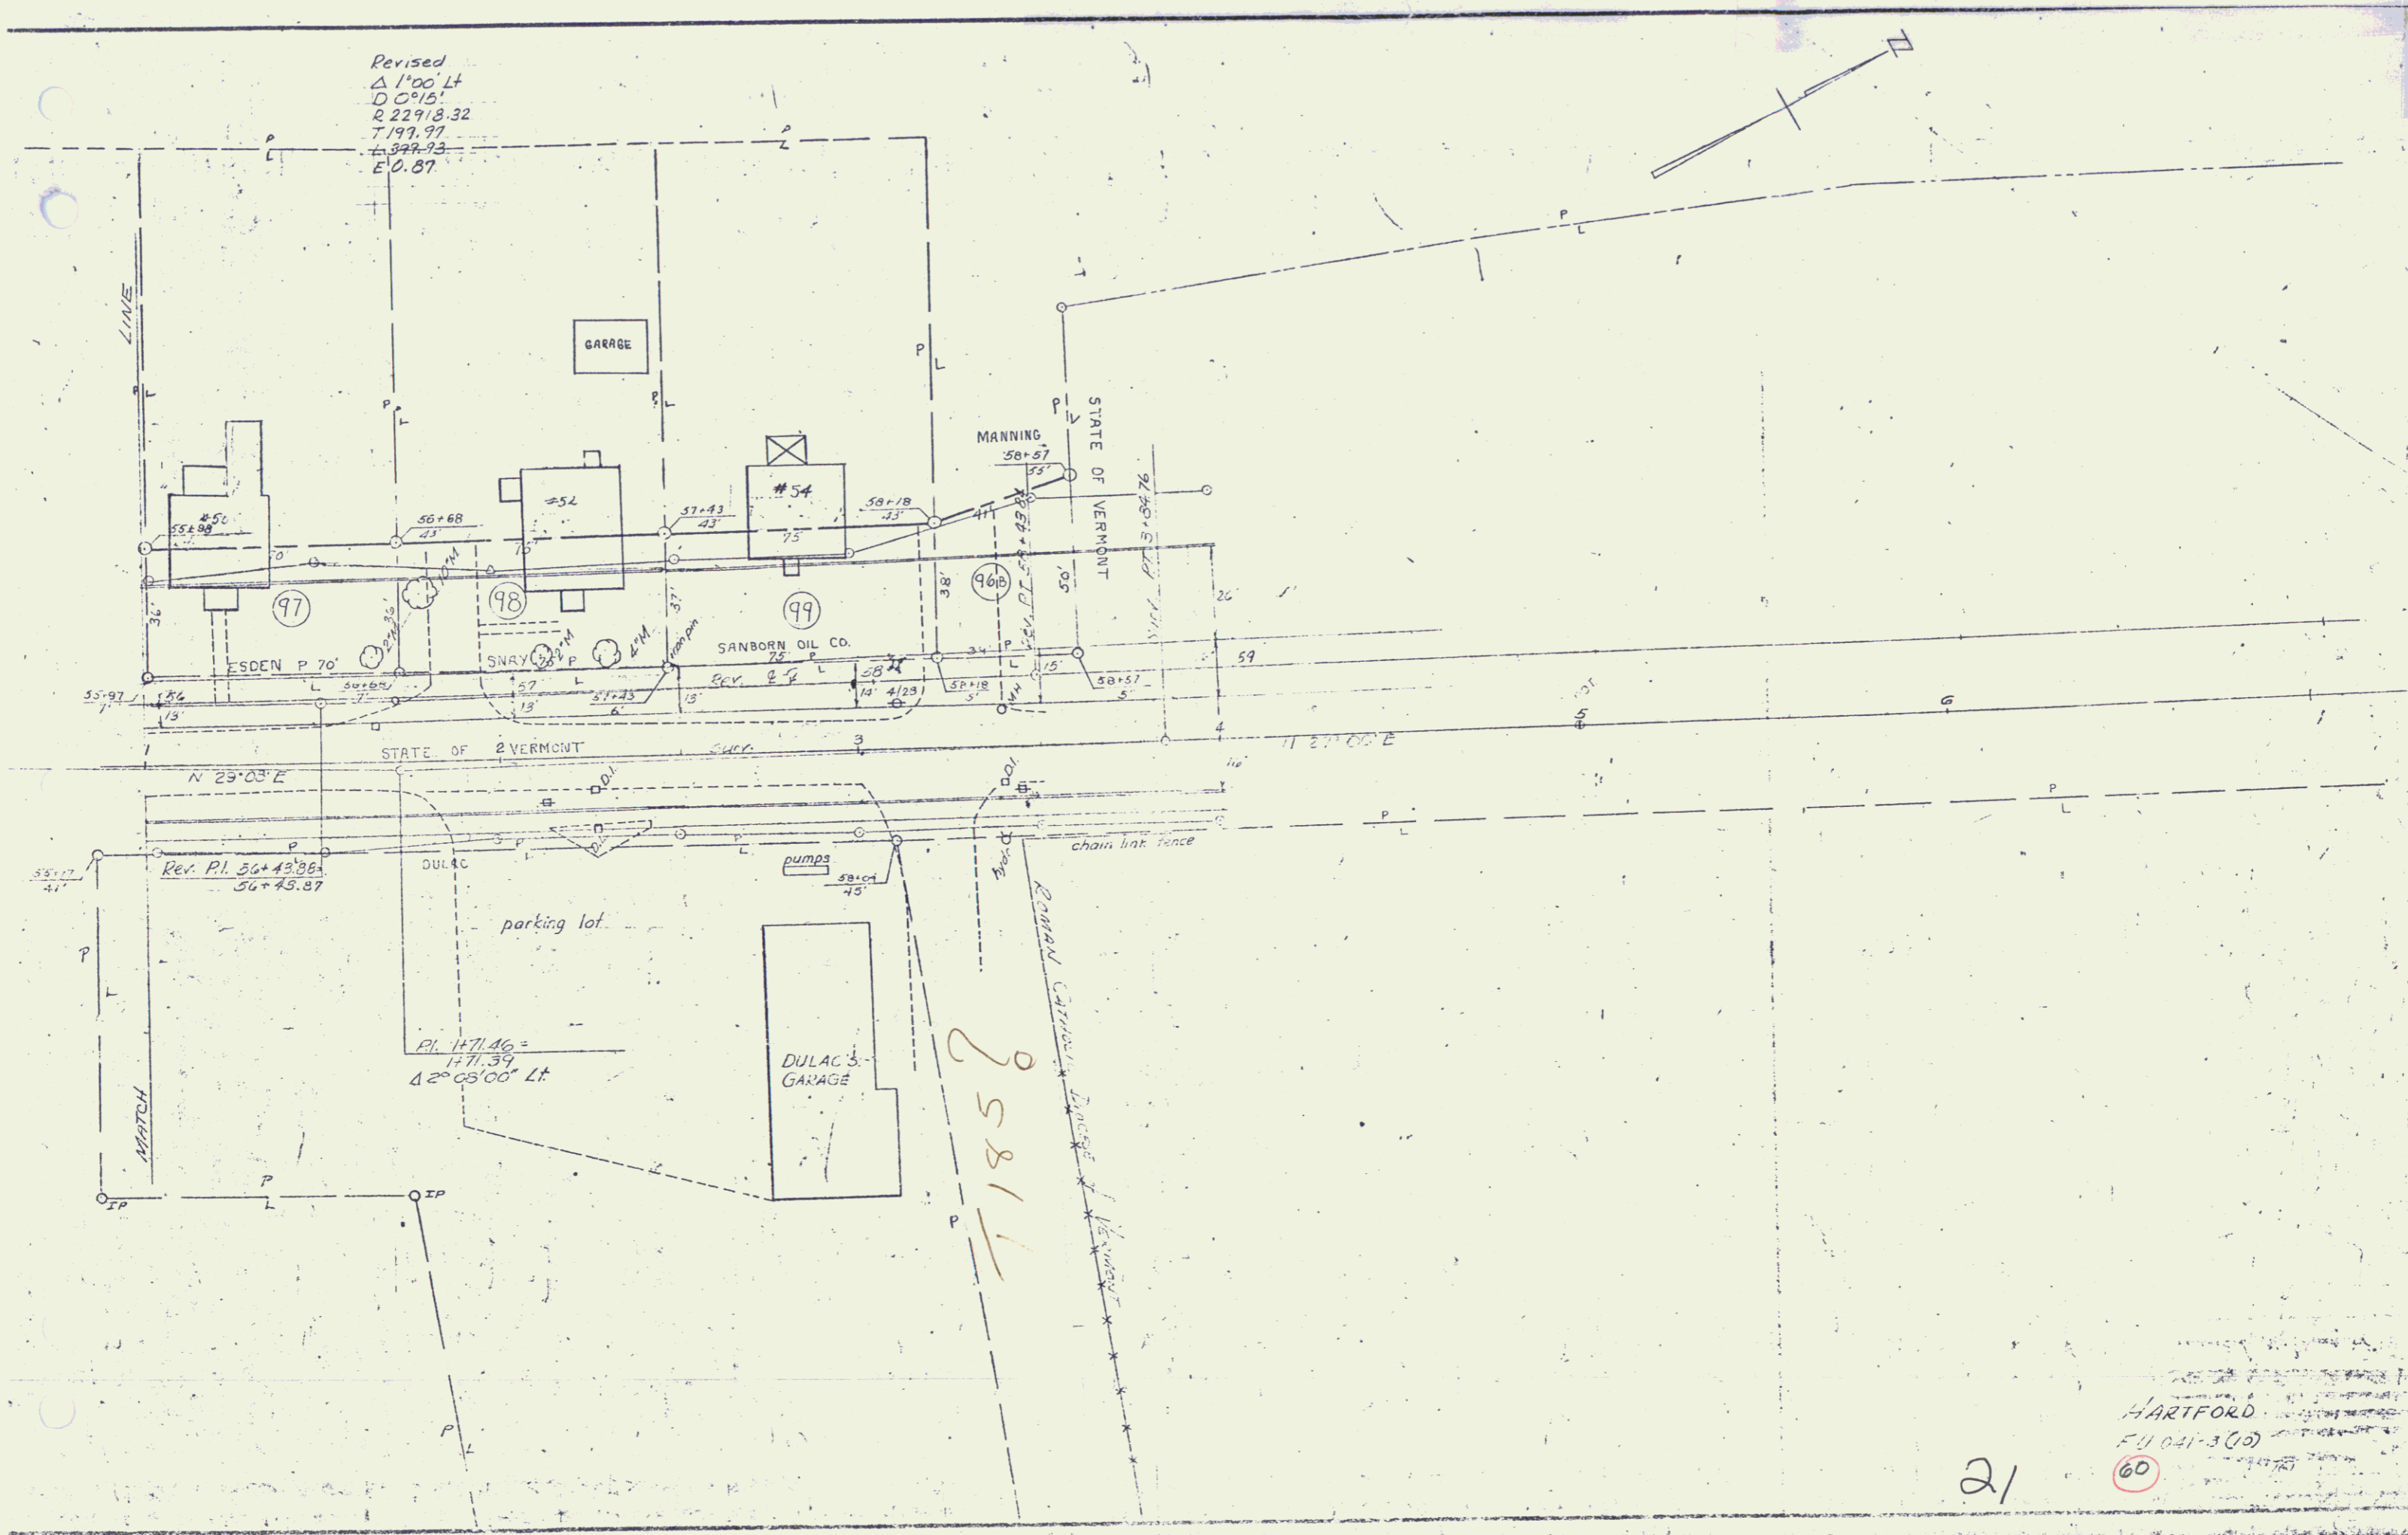

21

HARTFORD  
FD 041-3(0)  
60

47