


STATE OF VERMONT
DEPARTMENT OF HIGHWAYS
Proposed Improvement

TOWN OF HARTFORD
COUNTY OF WINDSOR
U.S. 5 - WHITE RIVER JCT. - BRADFORD ROAD

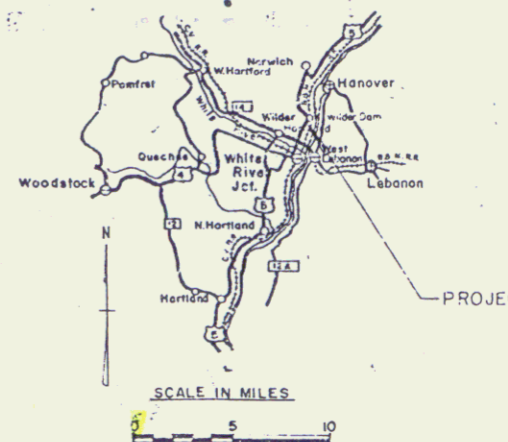

INDEX OF SHEETS

1	TITLE SHEET	35	E-11 INTERSTATE ROUTE MARKERS
2	TYPICAL SHEET	36	E-12 U.S. ROUTE MARKERS
3	QUANTITY SHEET	37	E-15 REGULATORY SIGNS
4	DRAINAGE SHEET	38	E-16 WARNING SIGNS
5	EARTHWORK SHEET	39	E-18 GUIDE SIGNS
6	BLANK	40	E-19 STANDARD SIGN PLACEMENT
7	FLOW DETAIL SHEET	41	E-20 DELINEATORS, HAZARD MARKERS & MILEPOSTS
8-10	PLAN & PROFILE SHEETS	42	E-21 GROUND MOUNTED SIGN SUPPORTS
11	BLANK	43	BLANK
12	A-61 SOLID ROCK EXCAVATION	44	E-31 FEDERAL AID CONSTRUCTION IDENTIFICATION SIGNS
13	B-1 BANKING TABLES	45	G-3 THREE CABLE GUARD RAIL
14	B-5 TYPICAL SLOPE GRADING	46	G-4 STEEL MARKER POSTS
15	B-10 EMBANKMENT ON A SLOPE	47	J-1 PROJECT & BOUNDARY MARKERS
16	B-11 METHOD OF SLOPE STABILIZATION	48	BLANK
17	B-13 WEDGE INTERSECTIONS	49-67	MARLINE CROSS-SECTIONS SHEETS
18	B-16 TRIANGULAR ISLAND DESIGNS	68-70	TRAFFIC SIGN LOCATION SHEETS
19	BLANK	71	TRAFFIC SIGN SUMMARY SHEET
20	C-1 CURBS	72	TRAFFIC SIGN DESIGN & CONSTRUCTION DETAILS
21	C-1A CURBS	72A-72B	UTILITY CONSTRUCTION DETAILS FOR RIGHT-OF-WAY DETAILS SEE RIGHT-OF-WAY PLANS FOR THIS PROJECT
22	C-2A DRIVE ENTRANCES		
23	C-2B DRIVE ENTRANCES		
24	D-2 HEADWALLS		
25	D-3 JUTE MATTING		
26	D-4 ELBOWS		
27	BLANK		
28	D-8 R.C.D.I.S.		
29	D-9 DROP INLET TOPS		
30	D-10 DROP INLET TOPS		
31	D-11 DETAILS OF GRATES & COVERS		
32	D-13 CONCRETE CATCH BASIN OR MANHOLE		
33	BLANK		
34	E-1 BARRICADES, SIGNS & LIGHTS		

BEGINNING AT A POINT 2796 FEET SOUTHERLY OF THE HARTFORD-NORWICH TOWN LINE AND EXTENDING NORTHERLY 0.384 MILE.
LENGTH OF ROADWAY 2,025 FEET = 0.384 MILE
LENGTH OF PROJECT 2,025 FEET = 0.384 MILE

PROJECT NAME & NUMBER TYPE PAVEMENT AREA
HARTFORD U 041-3(7) BIT. CONC. PAVT. 7300 SQ. YD.
RECORD PLANS
MATERIALS




F.A. URBAN LIMITS

CONVENTIONAL

ROW	CONVENTIONAL
COUNTY LINE	---
TOWN LINE	---
EDGE LINE	---
STONE WALL	---
UNFENCED PROPERTY	---
GRAVEL RAIL	---
TRAVELLED WAY	---
RAILROAD	---
RETAINING WALL	---
CENTER LINE	---
SURVEY LINE	---
CULVERT	---
DROP INLET	---
TRAVEL POLE	---
WATER POLE	---
TELEPHONE POLE	---
TREES	---
WELLS	---
LIMITED ACCESS	---

SLOPE RIGHTS

SHAPE	ELEVATION	...
CLIQUE DATA
DIRECTION OF CURVE
RADIUS OF CURVE
TANGENT ON CURVE
LENGTH OF CURVE
EXTERNAL ANGLE
POINT OF TANGENCY
POINT OF CURVATURE
POINT OF INTERSECTION
STATION ON SIGHTMENT

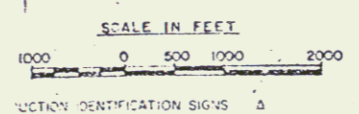

MP 4.752
U.S. 5 1+00
BEGINNING
U 041-3(7)

MPS 136
U.S. 5 21+25.00
END PROJECT
U 041-3(7)

THESE PLANS ARE SUBJECT TO SUCH REVISIONS AS MAY BE REQUIRED BY THE BUREAU OF PUBLIC ROADS OR THE COMMISSIONER OF HIGHWAYS.

CONSTRUCTION IS TO BE CARRIED ON IN ACCORDANCE WITH THESE PLANS AND THE STANDARD SPECIFICATIONS FOR HIGHWAY AND BRIDGE CONSTRUCTION DATED APRIL 1964, AS APPROVED BY THE BUREAU OF PUBLIC ROADS ON OCTOBER 2, 1964, INCLUDING ALL SUBSEQUENT APPROVED REVISIONS AND SIGN REVISION SPECIFICATIONS AND SPECIAL PROVISIONS AS ARE INCORPORATED IN THESE PLANS.

Proj # U 041-3(7)
Pn # 99R908
TO BE BUILT IN ITS ENTIRETY DURING STAGE 1 CONSTRUCTION

J. Schaefer 1/20/65
G. M. Lane 1/20/65
ADD. J. Schaefer 1/20/65

U 041-3(7)