

VERTICAL GRANITE CURB  
ITEM 556-B  
98+00 - 101+00 Lt.  
101+40 - 102+18 Lt.  
102+30 - 102+71 Lt.  
103+08 - 103+68 Lt.  
98+00 - 98+39 Lt.  
98+57 - 103+44 Lt.

CONSTRUCT DRIVE  
98+40 Lt.  
102+24 Lt.  
STONE FILL, ITEM 512  
102+65 Lt.

CONSTRUCT COMM. DRIVES  
101+20 Lt.  
102+09 Lt.

5' CEMENT CONC. SIDEWALK, ITEM 560  
98+00 - 103+44 Lt.  
98+00 - 101+00 Lt.  
101+40 - 102+71 Lt.  
103+08 - 103+68 Lt.

See Sheet 113 of 120 Sheets  
for Additional Drainage.

$\Delta 12^{\circ}26'10''$   
D 3'  
R 1909.06'  
T 20809'  
L 414.54'  
E 1127'  
Bank  $7/6/11$

CUTTING & REMOVING TREES, ITEM 102  
99+42 Lt. 99+93 Lt.  
99+66 Lt. 100+20 Lt.  
99+68 Lt. 100+89 Lt.  
99+71 Lt.

REMOVAL & DISPOSAL OF BUILDING  
ITEM 588  
99+10 Lt.

JUTE MATTING, ITEM 623  
98+60 - 98+60 Lt.


STANDARD STEEL BEAM GUARD RAIL  
ITEM 545-A  
99+65 - 100+94 Lt. Def. Wall  
99+50 - 99+50 Lt. Barricade  
100+00 - 100+30 Lt. Barricade  
100+30 - 100+30 Lt. Barricade

REMOVAL & DISPOSAL OF PRESENT  
GUARD RAIL, ITEM 549  
98+10 - 100+33 Lt.  
99+64 Lt. - 100+26 Lt.

REMOVAL OF EXISTING PAVEMENT  
ITEM 103-B  
100+75 Lt. - 103+44 Lt. & Lt.

DDAGLINE RENTAL  
ITEM 122  
99+75 - 100+75 Lt.

Tie existing water  
services into new  
line.

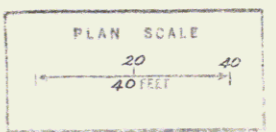

HARTFORD  
SURVEYED BY Jewett DATE 9/85  
DRAWN BY Kirin DATE 9/85  
TRACED BY Austin DATE 10/85  
PROJ. F No. 041-2(5)  
SHEET 76 OF 120

9a 6