

INDEX OF SHEETS

SHEET NO.	Title
2-4	Typical
5	Quantity Sheet Items
6	Quantity Sheet, Items & Drainage
7-8	Earthwork Sheets
9	Right of Way Detail Sheet
10-15	Plan and Profile Sheets
16-21	Utilities
22	Blank
23-67	Bridge 100 Series (Sheets 100-199)
68	SC8-01-65 Bridge Markers
69	SC8-02-65 Beam Haunch & Shear Connector Details
70	SC8-04-65 Curb Detail-White Sulphide Detail-Const. & Expansion Joint Detail-Copper support detail
71-72	53-01-64 (Sheets 1 & 2) Aluminum Bridge Railing
73	Blank
74	B-1 Banking Tables
75	B-5 Typical Slope Grading
76	Blank
77	C-1 Bituminous Concrete Sidewalk
78	C-1a Cures
79	C-2a Concrete Sidewalk
80	D-2 Underdrain
81	D-3 Jute Matting
82	D-4 Underdrain Flushing Basins & Covers
83	D-5 Reinf. Conc. Drop Inlet
84	D-9 Drop Inlet Top
85	D-10 Drop Inlet Top
86	D-11 Grates
87	D-16 Prec. Reinf. Conc. Curb Drop Inlet
88	E-1 Barricades, Signs, and Lights
89	E-31 Federal Aid Construction Identification Signs
90	G-1 Steel Beam Guard Rail
91	G-3 Three Coale Guard Rail
92	G-2a Deep End Anchorage
93	G-4 Marker Posts
94	J-1 Boundary Markers
95	Blank
96-116	Cross Sections

STATE OF VERMONT
DEPARTMENT OF HIGHWAYS

PROPOSED IMPROVEMENT

FEDERAL AID PROJECT

TOWN OF HARTFORD

COUNTY OF WINDSOR

U.S. ROUTE 5



WINDSOR-NORWICH ROAD

BEGINNING AT A POINT 3.908 MILES NORTH OF THE HARTLAND-HARTFORD TOWN LINE AND EXTENDING NORTHEASTERLY 0.185 MI.

LENGTH OF BRIDGE 978.86 FT = 0.185 MI.


LENGTH OF PROJECT 978.86 FT = 0.185 MI.

ADT 1966	4270
ADT 1986	8150
DHV 1986	11800
D	0
T	8%
V	40 MPH

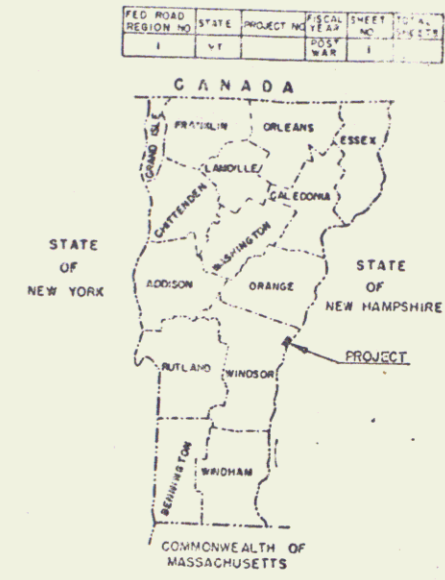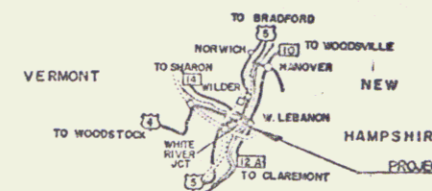

FOR RIGHT OF WAY DETAILS, SEE RIGHT OF WAY PLANS FOR THIS PROJECT.

PROJECT	HARTFORD
SECTION	ER 15(1)
LENGTH	0.185 MI.
TYPE CONTINUOUS WELDED PLATE GIRDER	
CONTRACTOR	CURRAN & LAVOIS, INC.
YEAR	1968
LOCATION BEGINNING AT A POINT 3.908 MILES NORTH OF THE HARTLAND-HARTFORD TOWN LINE AND EXTENDING NORTHEASTERLY 0.185 MI.	

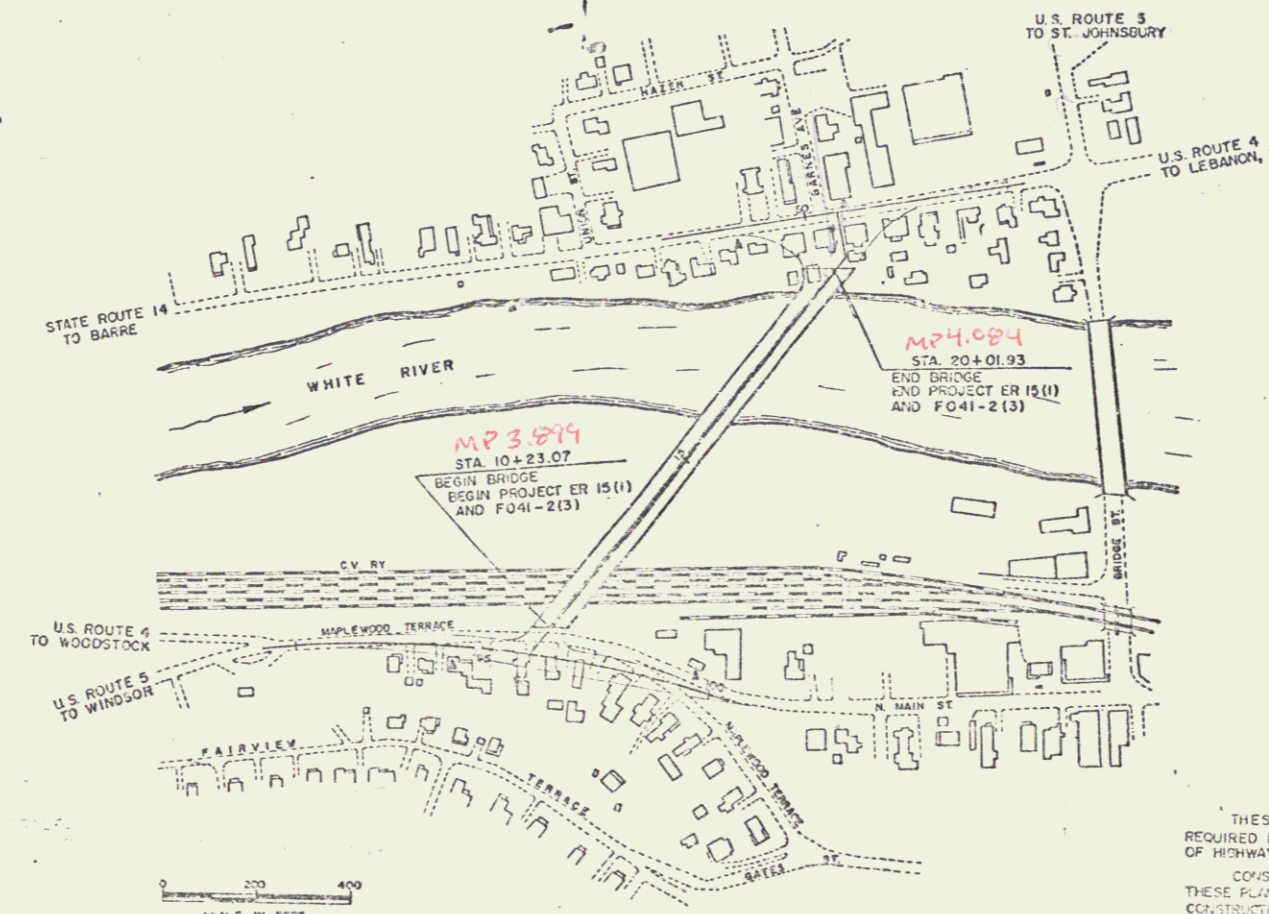

HARTFORD ER 15(1)


AA&B-Miller Ready Mix
Bethlehem Steel Corp.

Bancroft & Martin

Curran-Lavois, Inc.
A. Louis & A. Davis
R. L. Weichert

Oct. 13, 1966
Nov. 22, 1966
Mar. 11, 1968
Mar. 11, 1969

Roadway approaches, North & South ends of bridge deleted from Hartford F 041-2(3), to be included in Hartford F 041-2(5) (South) and Hartford F 041-3(1) (North)

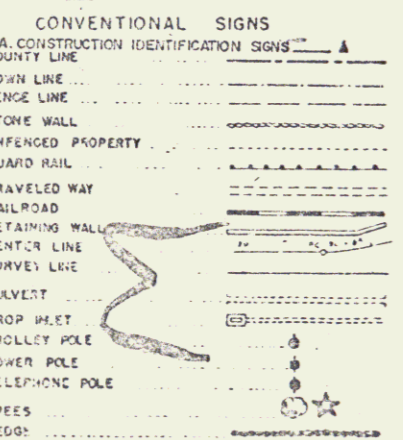

SLOPE RIGHTS	GROUND ELEVATION	GRADE ELEVATION	CURVE DATA
SR	DATE	DATE	DEFLECTION OF ANGLE
SR	DATE	DATE	DEGREE OF CURVE
			RADIUS OF CURVE
			TANGENT DISTANCE
			LENGTH OF CURVE
			EXTERNAL DISTANCE
			POINT OF INTERSECTION
			POINT OF CURVE
			POINT OF TANGENT
			POINT ON TANGENT
			POINT ON SUB-TANGENT

APPROVED DATE 1/10/68	APPROVED DATE 1/4/68	APPROVED DATE 1/2/68	APPROVED DATE 1/10/68	APPROVED DATE 1/10/68	APPROVED DATE 1/10/68
--------------------------	-------------------------	-------------------------	--------------------------	--------------------------	--------------------------

THESE PLANS ARE SUBJECT TO SUCH REVISIONS AS MAY BE REQUIRED BY THE BUREAU OF PUBLIC ROADS OR THE COMMISSIONER OF HIGHWAYS.

CONSTRUCTION IS TO BE CARRIED ON IN ACCORDANCE WITH THESE PLANS AND THE STANDARD SPECIFICATIONS FOR HIGHWAY AND BRIDGE CONSTRUCTION DATED APRIL 1954, AS APPROVED BY THE BUREAU OF PUBLIC ROADS ON OCTOBER 12, 1954, INCLUDING ALL SUBSEQUENT APPROVED REVISIONS AND SUCH REVISED SPECIFICATIONS AND SPECIAL PROVISIONS AS ARE INCORPORATED IN THESE PLANS.

Pin # 992911

DEPARTMENT OF TRANSPORTATION
BUREAU OF PUBLIC ROADS

APPROVED
DATE 1/10/68

PROJECT ER 15(1)
MO 041-2(3)

SHEET 1 OF 116 SHEETS