


REMOVAL OF EXISTING RETAINING WALL, ITEM 103-B
98 + 90 Lt - 100 + 35 Rt

CONSTRUCT DRIVES
98 + 48 Rt

DEMOLITION & DISPOSAL OF BUILDING
ITEM 506
98 + 50 Lt - 98 + 50 Lt

CUTTING & REMOVING TREES
ITEM 102
99 + 49 Rt
99 + 70 Rt
99 + 75 Rt
99 + 98 Rt

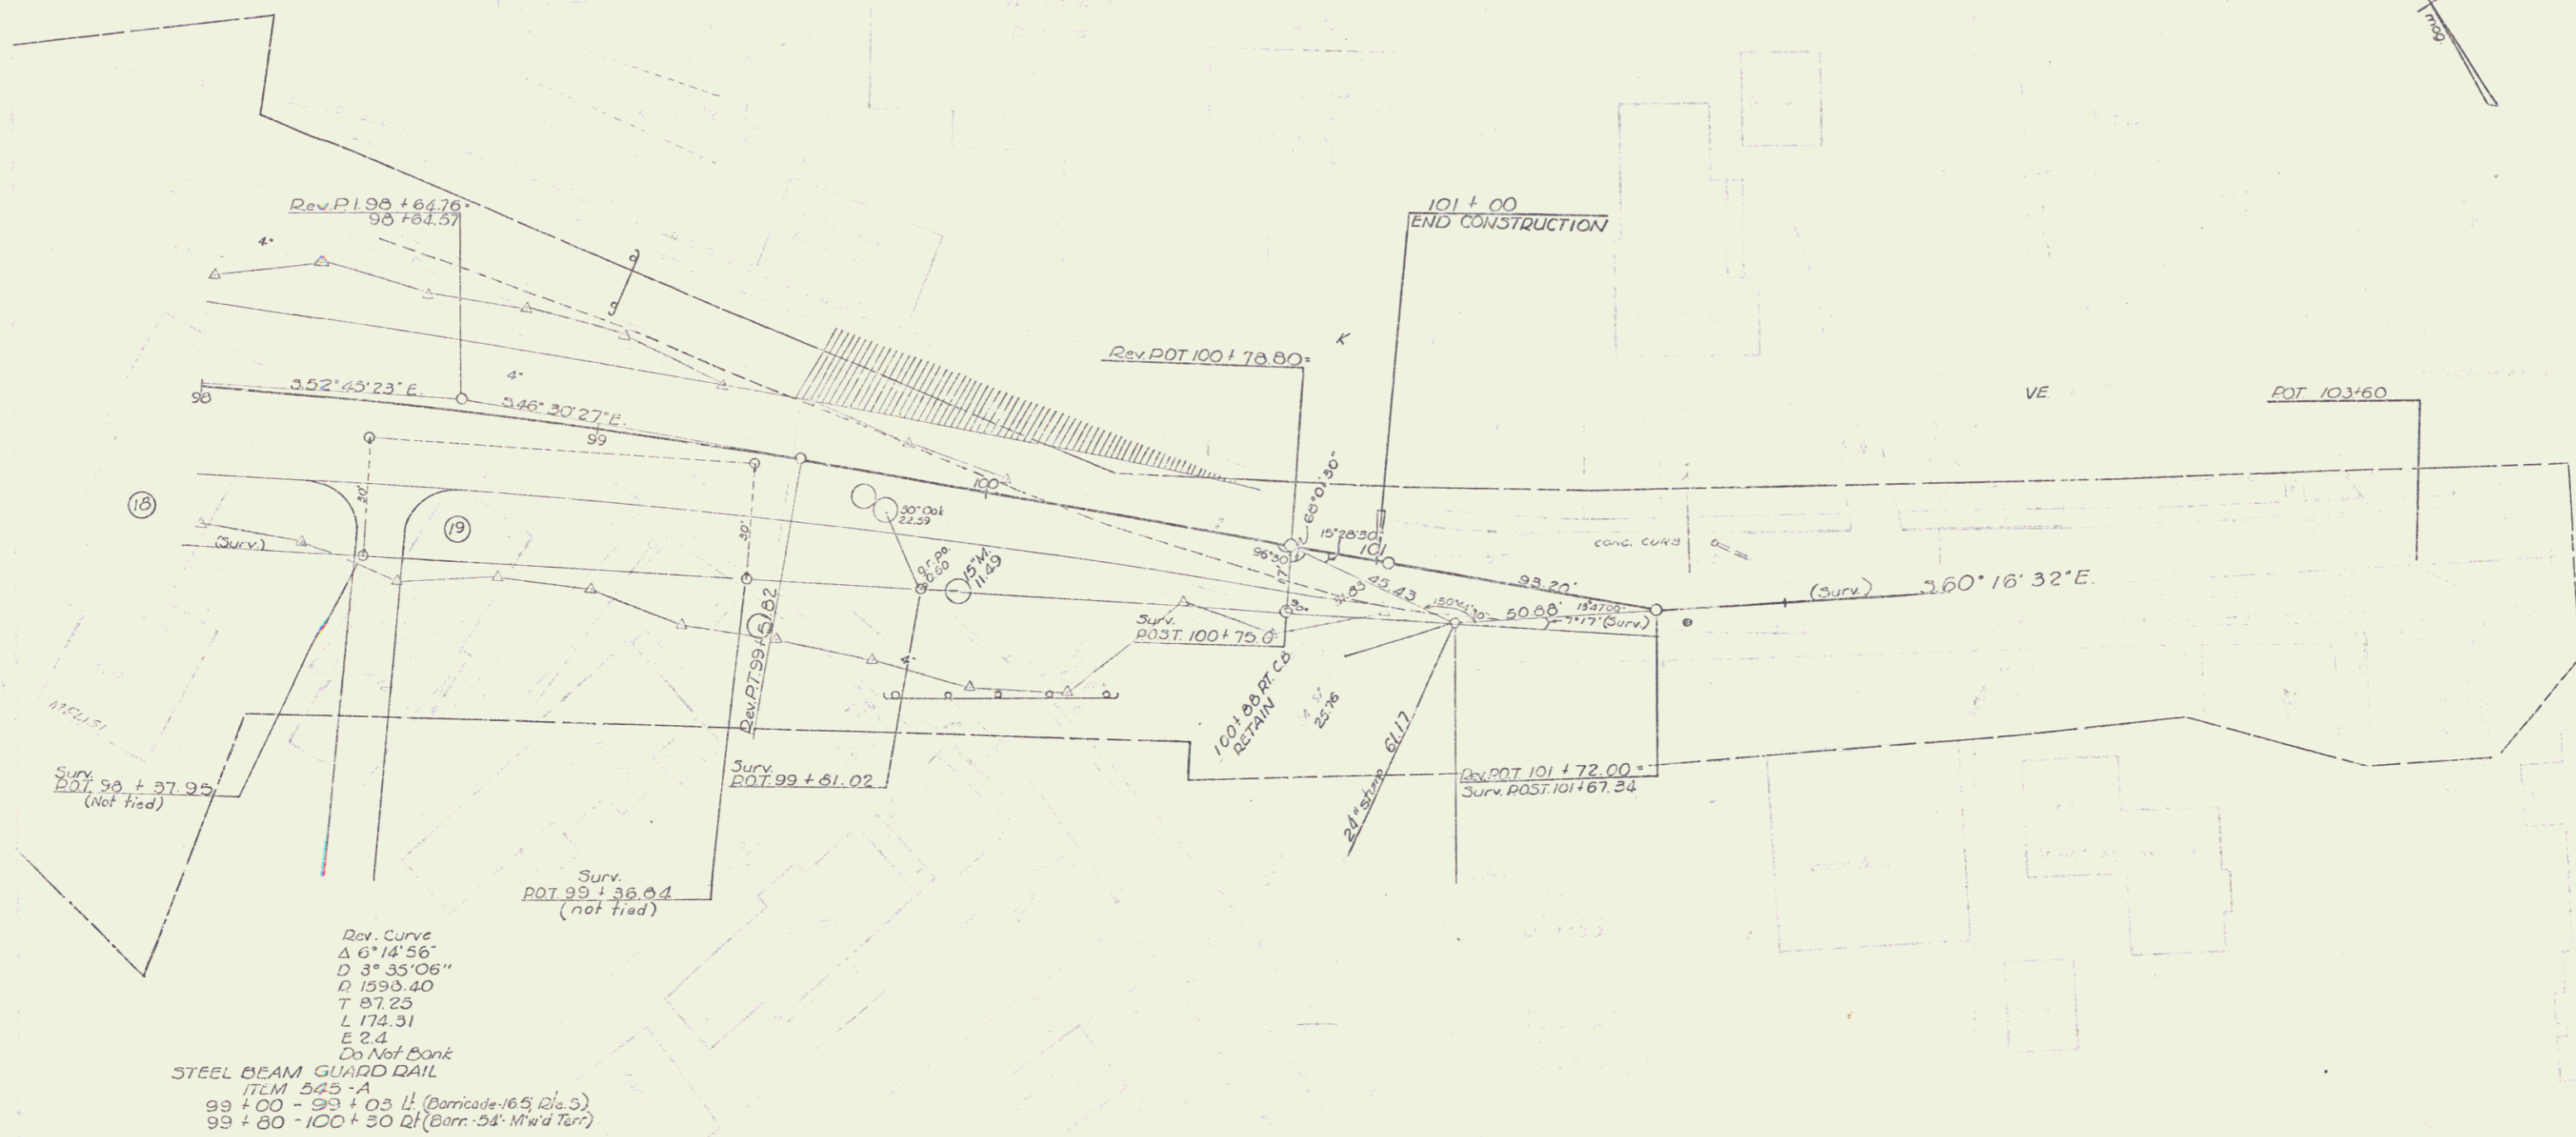

Rev. Curve
Δ 67° 14' 56"
D 3° 35' 06"
D 1590.40
T 87.25
L 174.31
E 2.4
Do Not Bank
STEEL BEAM GUARD RAIL
ITEM 545-A
99 + 00 - 99 + 03 Lt (Barricade-16.5 (2) a.5)
99 + 80 - 100 + 30 Rt (Barr-54' M'w'd Terr)

BITUMINOUS CONC. SURFACE FOR
GUTTERS & TRAFFIC ISLANDS, ITEM 554, MOD.
98 + 00 - 100 + 30 RT.

DEMOLITION & DISPOSAL OF BUILDING
ITEM 506
98 + 50 Lt - 98 + 50 Lt

PLAN SCALE
0 20 40
FEET

BRIDGE APPROACH (SOUTH)

F 15
E 11E 15 (1)
3

96 5