


PLAN

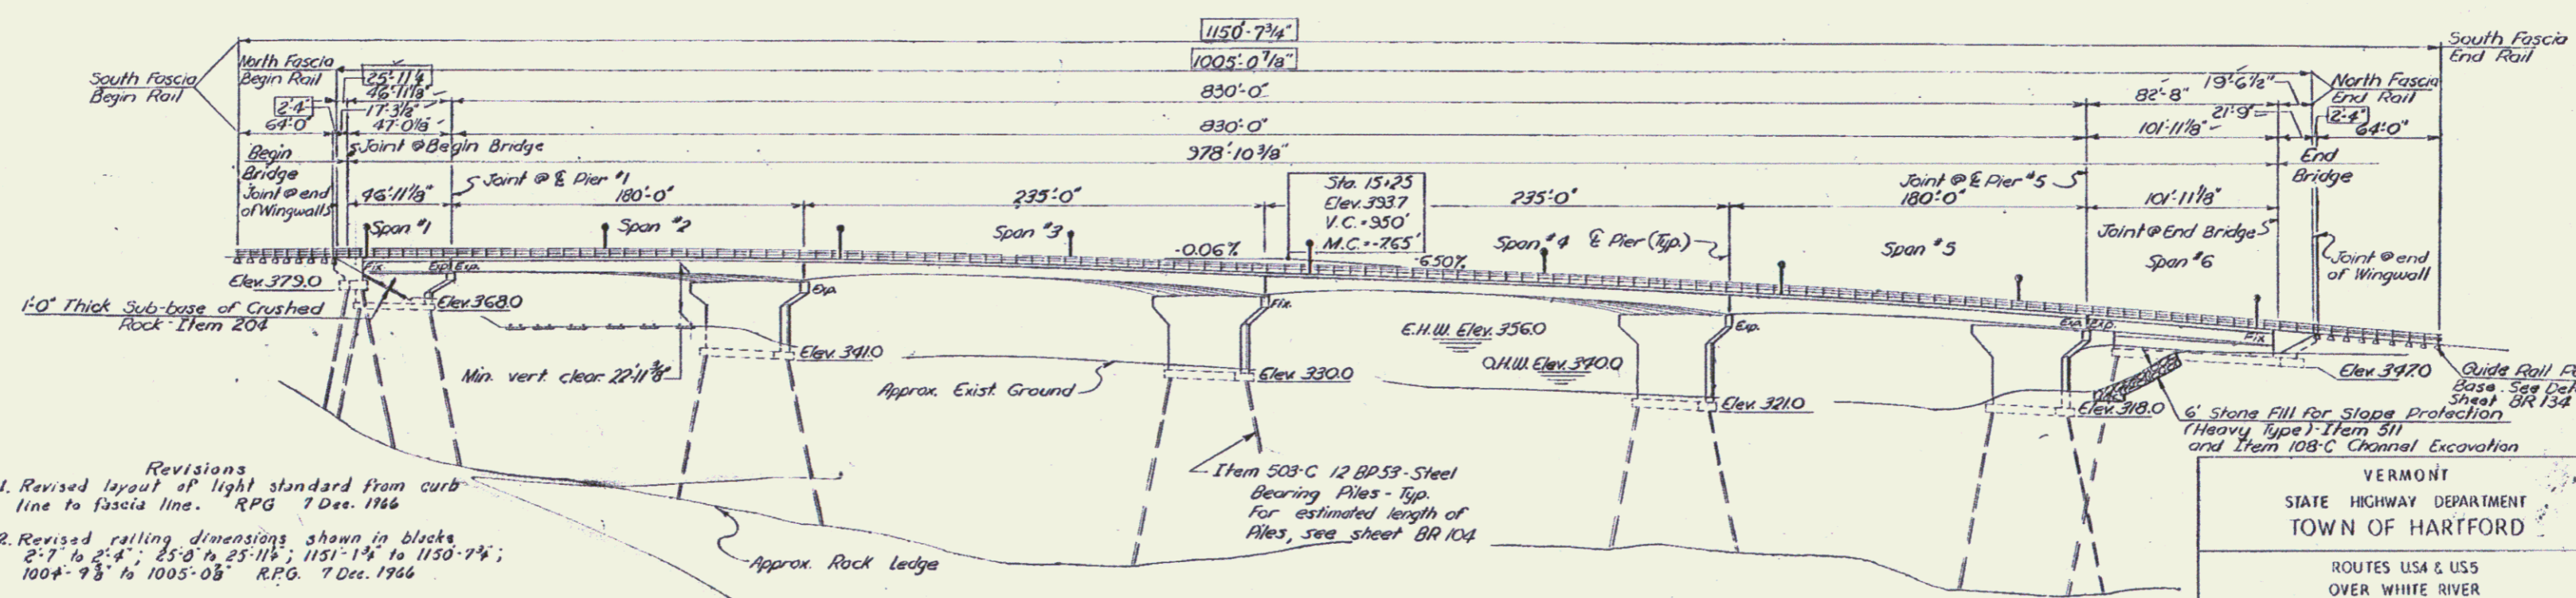

ELEVATION

- Revisions
 1. Revised layout of light standard from curb line to fascia line. RPG. 7 Dec. 1966
 2. Revised railing dimensions shown in black: 2'-7" to 2'-4"; 25'-0" to 25'-11 1/8"; 1151'-1 1/8" to 1150'-7 1/4"; 1004'-9 3/8" to 1005'-0 3/8". RPG. 7 Dec. 1966

VERMONT STATE HIGHWAY DEPARTMENT TOWN OF HARTFORD	
ROUTES USA & US5 OVER WHITE RIVER PLAN & ELEVATION	
M ^c FARLAND - JOHNSON CONSULTING ENGINEERS BINGHAMTON NEW YORK	
DESIGNED: W.Z.D.	CHECKED: H.C.C.
DRAWN: G.C.H.	IN CHARGE: H.C.C.
DATE: 6-27-66	SCALE: 1"=40'-0"
PROJECT NO. ER # 15 SH 230/116	