
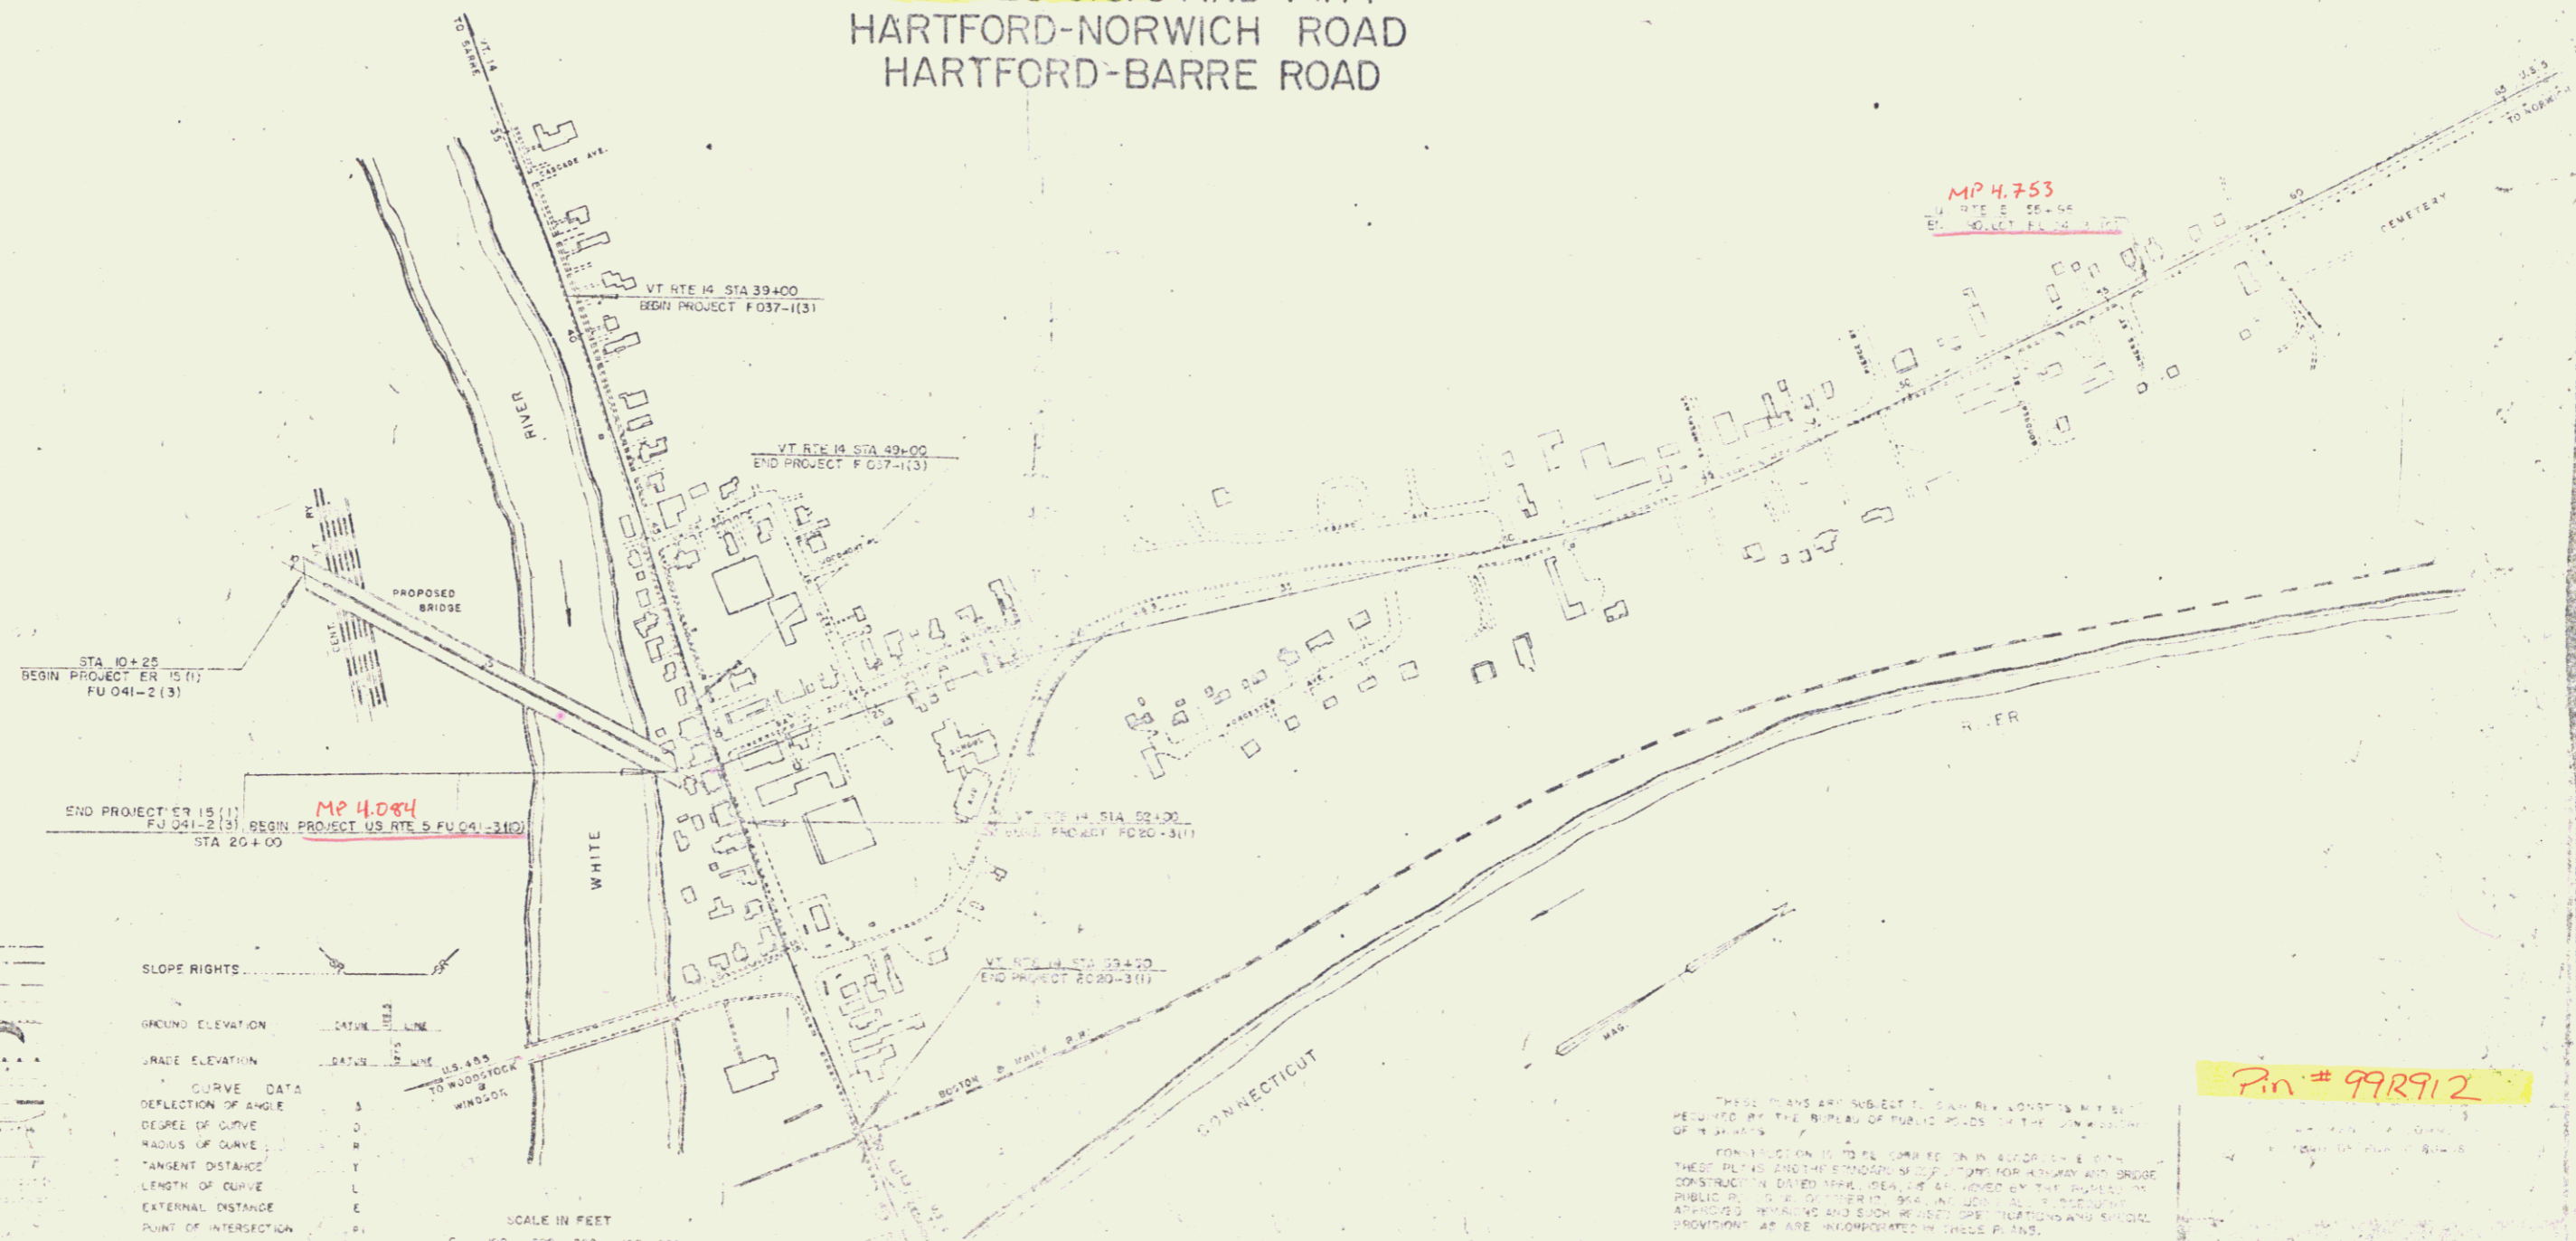


STATE OF VERMONT
DEPARTMENT OF HIGHWAYS
PROPOSED IMPROVEMENT

URBAN PROJECT
TOWN OF HARTFORD
COUNTY OF WINDSOR
ROUTES U.S. 5 AND VT. 14
HARTFORD-NORWICH ROAD
HARTFORD-BARRE ROAD

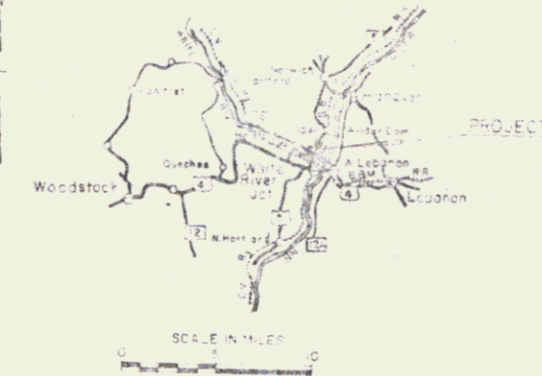

CONVENTIONAL SIGNS

R.O.W.	---
COUNTY LINE	---
TOWN LINE	---
FENCE LINE	---
STONE WALL	---
UNFENCED PROPERTY	---
GUARD RAIL	---
TRAVELED WAY	---
RAILROAD	---
RETAINING WALL	---
CENTER LINE	---
SURVEY LINE	---
CULVERT	---
DROP INLET	---
TROLLEY POLE	---
POWER POLE	---
TELEPHONE POLE	---
TREES	---
MEDIA	---
CONSTRUCTION IDENTIFICATION SIGN	---

SLOPE RIGHTS

GRADE ELEVATION	---
CURVE DATA	---
DEFLECTION OF ANGLE	S
DEGREE OF CURVE	D
RADIUS OF CURVE	R
TANGENT DISTANCE	T
LENGTH OF CURVE	L
EXTERNAL DISTANCE	E
POINT OF INTERSECTION	P.I.
POINT OF CURVE	P.C.
POINT OF TANGENT	P.T.
POINT ON TANGENT	P.O.T.
POINT ON SUB-TANGENT	P.O.S.T.

SCALE IN FEET
0 50 100 150 200

THESE PLANS ARE SUBJECT TO CHANGE WITHOUT NOTICE AND WITHOUT LIABILITY TO THE BUREAU OF PUBLIC ROADS IN THE EVENT OF A CHANGE IN THE REQUIREMENTS OF THE BUREAU OF PUBLIC ROADS.
 THESE PLANS AND THE PROPOSED IMPROVEMENTS THEREON ARE FOR THE USE OF THE BUREAU OF PUBLIC ROADS AND ARE NOT TO BE USED FOR ANY OTHER PURPOSE WITHOUT THE WRITTEN CONSENT OF THE BUREAU OF PUBLIC ROADS.
 THE BUREAU OF PUBLIC ROADS IS NOT RESPONSIBLE FOR THE DESIGN OR CONSTRUCTION OF ANY STRUCTURES OR IMPROVEMENTS WHICH ARE NOT SHOWN ON THESE PLANS.

Pin # 998912

APPROVED	DATE	APPROVED	DATE	APPROVED	DATE	APPROVED	DATE

DATE: 1/4/66

FU 041-3(10)