


VERMONT DEPARTMENT OF HIGHWAYS  
 RIGHT-OF-WAY PLANS  
 PROJECT: HARTFORD  
 No. EU 041-3(10) & FU 041-2(3)  
 SHEET 47 OF 70

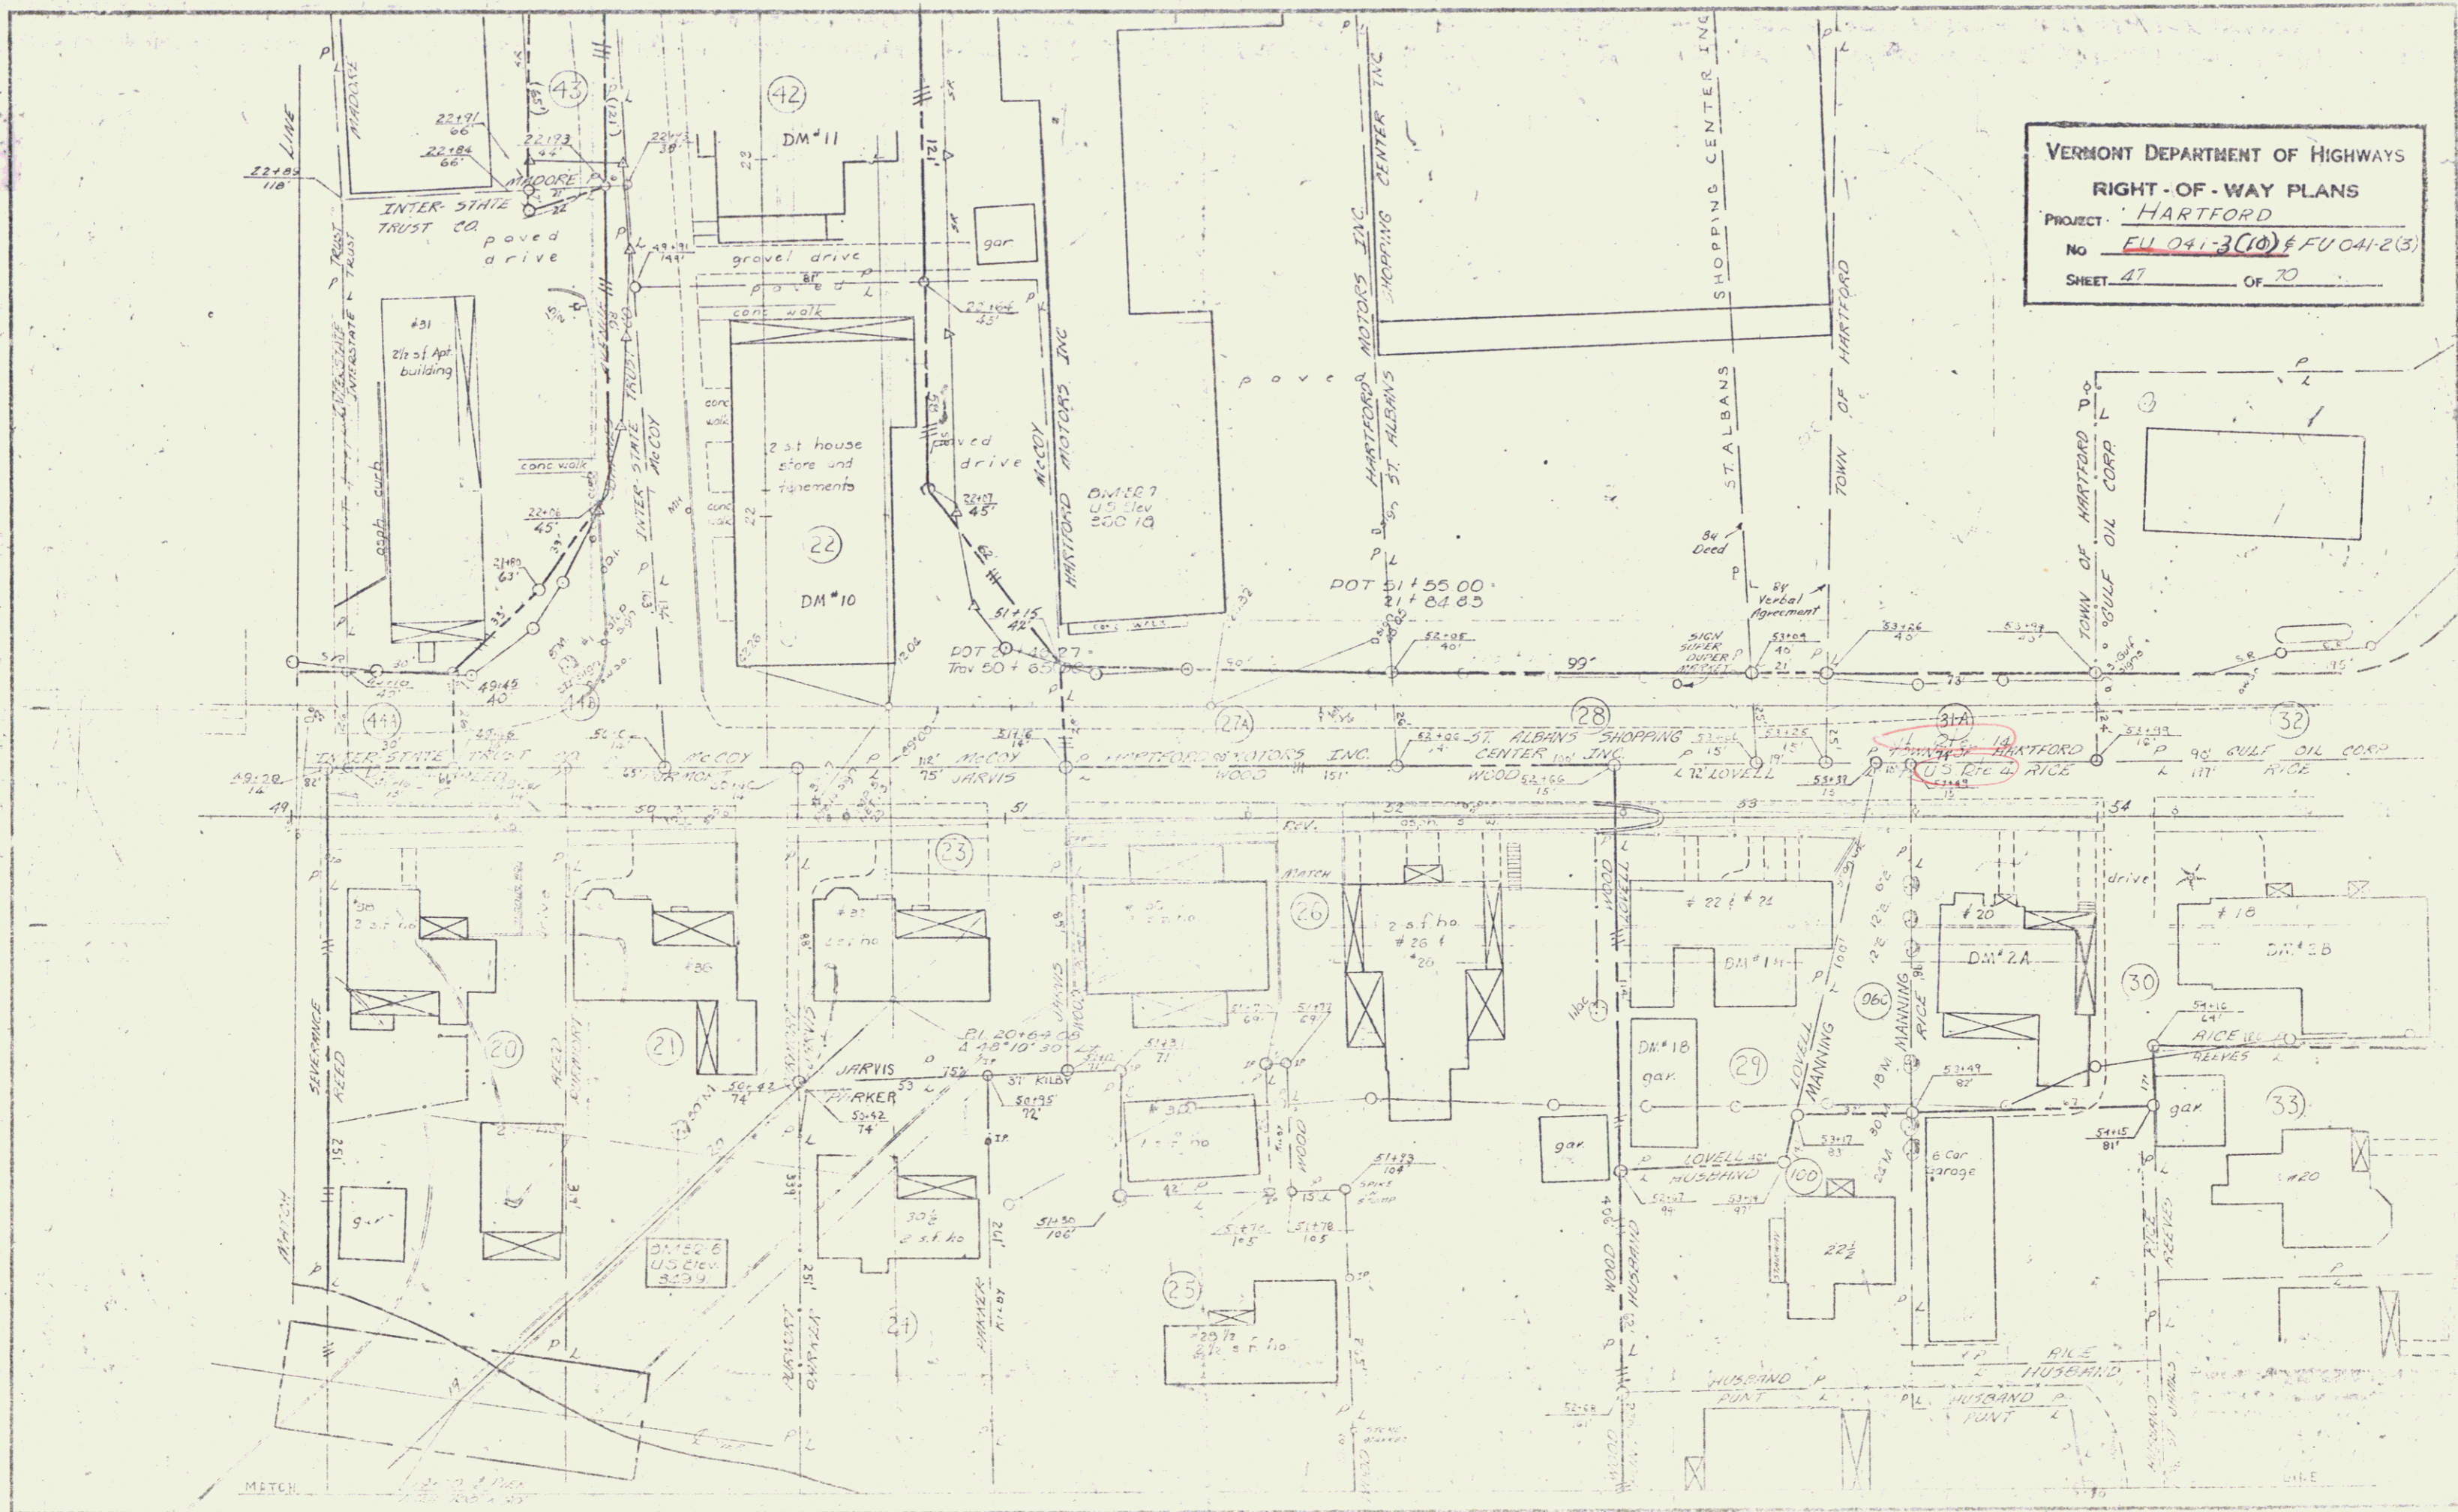

47  
 10 2