


VERMONT DEPARTMENT OF HIGHWAYS
 RIGHT-OF-WAY PLANS
 PROJECT - HARTFORD
 NO. FU 041-3(10) & F020-3(1)
 SHEET 51 OF 70

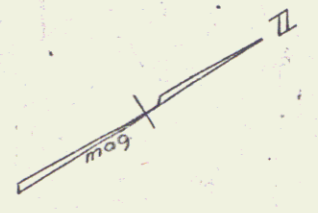

Sheet 1-A
 MATCH
 to sheet 47

51

124