

INDEX OF SHEETS

- 1 TITLE SHEET
- 2 PLAN SECTIONS
- 3 QUANTITY SHEETS, ITEMS
- 4 QUANTITY SHEETS, DRAINAGE
- 5-19 EARTHWORK AND GRADE SHEETS
- 20-24 PLAN SHEETS
- 25-28 PROFILES
- 29 PLAN AND ELEVATION OF BRIDGE OVER WHITE RIVER
- 30 END CONTOUR PLAN
- 31 DETAILS FOR BRIDGE AND CONCRETE BASE DETAILS
- 32-34 UTILITY SHEETS
- 35-38 UTILITIES F020-3(1)
- 39-41 UTILITIES F041-3(1)
- 42-44 UTILITIES F037-1(3)
- 45-48 UTILITIES F041-3(1)
- 49-52 UTILITIES F041-3(1)
- 53-54 UTILITIES F020-3(1)
- 55-58 BLANK-59 B-I METHOD OF SLOPE STABILIZATION 3-10-65 F037-1(3)
- 60-61 LOCATION OF UNDERGROUND SYSTEM FOR STREET LIGHTING F041-3(1)
- 62-64 LOCATION OF UNDERGROUND SYSTEM FOR STREET LIGHTING F041-3(1)
- 65-67 LOCATION OF UNDERGROUND SYSTEM FOR STREET LIGHTING F020-3(1)
- 68 TRAFFIC CONTROL SIGNALS F041-3(1)
- 69-70 TRAFFIC CONTROL SIGNALS F020-3(1)
- 71-72 TRAFFIC SIGNS F037-1(3)
- 73-76 TRAFFIC SIGNS F041-3(1)
- 77-80 TRAFFIC SIGNS F020-3(1)
- 81-82 ISLANDS 7-21-67 R
- 83 B-I ISLANDS 7-21-67 R
- 84 DETAILS FOR YIELDING TYPE SIGN POSTS
- 85 CONSTRUCTION AND ASSEMBLY DETAILS FOR PLYWOOD SIGNS
- 86-89 OVERHEAD TRAFFIC SIGN SUPPORTS F041-3(1)
- 90-91 OVERHEAD TRAFFIC SIGN SUPPORTS F020-3(1)
- 92-93 5/8" X 4" ALUMINUM BRIDGE ROLING 1-31-68 B II-R-66 R
- 94 B-I BANKING TABLES 1-17-67 R
- 95 C-1 CURBS 3-10-65
- 96 C-2 CURBS 3-10-65
- 97 C-3 CURBS 3-10-65
- 98 D-2 UNDERDRAIN 7-28-67 R
- 99 D-3 UNDERDRAIN 7-28-67 R
- 100 D-4 UNDERDRAIN FLUSHING BASIN 8-1-66 R
- 101 D-5 DROP INLET WITH GRATE IN DITCHES 12-23-66
- 102 D-6 DROP INLET 3-10-65
- 103 D-7 DROP INLET 3-10-65
- 104 D-8 GRATE TYPE A 3-10-65
- 105 D-9 GRATE TYPE B 3-10-65
- 106 D-10 GRATE TYPE C 3-10-65
- 107 VERTICAL SIGN 1-17-66 R
- 108 E-I INTERSTATE ROUTE AND AUXILIARY MARKERS 8-28-64 R
- 109 U.S. SITE AND AUX. MARKERS 8-28-64 R
- 110 E-I STATE RTE. AND AUX. MARKERS 8-28-64 R
- 111 E-I REGULATORY SIGNS 8-15-63 R
- 112 E-I REGULATORY SIGNS 8-15-63 R
- 113 E-I REGULATORY SIGNS 8-15-63 R
- 114 C-2 REINFORCED CONCRETE CURB 3-10-65
- 115 E-I SIGN POSTS 1-17-66 R
- 116 E-I STANDARD SIGN PLACEMENT 1-17-66 R
- 117 E-I FEDERAL AID CONSTRUCTION IDENTIFICATION SIGNS 8-21-67 R
- 118 E-I FEDERAL AID CONSTRUCTION IDENTIFICATION SIGNS 8-21-67 R
STATE OF VERMONT
DEPARTMENT OF HIGHWAYS
PROPOSED IMPROVEMENT

FEDERAL PROJECTS

TOWN OF HARTFORD
COUNTY OF WINDSOR

VERMONT ROUTE 14
LEBANON, N.H. - BARRE, VT. ROAD
PROJECT F037-1(3)
BEGINNING AT A POINT 0.452 MILE WESTERLY OF THE
HARTFORD, VT. - LEBANON, N.H. TOWN LINE AND EXTEND-
ING EASTERLY 0.189 MILE.
LENGTH OF PROJECT 1,000 FT. = 0.189 MILE

U.S. ROUTE 5
HARTFORD-NORWICH ROAD
PROJECT F041-3(1)
BEGINNING AT A POINT 3.513 MILES SOUTH OF THE
HARTFORD-NORWICH TOWN LINE AND EXTENDING
NORTHERLY 0.215 MILE.
LENGTH OF PROJECT 1,133.60 FT. = 0.215 MILE

U.S. ROUTE 4
BARRE, VT. - LEBANON, N.H. ROAD
PROJECT F020-3(1)
BEGINNING AT A POINT 0.206 MILE WESTERLY OF THE
HARTFORD, VT. - LEBANON, N.H. TOWN LINE AND EXTEND-
ING EASTERLY 0.141 MILE.
LENGTH OF PROJECT 743.00 FT. = 0.141 MILE

ADT 1967	3200
ADT 1986	4480
DHV 1986	-630
D	58 %
T	7 %
V	40 M.P.H.



ADT 1967	5000
ADT 1986	8660
DHV 1986	1190
D	60 %
T	6 %
V	40 M.P.H.

ADT 1967	6000
ADT 1986	8660
DHV 1986	1200
D	53 %
T	6 %
V	40 M.P.H.


TOTAL LENGTH OF CONTRACT 2,876.60 FT. = 0.545 MI.

PROJECT NAME & NUMBER TYPE
HARTFORD F020-3(1), R.O.W. DEMOLITION &
F041-3(1) & F037-1(3) REM. OF BLDGS.

RECORD PLANS
CONTRACTOR - ROBERT DAVIS - WOLCOTT, VT.
RESIDENT ENGINEER - RICHARD HAUGER
RECORD PLANS - A.G. SPIDLE
CONTRACT
DATED - OCTOBER 20, 1967
STARTED - OCTOBER 15, 1967
COMPLETED - DEC. 0, 1967
ACCEPTED - DEC. 13, 1967

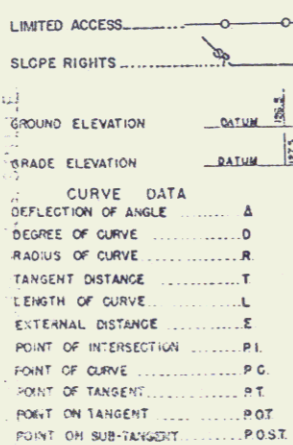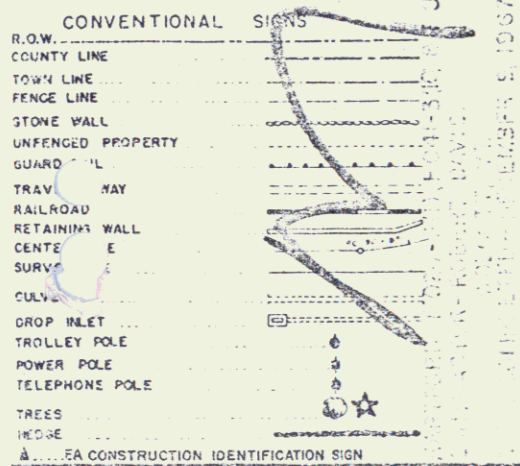

SCALE IN FEET
0 100 200 300 400 500

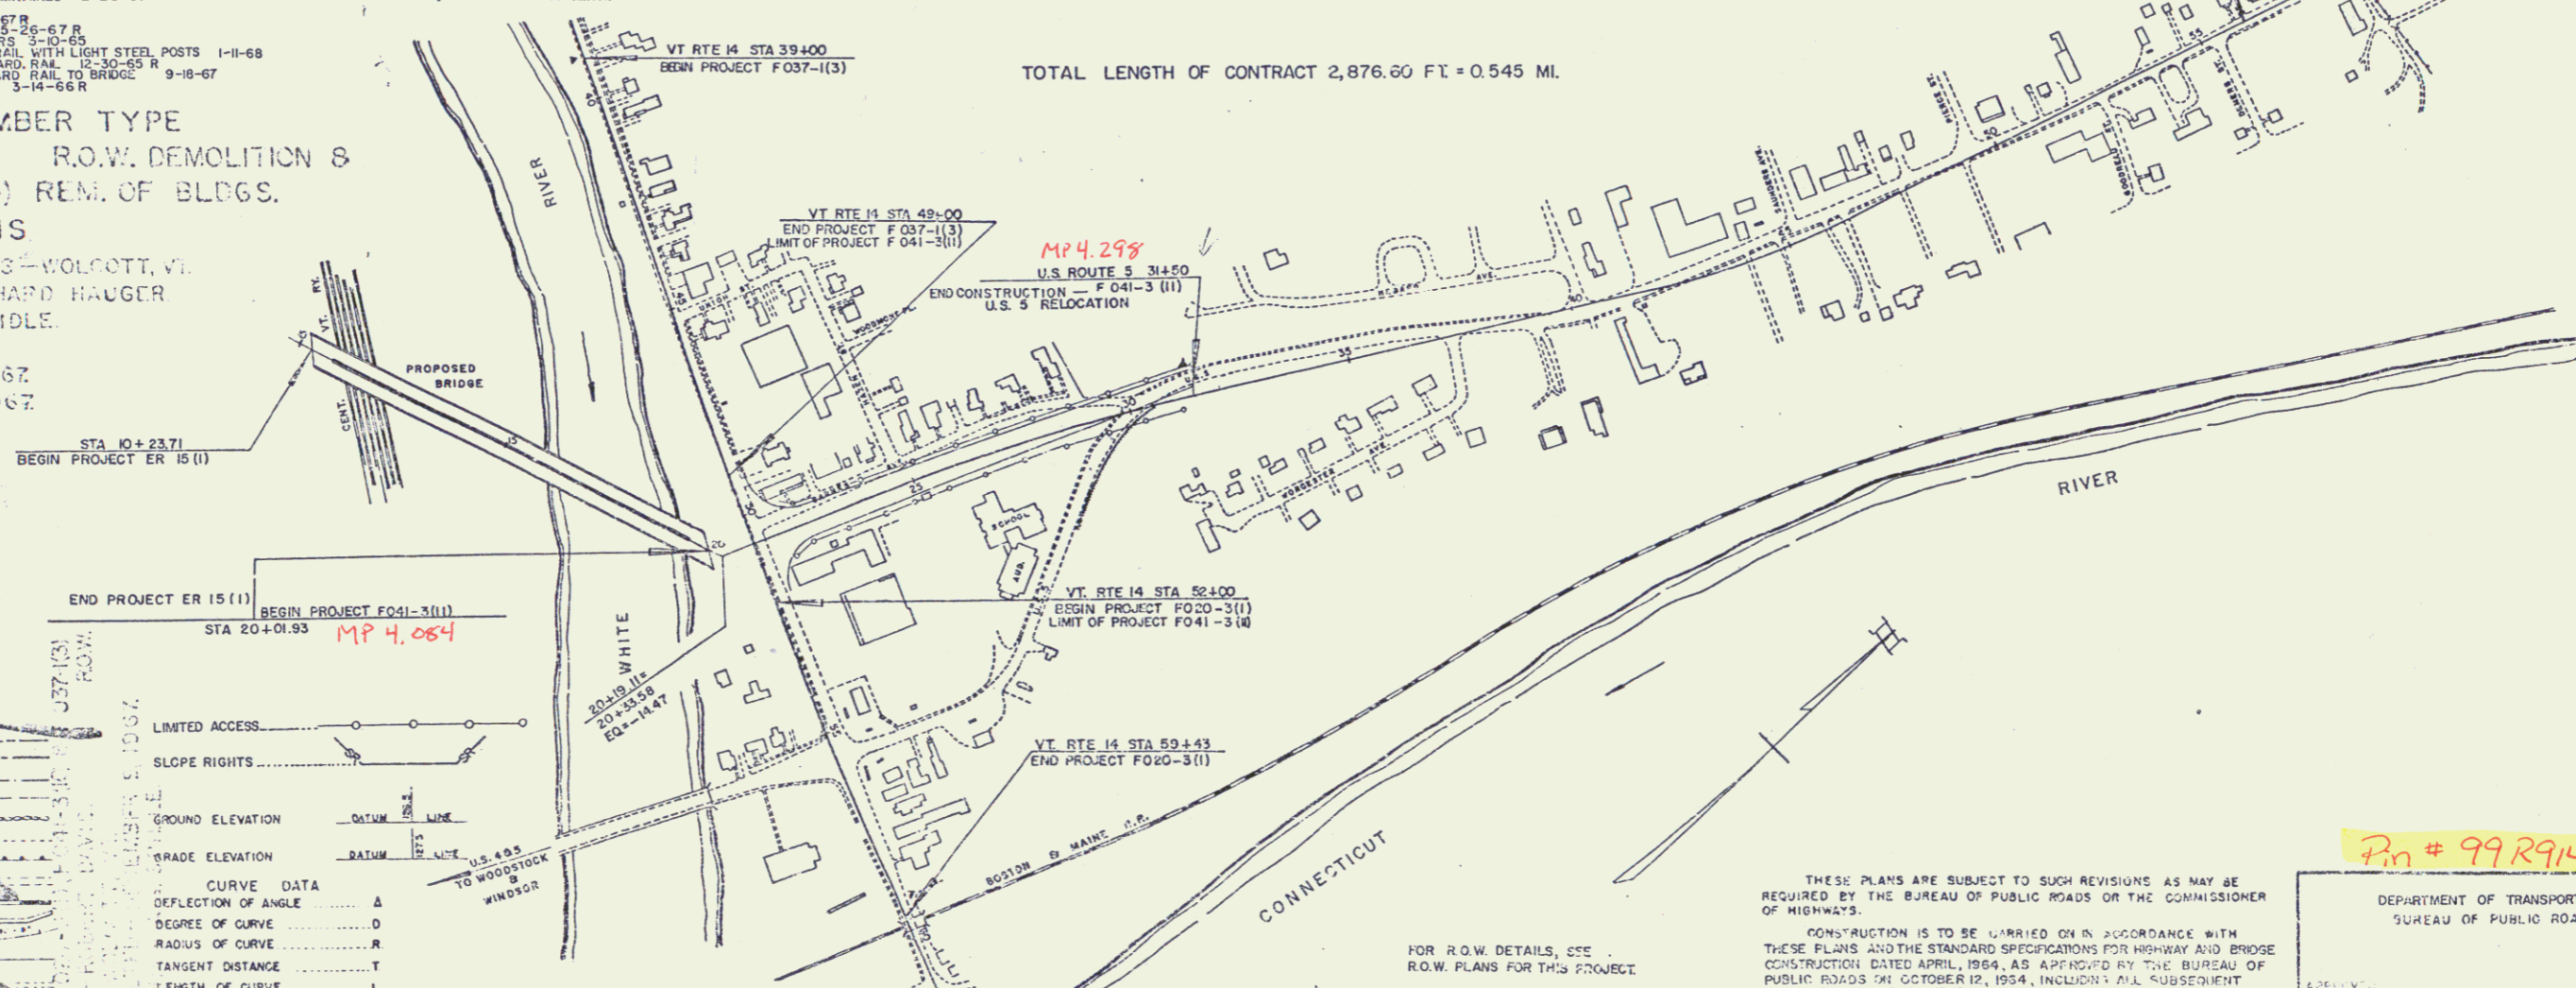

THESE PLANS ARE SUBJECT TO SUCH REVISIONS AS MAY BE
REQUIRED BY THE BUREAU OF PUBLIC ROADS OR THE COMMISSIONER
OF HIGHWAYS.
CONSTRUCTION IS TO BE CARRIED ON IN ACCORDANCE WITH
THESE PLANS AND THE STANDARD SPECIFICATIONS FOR HIGHWAY AND BRIDGE
CONSTRUCTION DATED APRIL, 1964, AS APPROVED BY THE BUREAU OF
PUBLIC ROADS ON OCTOBER 17, 1964, INCLUDING ALL SUBSEQUENT
APPROVED REVISIONS AND SUCH REVISED SPECIFICATIONS AND SPECIAL
PROVISIONS AS ARE INCORPORATED IN THESE PLANS.

Pin # 99R914

DEPARTMENT OF TRANSPORTATION
BUREAU OF PUBLIC ROADS

APPROVED <i>[Signature]</i> DATE 10/27/67	APPROVED <i>[Signature]</i> DATE 11/16/67	APPROVED <i>[Signature]</i> DATE 11/27/67	APPROVED <i>[Signature]</i> DATE 11/27/67	APPROVED <i>[Signature]</i> DATE 11/27/67	APPROVED <i>[Signature]</i> DATE 11/27/67
---	---	---	---	---	---

PROJECT	F 037-1(3)
F 041-3(1)	
F 020-3(1)	
SHEET	1