


PLAN	NO.	DATE
1	1	11/11/82
2	1	11/11/82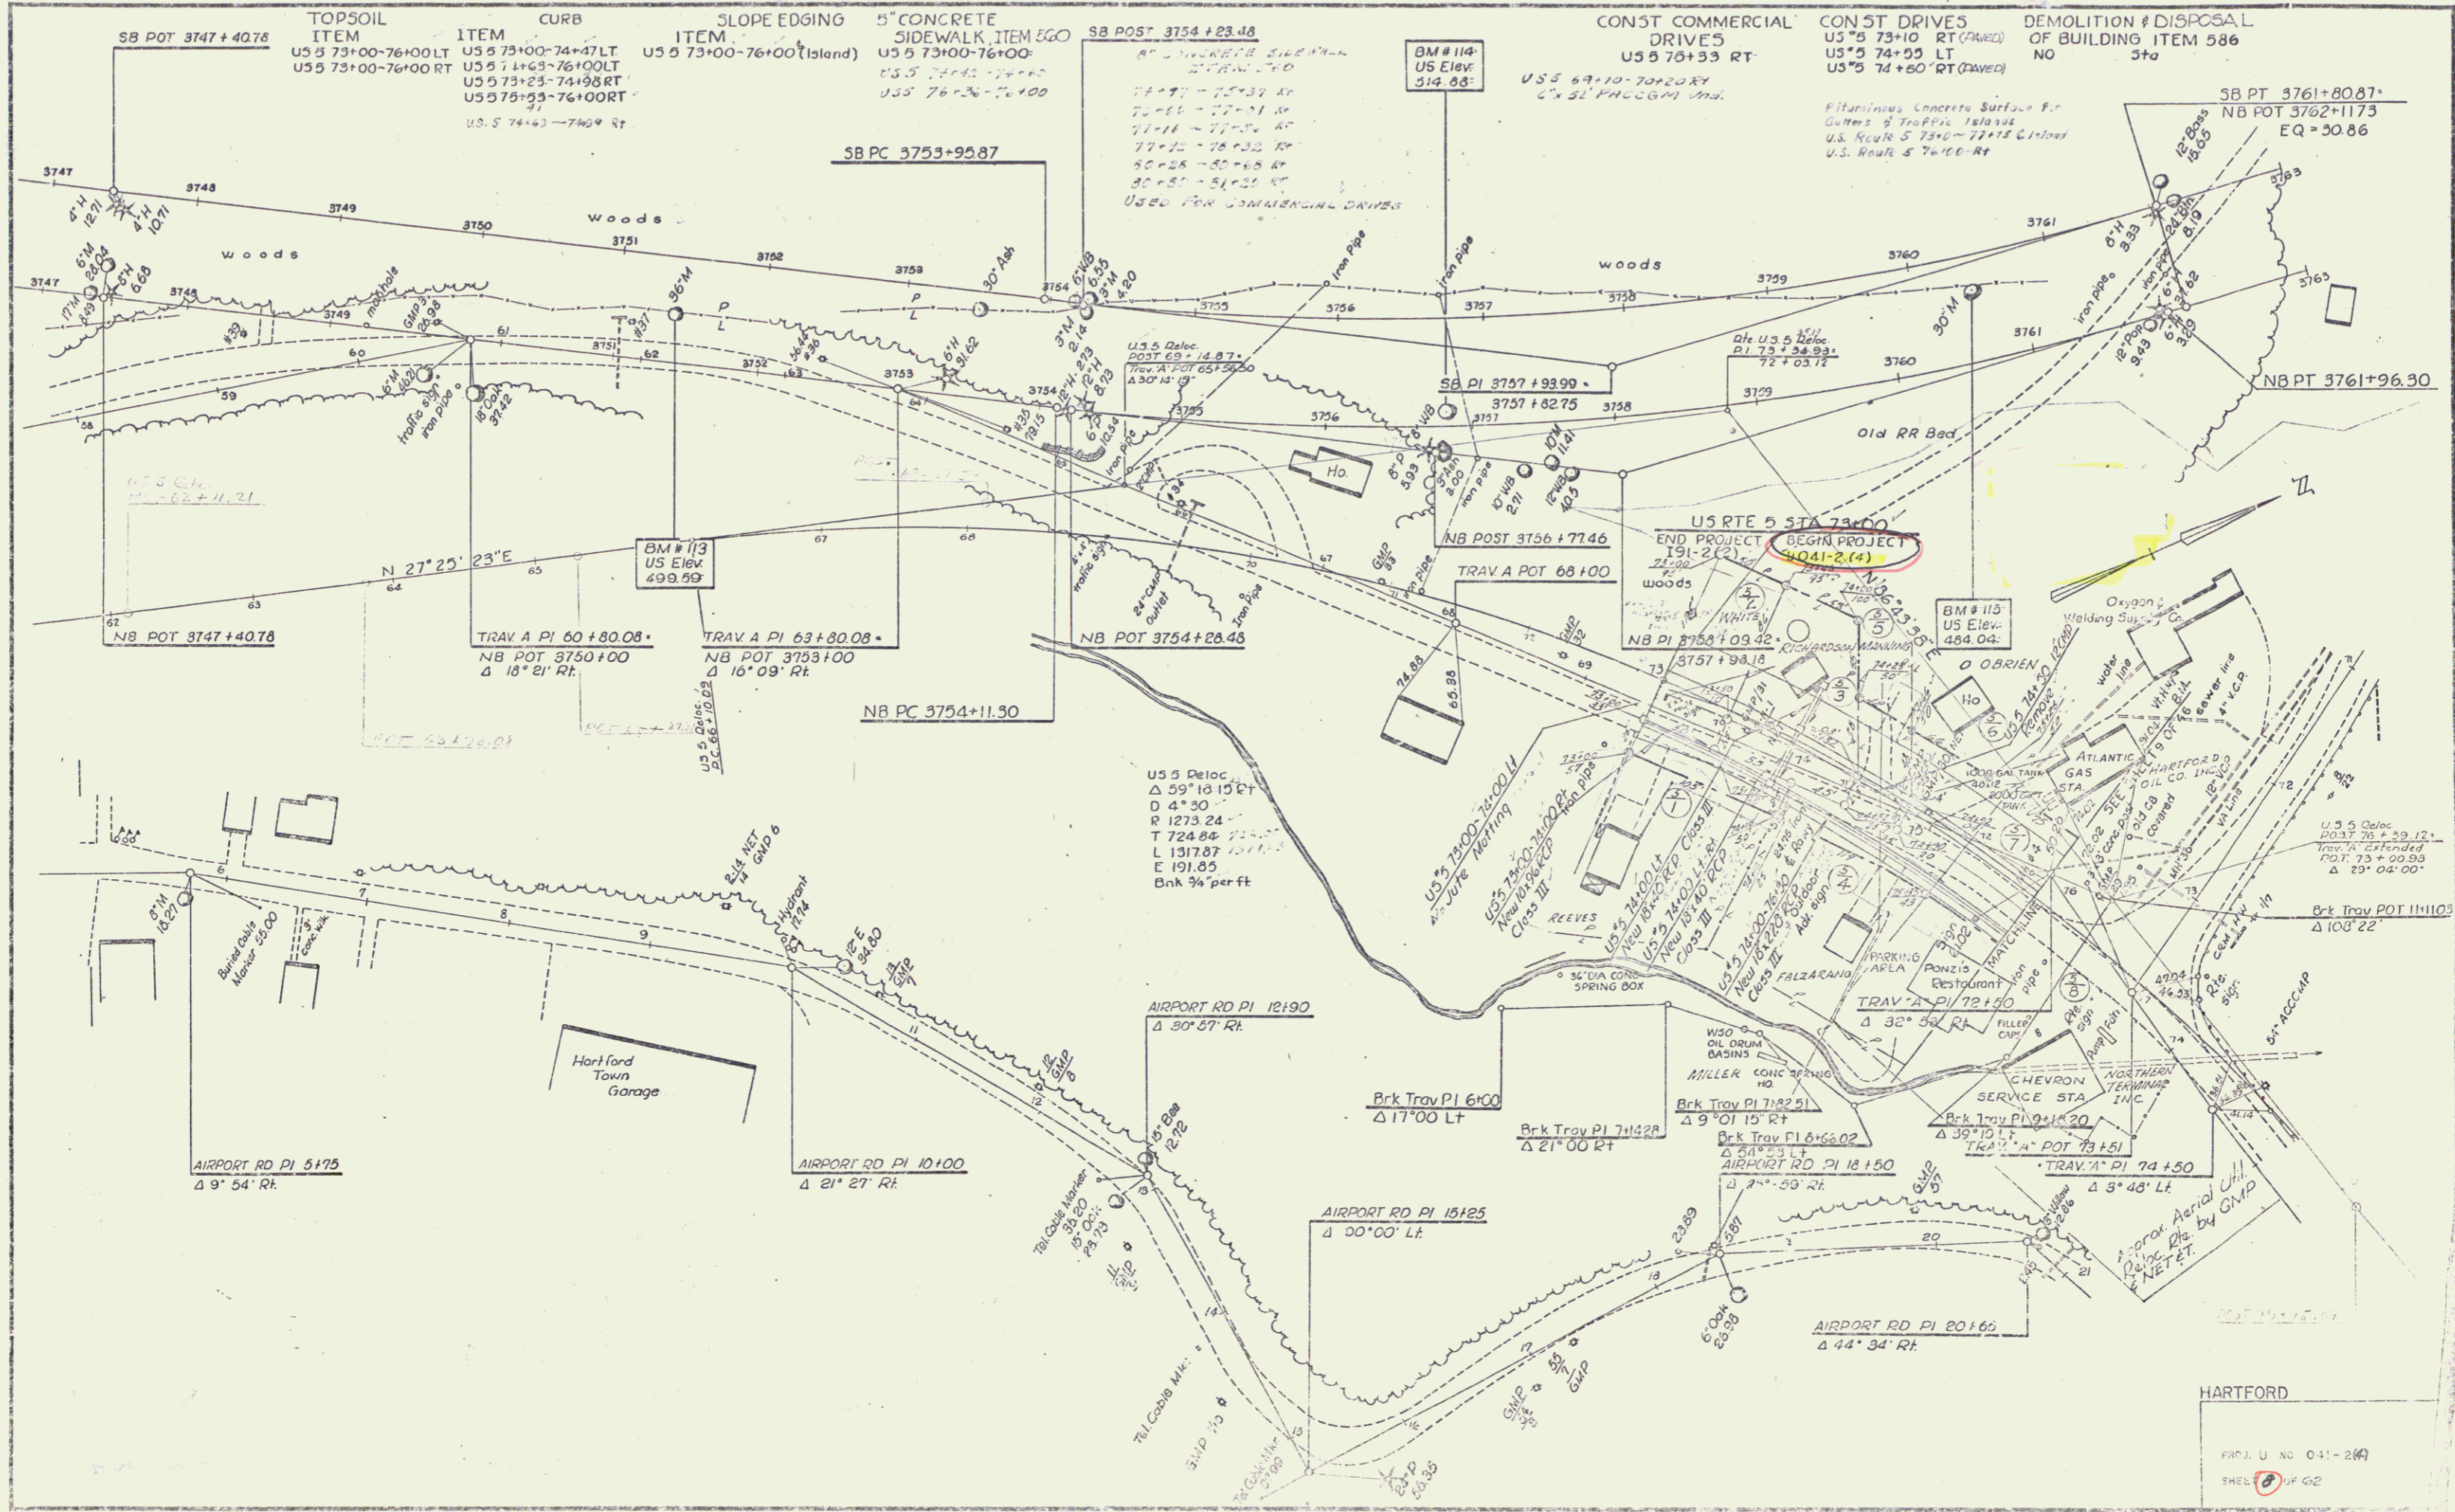
HARTFORD
 PROJ. U. NO. 041-240
 SHEET 6 OF 62