


PLAN	REVISED	DATE
WRITE BOOK	REVISIONS CHECKED	DATE
NO.	BY	DATE

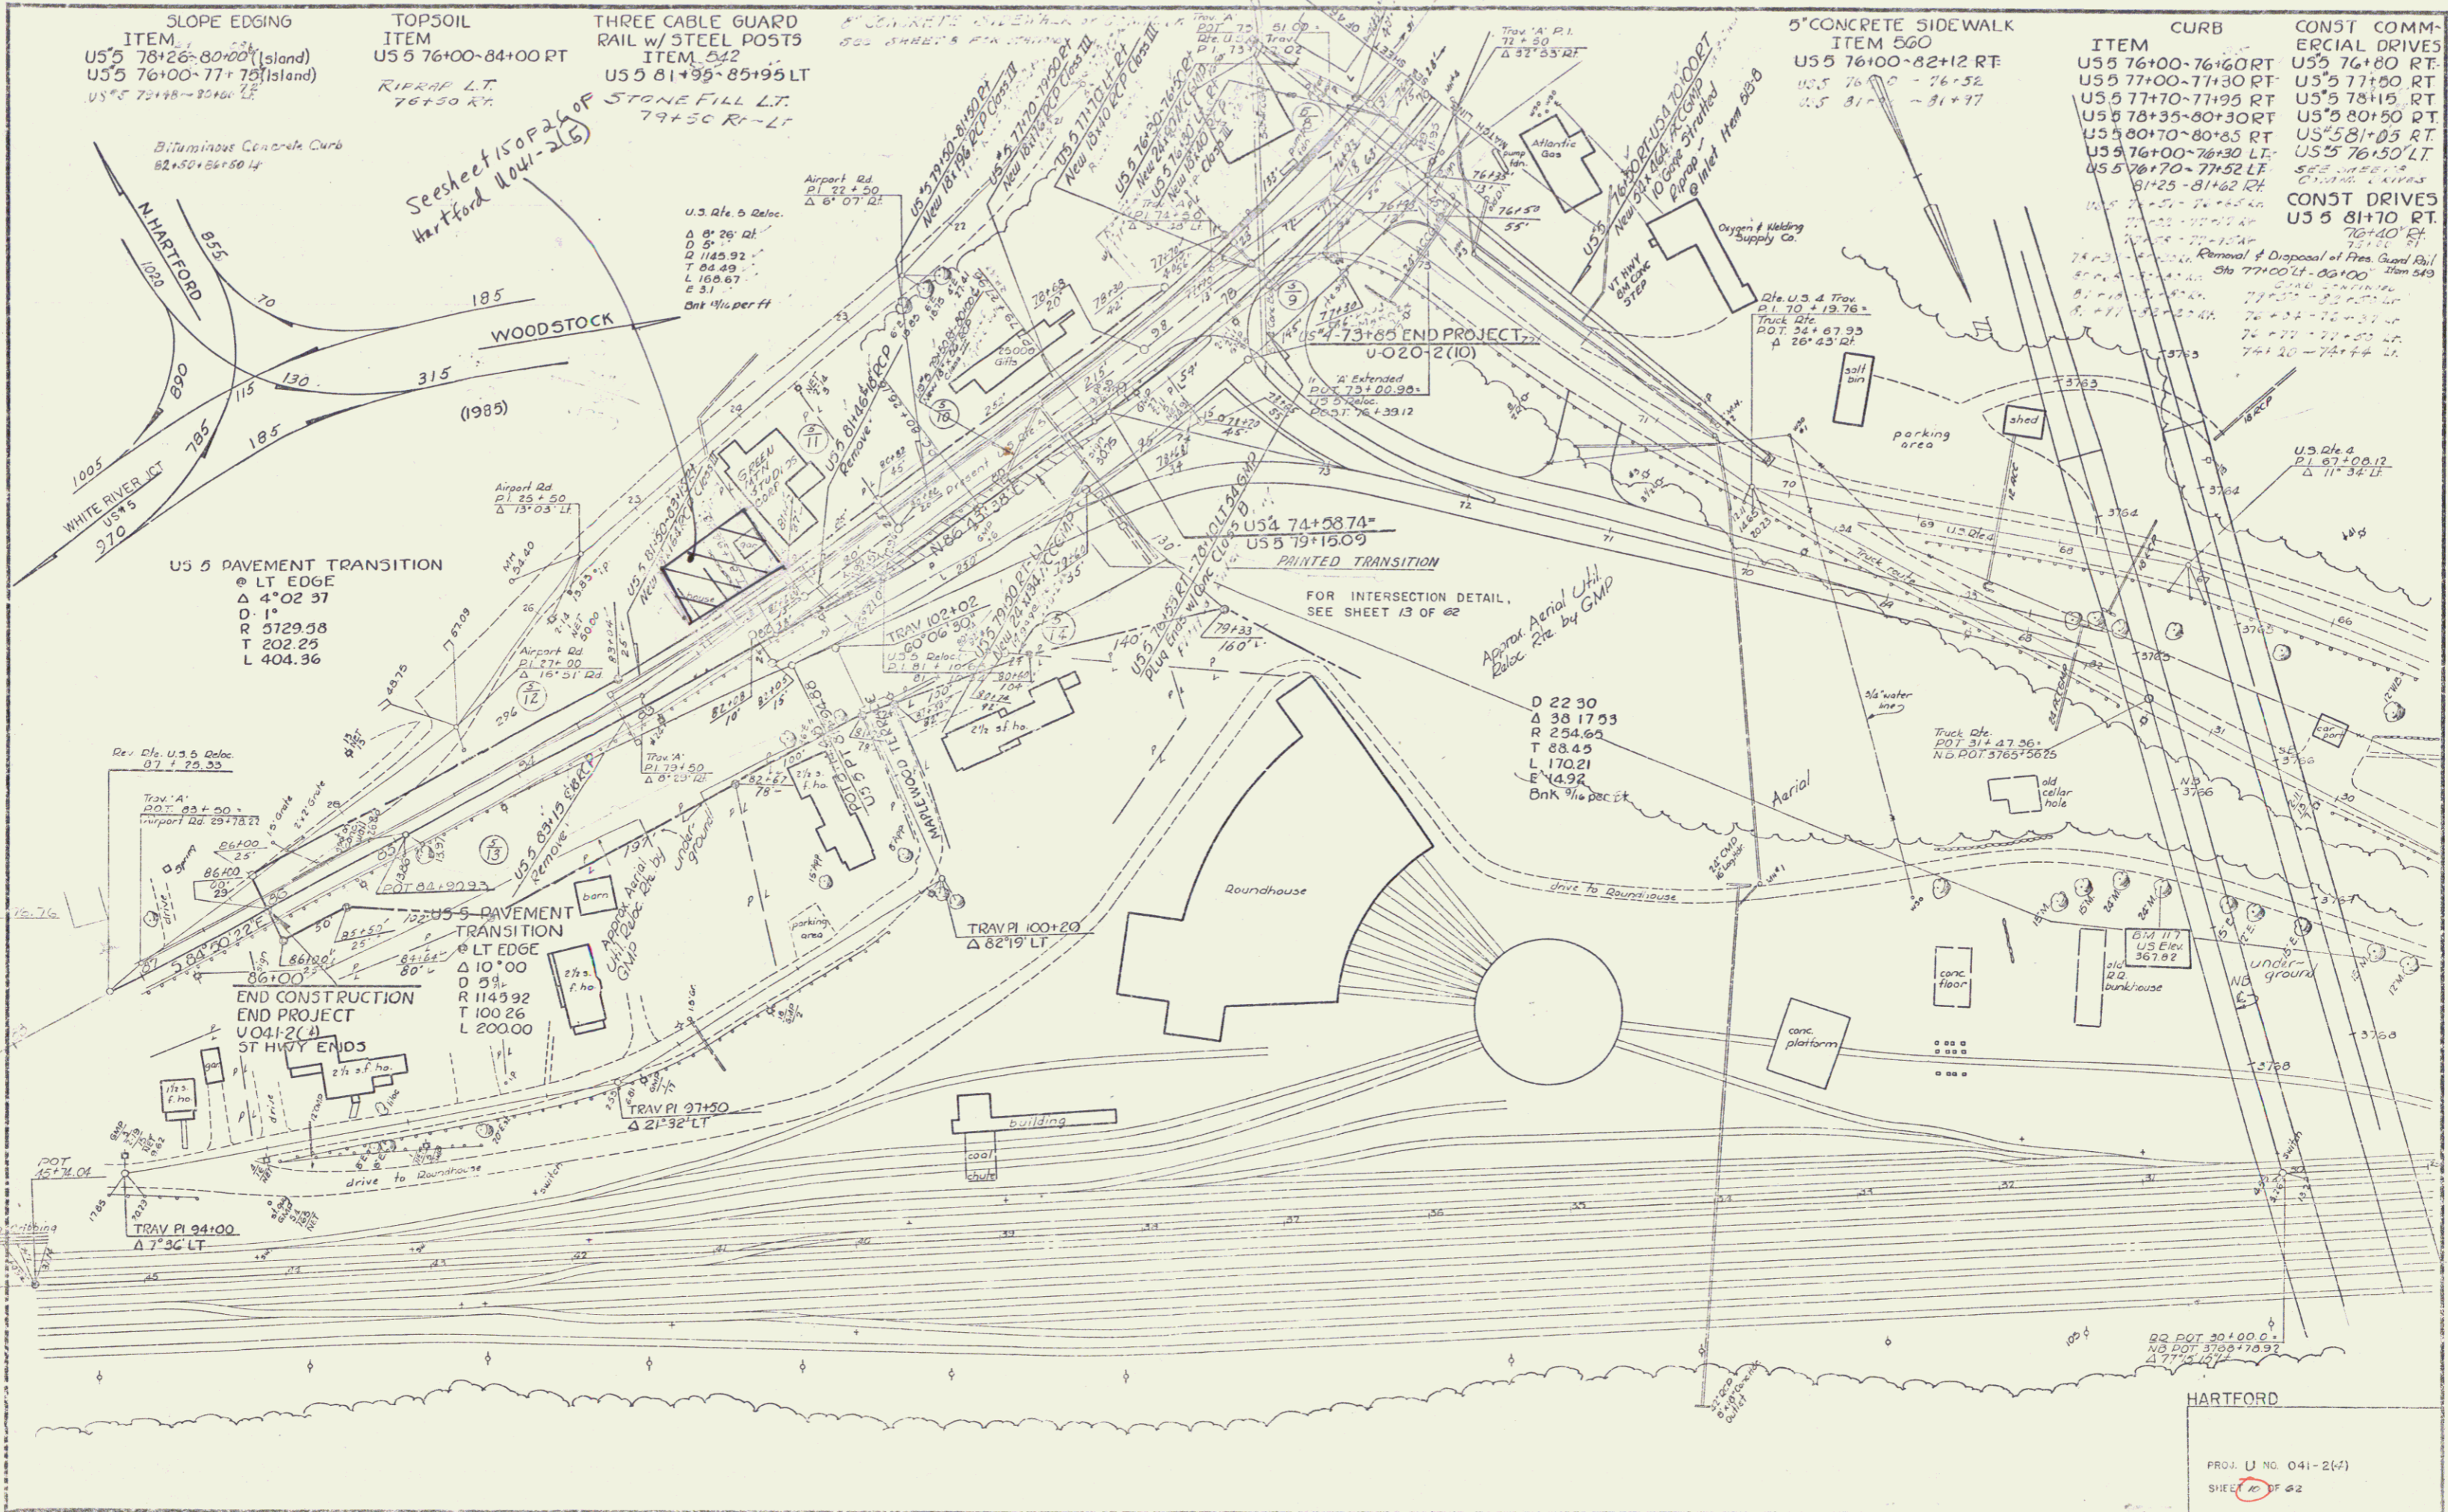

SLOPE EDGING ITEM  
 US 5 78+26-80+00 (Island)  
 US 5 76+00-77+75 (Island)  
 US 5 75+48-80+66 LT

TOPSOIL ITEM  
 US 5 76+00-84+00 RT  
 RIRRAV LT.  
 76+50 RT

THREE CABLE GUARD RAIL w/ STEEL POSTS ITEM 042  
 US 5 81+95-85+95 LT  
 STONE FILL LT.  
 79+50 RT-LT

5" CONCRETE SIDEWALK ITEM 560  
 US 5 76+00-82+12 RT  
 US 5 81+77-81+77

ITEM CURB  
 US 5 76+00-76+60 RT  
 US 5 77+00-77+30 RT  
 US 5 77+70-77+95 RT  
 US 5 78+35-80+30 RT  
 US 5 80+70-80+85 RT  
 US 5 76+00-76+30 LT  
 US 5 76+70-77+52 LT  
 81+25-81+82 RT

CONST COMMERCIAL DRIVES  
 US 5 76+80 RT  
 US 5 77+80 RT  
 US 5 78+15 RT  
 US 5 80+50 RT  
 US 5 81+05 RT  
 US 5 76+50 LT  
 81+25-81+82 RT

CONST DRIVES  
 US 5 81+70 RT  
 76+40 RT  
 77+10 RT  
 Removal & Disposal of Area Guard Rail  
 On 77+00 LT - 80+00  
 Item 549

US 5 PAVEMENT TRANSITION  
 @ LT EDGE  
 Δ 4° 02' 37"  
 D 1°  
 R 5729.58  
 T 202.25  
 L 404.36

Seesheet (5 of 26) of  
 Hartford (441-216)

PRINTED TRANSITION  
 FOR INTERSECTION DETAIL,  
 SEE SHEET 13 OF 62

END CONSTRUCTION  
 END PROJECT  
 UO412(A)  
 ST HWY EN 105

HARTFORD  
 PROJ. U NO. 041-2(2)  
 SHEET NO. OF 62

4a 3