

CONST DRIVES  
 U55 Appr 11+90 LT  
 U55 Appr 3+29 RT  
 U55 Appr 3+30 LT  
 U55 Appr 14+16 RT (Paved)  
 U55 Appr 14+75 RT (Paved)  
 U55 Appr 16+00 RT (Paved)

THREE CABLE GUARD  
 RAIL w STEEL POSTS  
 \*42+00 - 44+25 RT  
 \*44+75 - 47+79 LT  
 \*46+10 - 48+74 RT

STONE FILL FOR  
 SLOPE PROTECTION  
 42+85-43+75 RT

GRANITE SLOPE EDGING  
 U55 Appr 4+40 - 10+40 LT (ISLAND)  
 U55 Appr 11+00 - 16+00 LT (ISLAND)  
 47+85 - 48+85 (ISLAND)  
 48+35 - 48+85 (ISLAND)


DEMOLITION & REMOVAL  
 OF BUILDING ITEM 586  
 BLDG NO 1 U55 4+50 LT  
 BLDG NO 2 U55 4+90 LT  
 BLDG NO 3 U55 5+50 LT  
 BLDG NO 4 U55 6+25 LT  
 BLDG NO 5 U55 7+50 LT  
 BLDG NO 6 U55 7+85 LT  
 BLDG NO 7 U55 9+30 LT  
 BLDG NO 8 U55 11+20 LT  
 BLDG NO 9 U55 13+50 LT  
 BLDG NO 10 U55 14+20 LT  
 BLDG NO 11 U55 15+50 LT

5" CONC SIDEWALK  
 U55 APPR 3+30-17+00 RT


GRANITE CURB  
 U55 Appr 3+30-14+08 RT  
 U55 Appr 14+24 - 14+67 RT  
 U55 Appr 14+03 - 15+93 RT  
 U55 Appr 16+08 - 16+28 RT  
 U55 Appr 16+68 - 16+88 RT

CONST COMM DRIVES  
 U55 Appr 16+48 RT (Paved)

TREATED TIMBER CURBING  
 ITEM  
 \*44+75 - 47+79 LT  
 \*46+18 - 48+74 RT

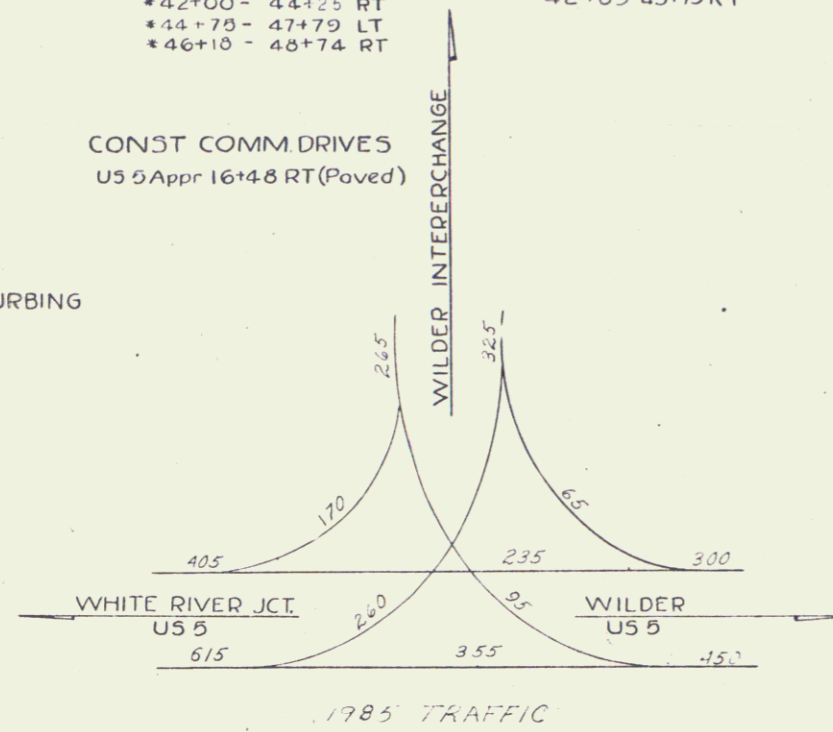

DATE	BY	REVISION

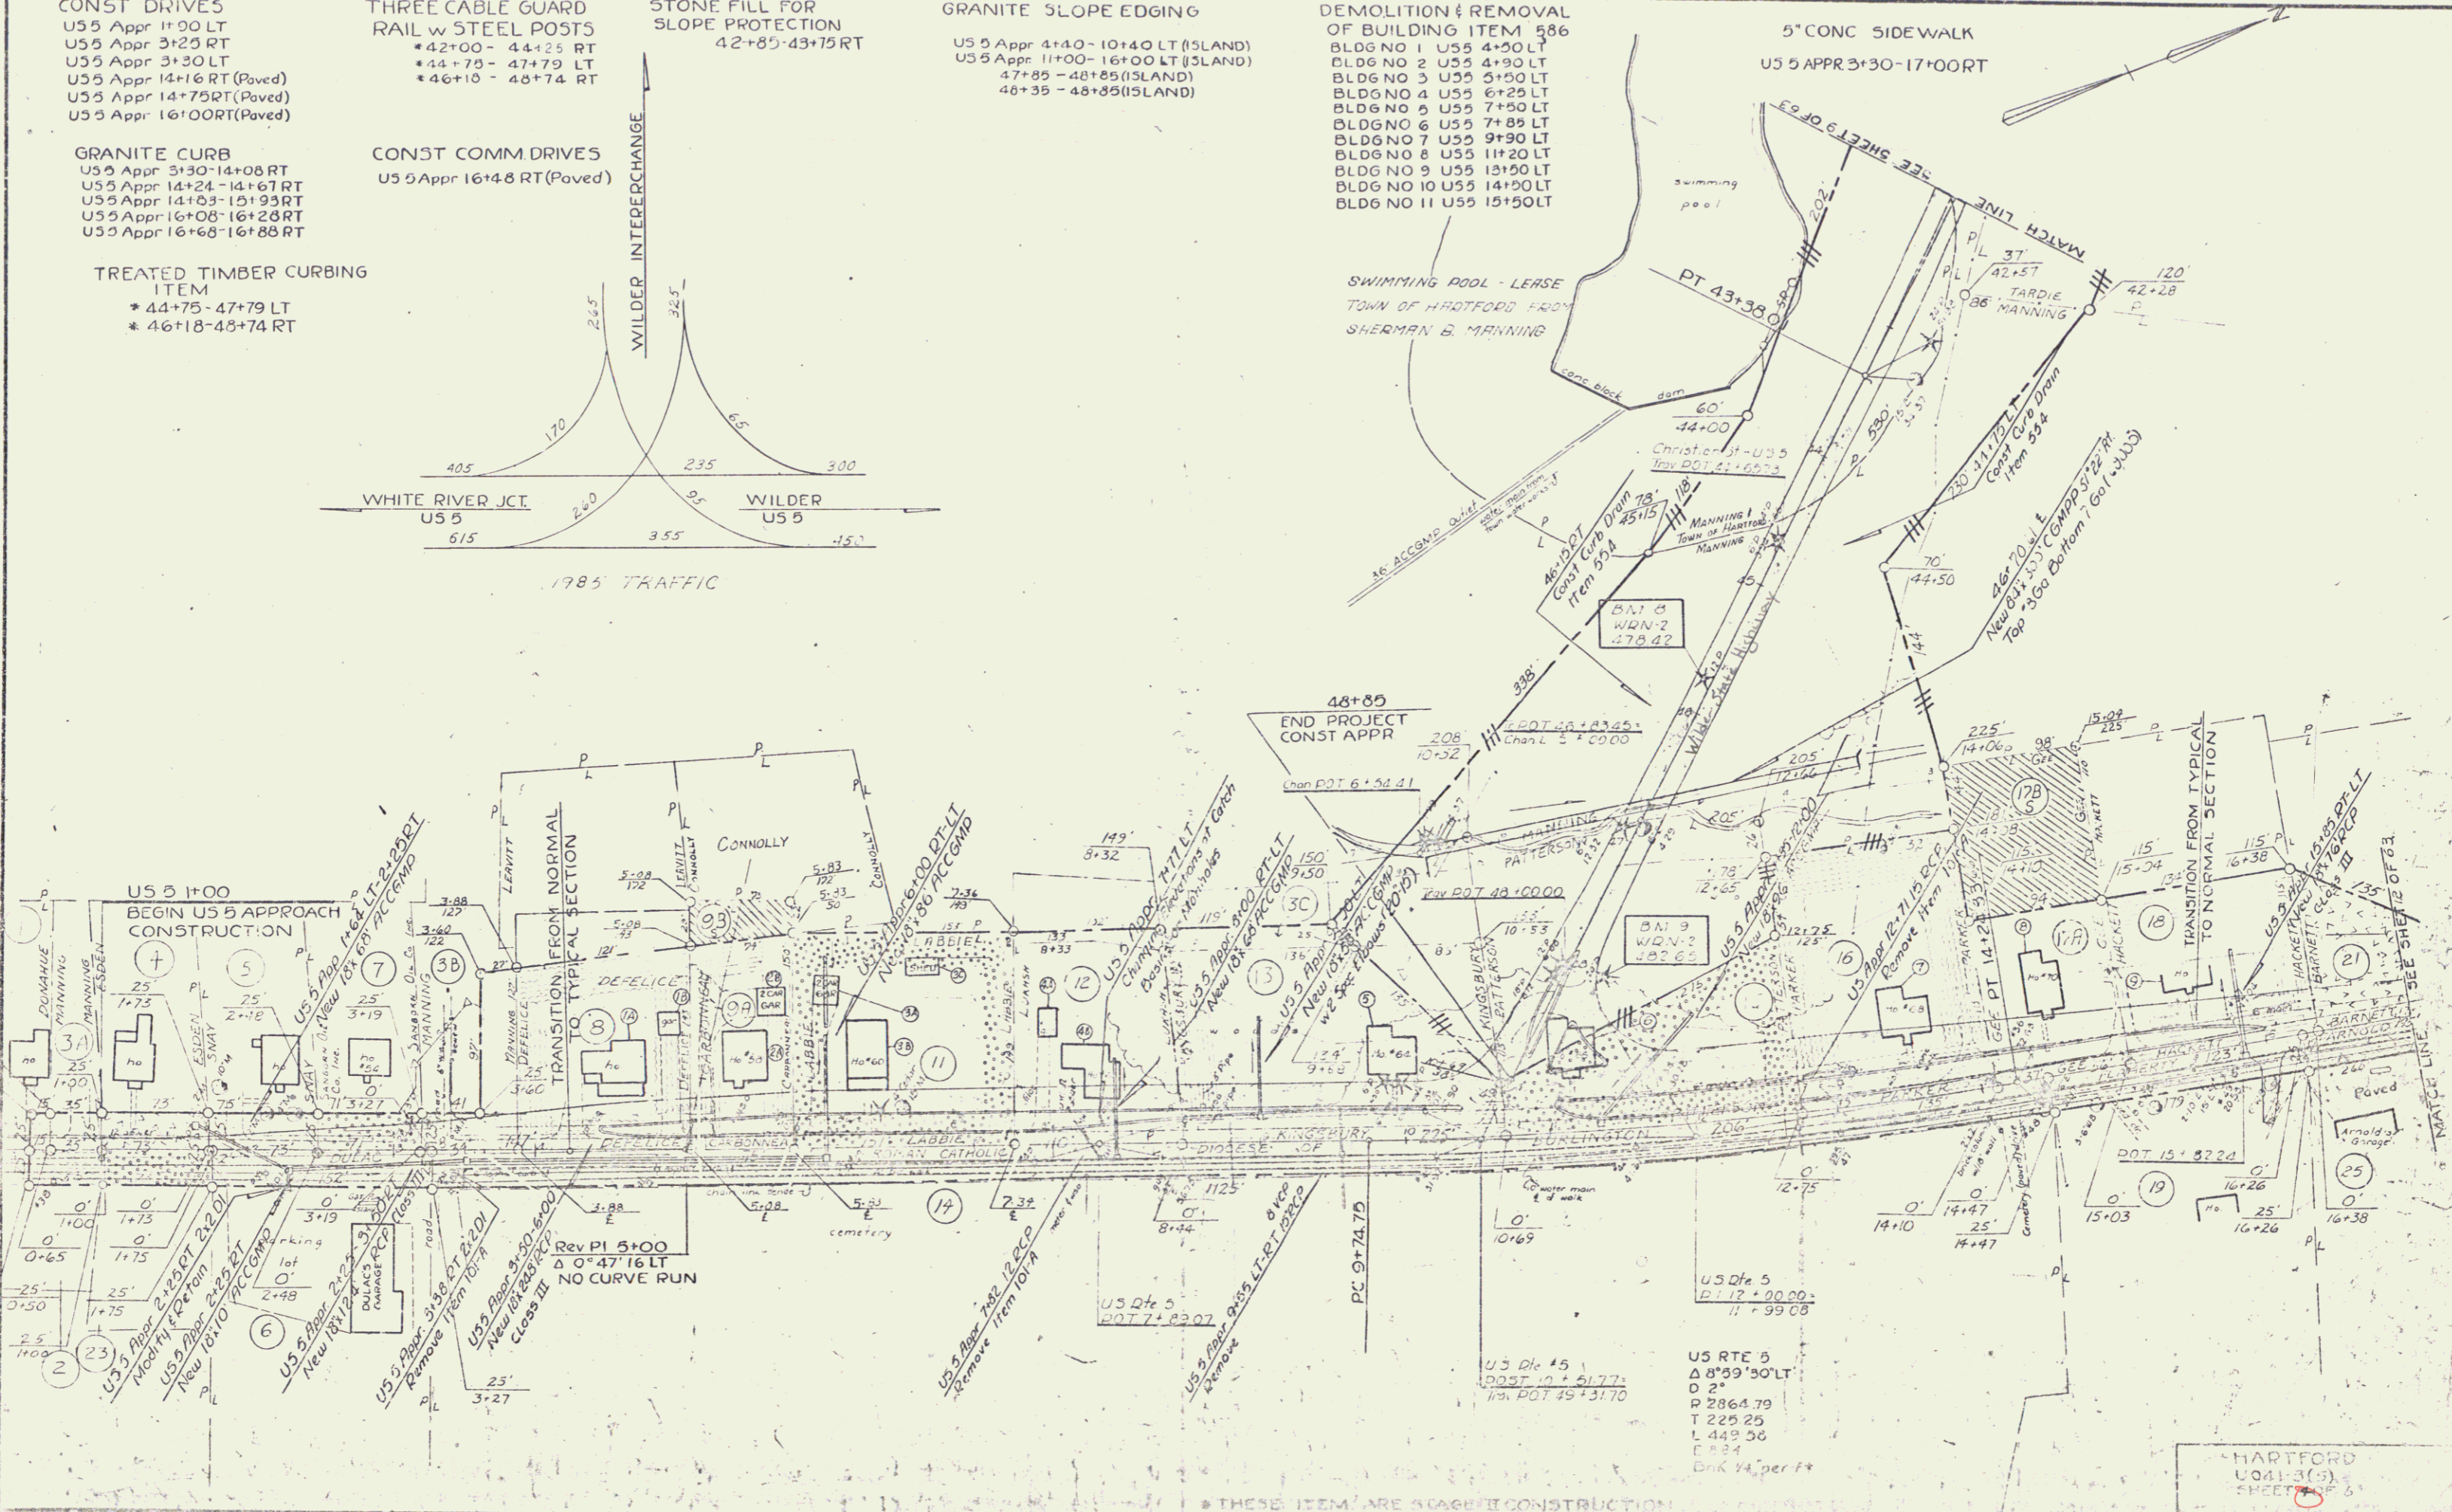

HARTFORD  
 U041-3(3)  
 SHEET 5