

TOP SOIL ITEM 621		
STATION	STATION	POS
510+61	510+83	21

VERTICAL GRANITE CURB ITEM 556-B		
STATION	STATION	POS
511+09	510+83	LT
511+09	510+83	RT
511+09	510+83	LT
511+09	510+83	RT
6" ONE COURSE CEMENT CONCRETE SIDEWALK ITEM 560		
STATION	STATION	POS
511+09	510+83	LT
511+09	510+83	RT
511+09	510+83	LT
511+09	510+83	RT
CONSTRUCT DRIVE		
STATION	POS	
511+09	21	RT
511+09	21	LT
511+09	21	RT
511+09	21	LT
CONCRETE CURB ITEM 401-B/MOD		
STATION	STATION	POS
511+09	511+50	RT
511+09	511+50	LT

CONSTRUCT ISLAND		
STATION	STATION	POS
510+61	510+83	RT

REMOVE EXISTING ROAD SURFACE COMMON EXCAVATION, CLASS 1 ITEM 103-4-1		
STATION	STATION	POS
511+13	515+00	-

GRANITE SLOPE EDGING ITEM 556-A		
STATION	STATION	POS
510+61	510+83	RT

EXCAVATION AND REMOVAL OF ROAD SURFACES AND/OR PAVEMENTS ITEM 119		
STATION	STATION	POS
510+61	511+00	LT

REMOVING AND RESETTING CURB ITEM 557		
REMOVE FROM (GRANITE SLOPE EDGING)		
510+83 - 510+92 (11' long)		
RESET AT 510+61 - 510+83 (11' long)		
REMOVE FROM (VERTICAL GRANITE CURB)		
511+20 - 511+23 (3' long)		
RESET AT 511+22 - 511+23 (1' long)		



STEEL GUIDE POSTS ITEM 547-B		
STATION	POS	
511+31	21	

STATE OF VERMONT
 DEPARTMENT OF HIGHWAYS
 RELOCATION OF SA-5 in the town of FAIR HAVEN
 RELOCATION OF STATE AID ROUTE 5
 PLAN
 STA. 509+0000-515+0000

WEBSTER-MARTIN, INC.
 CONSULTING ENGINEERS
 30 BURLINGTON, VERMONT

DESIGNED BY W-M INC | CHECKED BY TJS | SCALE AS SHOWN
 DRAWN BY JO | IN CHARGE: NAS | DATE: FEB 1988

PROJECT NO S 1142(3) | SHEET 6 OF 41

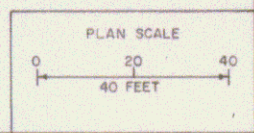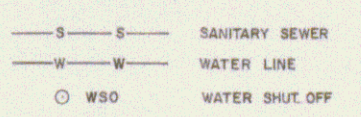

SEE SHEET 8 OF 41