


INDEX OF SHEETS

1	TITLE SHEET
2	TYPICAL SHEET
3-3A	QUANTITY AND DRAINAGE SHEETS
4	EARTHWORK SHEET
5	ROW DETAIL SHEET
6-9A	PLAN AND PROFILE SHEETS
10	A-60 SOLID ROCK EXCAVATION 8/7/65
11	B-1 BANKING TABLES 7/11/67
12	B-5 TYPICAL SLOPE GRADING 3/10/65
13	B-6 MUCK EXCAVATION 3/10/65
14	B-10 EMBANKMENT ON A SLOPE 3/10/65
15	B-11 METHODS OF SLOPE STABILIZATION 3/10/65
16	C-1 CURBS 3/10/65
17	C-1A CURBS 3/10/65
18	D-2 HEADWALLS 7/25/67 R
19	D-3 GUTTERS AND GUTE MATTING 7/18/67 R
20	D-4 FLUSHING BASINS 8/1/66 R
21	D-8 DROP INLETS 3/10/65
22	D-10 DROP INLET TOPS 3/10/65
23	D-11 DROP INLET GRATES 3/10/65
24	E-31 Federal Aid Construction Identification Signs 8/21/67 R
25	E-32 Road Construction Approach Signs 1/6/65
26	E-34 On-Project Construction Signs 5/3/67 R
27	G-4 Plank Guard Rail 12/30/65 R
28	G-6 Three Cable Guard Rail with Light Steel Posts 8/31/67
29	G-7 Three Cable Guard Rail with Light Steel Posts 8/31/67
30	G-8 Bridge Railing (For Bridge Approaches) 3/18/67 R
31	G-9 Bridge Railing (For Bridge Approaches) 3/27/67
32	J-41 Boundary and Project Markers 3/10/65
33-32	Cross Sections
9-5.5.D	Bridge In-Stream Sheet
9-5.5.D	Earthwork Final Sheet

FOR SIGNS OF WAY DETAILS, SEE RIGHT OF WAY PLANS FOR THIS PROJECT.


STATE OF VERMONT
DEPARTMENT OF HIGHWAYS
PROPOSED IMPROVEMENT
TOWN OF WEATHERSFIELD
COUNTY OF WINDSOR
VERMONT ROUTE 12
ASCUTNEY, VT. - CLAREMONT, N.H. RD.

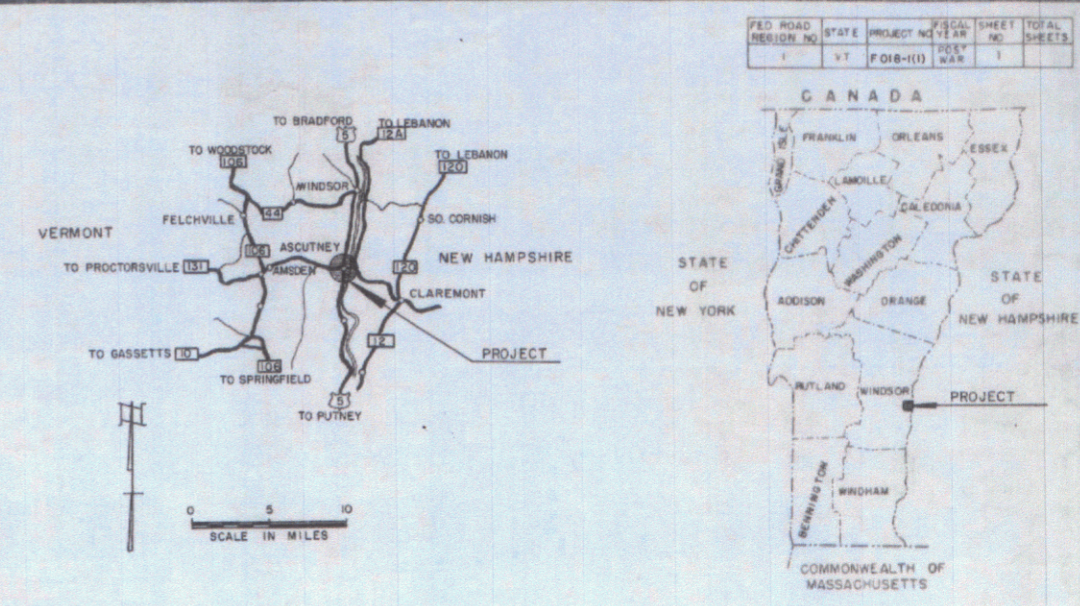

BEGINNING AT A POINT 0.331 MILE NORTHWESTERLY OF THE N.H.-VT. STATE LINE AND EXTENDING SOUTHEASTERLY 0.316 MILE

LENGTH OF ROADWAY 1,667.0 FEET = 0.316 MILE
LENGTH OF PROJECT 1,667.0 FEET = 0.316 MILE

ADT 1966	3200
ADT 1986	6075
DHV 1986	935
D	55.5%
T	6%
V	50 MPH

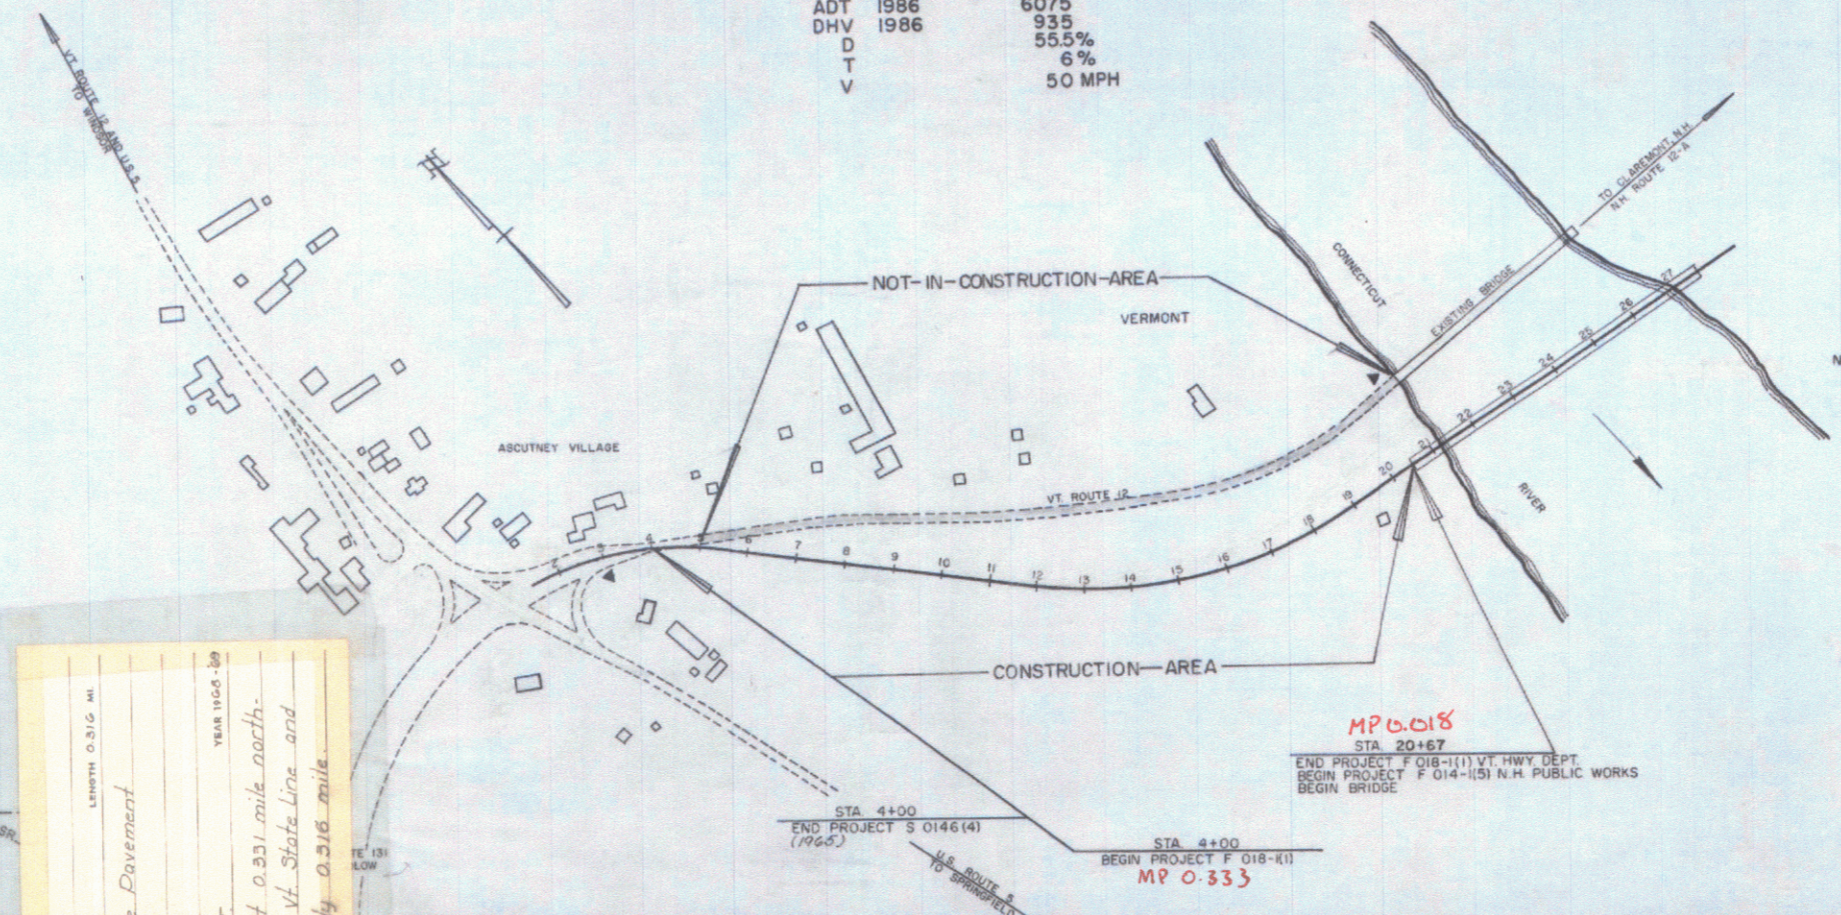

PROJECT NAME & NUMBER	TYPE PAVEMENT	AREA SQ. YD.
WEATHERSFIELD F 018-1(1)	BITUMINOUS CONCRETE	
RECORD PLANS		
MATERIALS		
SUB-BASE OF GRAVEL - ROGERS' PIT, FERRISVILLE, VT.		
SUB-BASE OF SAND - NONE		
GRAVEL SHOULDER SHOULDERS - HAMMOND PIT, WINDSOR, VT.		
CRUSHED GRAVEL		
NEW HAMPSHIRE CRACKED TAR		
SUITABLE ASPHALT - MOBILE OIL CO., ALBANY, & S. PRINCETON, N.H.		
SAND OR PEASTONE		
CONCRETE CLASS 10'		
PERMI CRUSHER, REG. OF MASS., BETHL., VT.		
BIT. CON. PAVEMENT - COLD RIVER SAND & GRAVEL CO., N. HAMPSHIRE, N.H.		
REINFORCING STEEL		
METAL PIPE CULVERT - NORTHEASTERN CULVERT CO., WESTMINSTER, VT.		
R.C.P.		
CAST IRON GRATE, 15' - E.L. LEBARON FOUNDRY CO., BRACKTON, MASS.		
DROP INLETS		
GUARD RAIL ITEMS - S.T. GRISWOLD & CO., INC.		
STRUCTURAL STEEL		
CAST IRON COVER FOR F.B. N. EASTERN CULV. CO., WESTMINSTER, VT.		
SEAMLESS COPPER WATER TUBE - CERRO COPPER (BRASS) CO., E. ST. LOUIS, MO.		

CONVENTIONAL SIGNS

COUNTY LINE	RIGHT-OF-WAY
TOWN LINE	SLOPE RIGHTS
FENCE LINE	GROUND ELEVATION
STONE WALL	GRADE ELEVATION
UNFENCED PROPERTY	CURVE DAT
GUARD RAIL	DEFLECTION OF ANGLE
TRAVELED WAY	DEGREE OF CURVE
RAILROAD	RADIUS OF CURVE
RETAINING WALL	TANGENT DISTANCE
CENTER LINE	LENGTH OF CURVE
SURVEY LINE	EXTERNAL DISTANCE
CULVERT	POINT OF INTERSECTION
DROP INLET	POINT OF CURVE
TROLLEY POLE	POINT OF TANGENT
POWER POLE	POINT ON TANGENT
TELEPHONE POLE	POINT ON SUB-TANGENT
TREES	
HEDGE	
FEDERAL AID IDENTIFICATION SIGNS A	

PROJECT WEATHERSFIELD
NUMBER F 018-1(1)
TYPE Bituminous Concrete Pavement
CONTRACTOR ROGERS BROS.
BRATTLEBORO, VT.
LOCATION Beginning at a point 0.331 mile north and westerly of the N.H.-Vt. State Line and extending southeasterly 0.316 mile

APPROVED <i>R.H. C... ASSE CHIEF ENGINEER</i> DATE 2/24/65	APPROVED <i>E.H. St... DISTRICT ENGINEER</i> DATE 2/23/65	APPROVED <i>BRIDGE ENGINEER</i> DATE	APPROVED <i>R.O. Munn DISTRICT ENGINEER</i> DATE 2/18/65	APPROVED <i>G.M. Lane HIGHWAY ENGINEER</i> DATE 2/15/65	APPROVED <i>G.D. Bishop CHIEF ENGINEER</i> DATE 2/24/65
---	--	---	---	--	--

DEPARTMENT OF TRANSPORTATION
BUREAU OF PUBLIC ROADS

APPROVED

DIVISION ENGINEER DATE

PROJECT F NO. 018-1(1)

SHEET 0 OF 42 SHEETS

THESE PLANS ARE SUBJECT TO SUCH REVISIONS AS MAY BE REQUIRED BY THE BUREAU OF PUBLIC ROADS OR THE COMMISSIONER OF HIGHWAYS.

CONSTRUCTION IS TO BE CARRIED ON IN ACCORDANCE WITH THESE PLANS AND THE STANDARD SPECIFICATIONS FOR HIGHWAY AND BRIDGE CONSTRUCTION DATED APRIL, 1964, AS APPROVED BY THE BUREAU OF PUBLIC ROADS ON OCTOBER 12, 1964, INCLUDING ALL SUBSEQUENT APPROVED REVISIONS AND SUCH REVISED SPECIFICATIONS AND SPECIAL PROVISIONS AS ARE INCORPORATED IN THESE PLANS.

NOTE: ANY FURTHER INFORMATION CONCERNING FINAL QUANTITIES SUBJECT TO SHOP DETAILS RELATIVE TO THIS PROJECT MAY BE OBTAINED IN EITHER THE FIELD BOOKS OR THE ESTIMATE FILE.