


PLAN
 DATE: 12/25
 W.H.D. & H.W.S.
 9/25/36

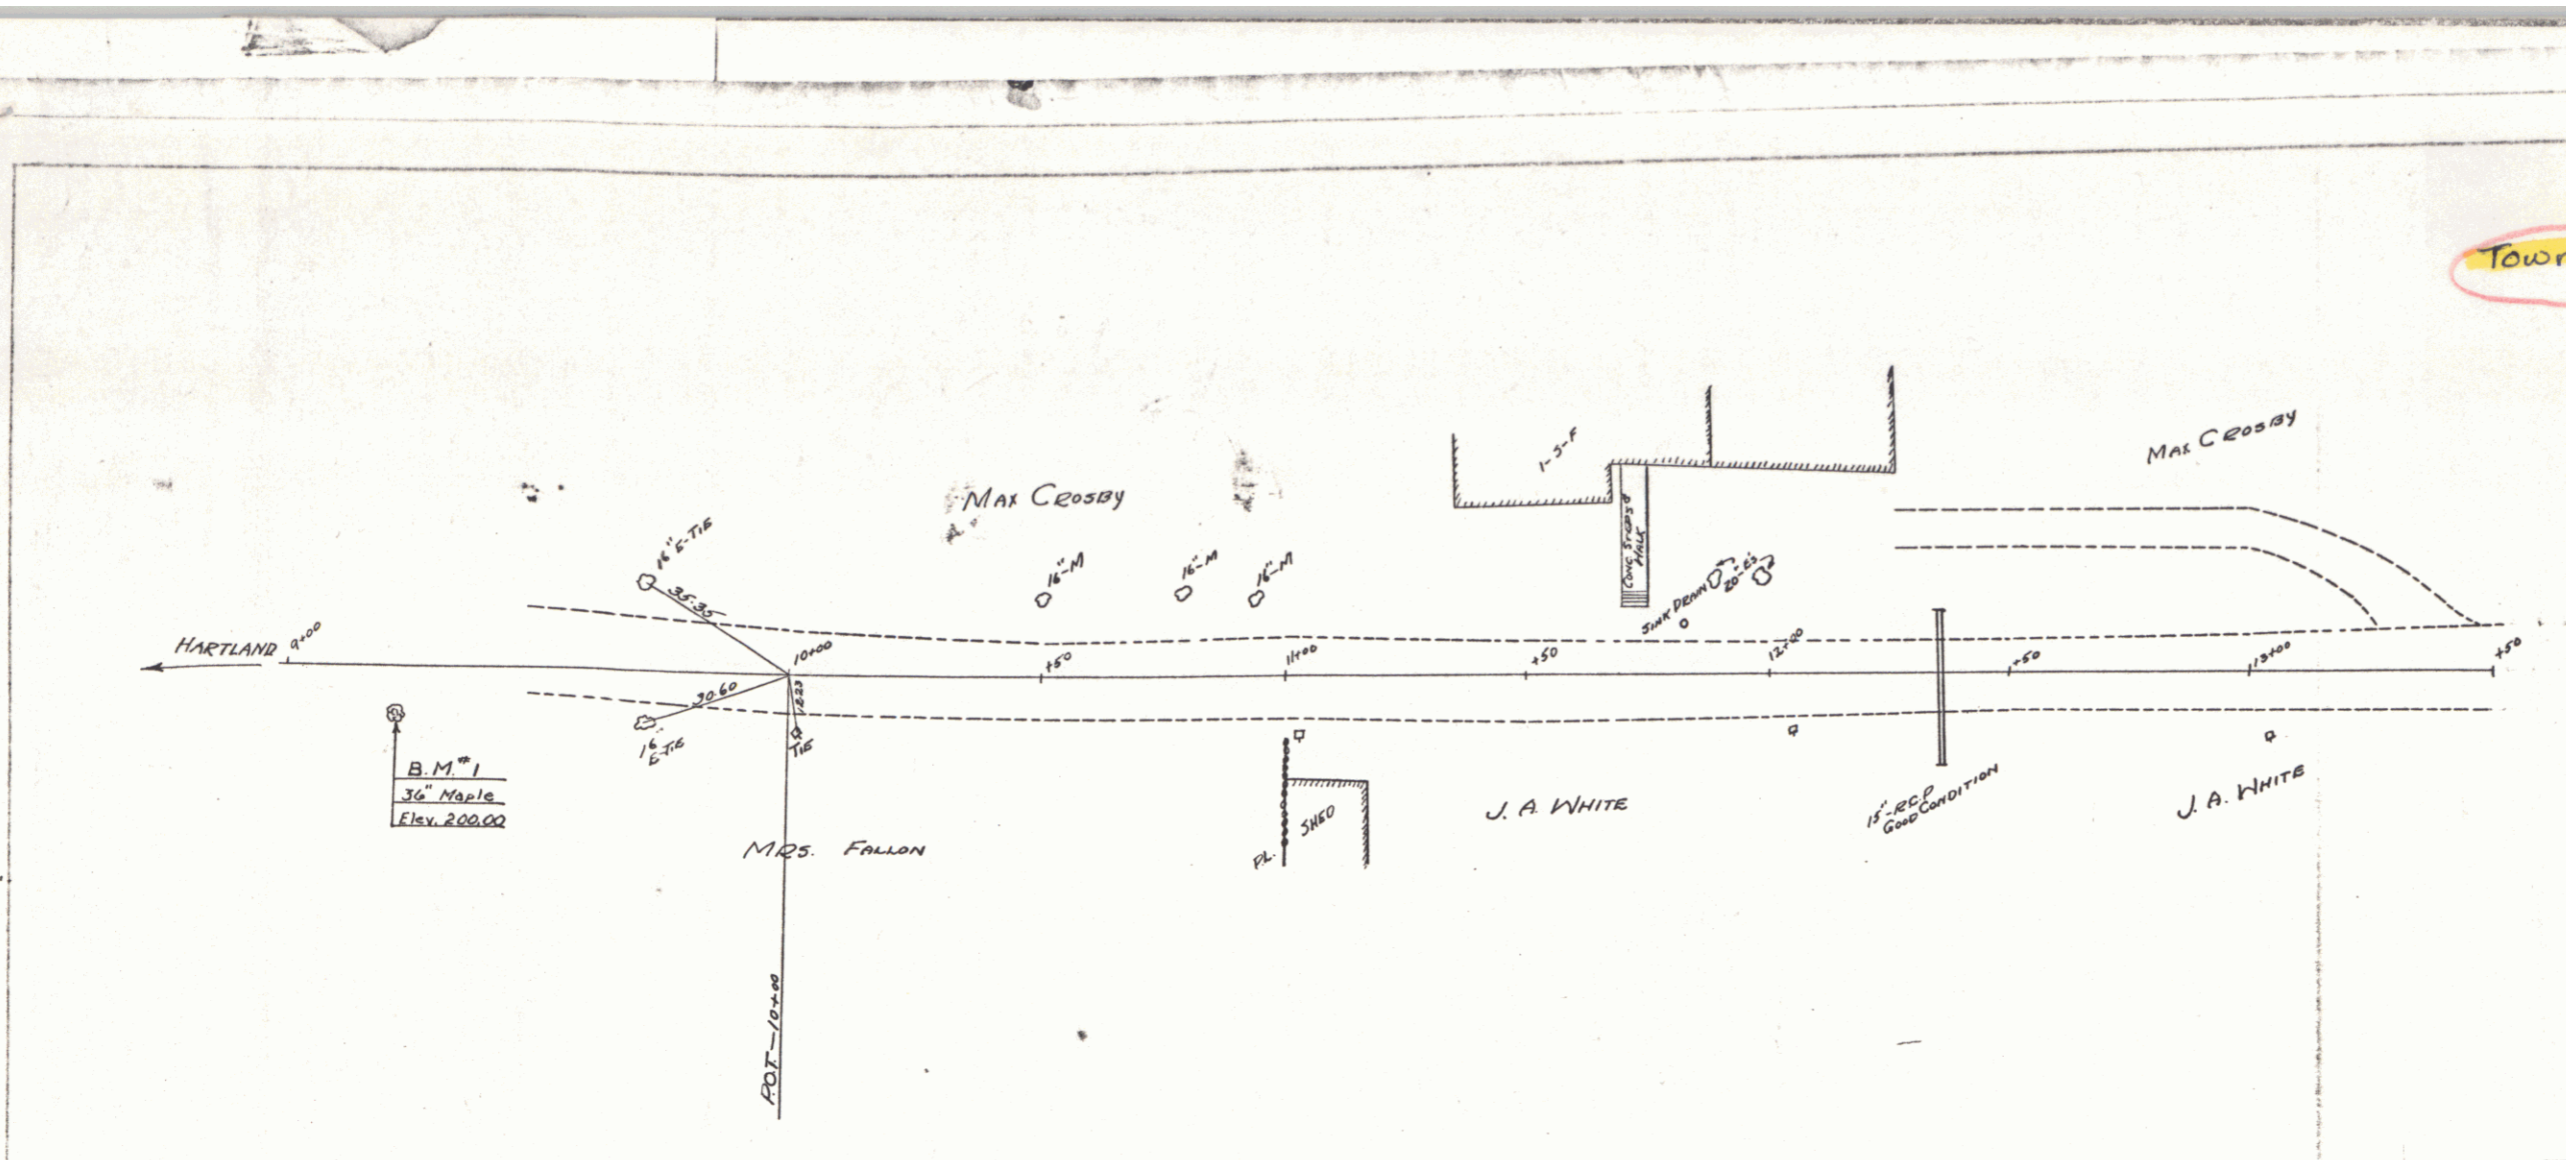

Town of Hartland
 Pin # 99R925

Proj # PWA 1020-E
 01/01/1936

Br # 3
 MP 1.295-1.541
 RIGHT-OF-WAY DIVISION
 TOWN FILE
 PERPETUAL
 Town of UT 12
 (To Be Returned To R.O.W. Division)

| | |
|------------|--------------------|
| PROJECT | Hartland |
| NUMBER | PWA-1020-E |
| DATE | 11/36 |
| CONTRACTOR | Hartland & Company |
| LOCATION | Rt # 12 |
| YEAR | 1936 |

210
 200
 190
 180

1208
 1977
 1968
 1961
 1955
 1950
 1945
 1932
 1923

B.M. # 1 Spike in root 36" Maple 16' At Sta. 9+25 Elev. 200.00

SHEET 1

DIST. # 4 PLANS