


|                     |       |           |             |           |              |
|---------------------|-------|-----------|-------------|-----------|--------------|
| FED. ROAD DIST. NO. | STATE | PROJ. NO. | FISCAL YEAR | SHEET NO. | TOTAL SHEETS |
|                     | Vt.   |           |             | 346       |              |

PLAN  
 DATE: 5-22-50  
 DRAWN BY: J. J. [unclear]  
 CHECKED BY: [unclear]  
 SCALE: 1" = 40'

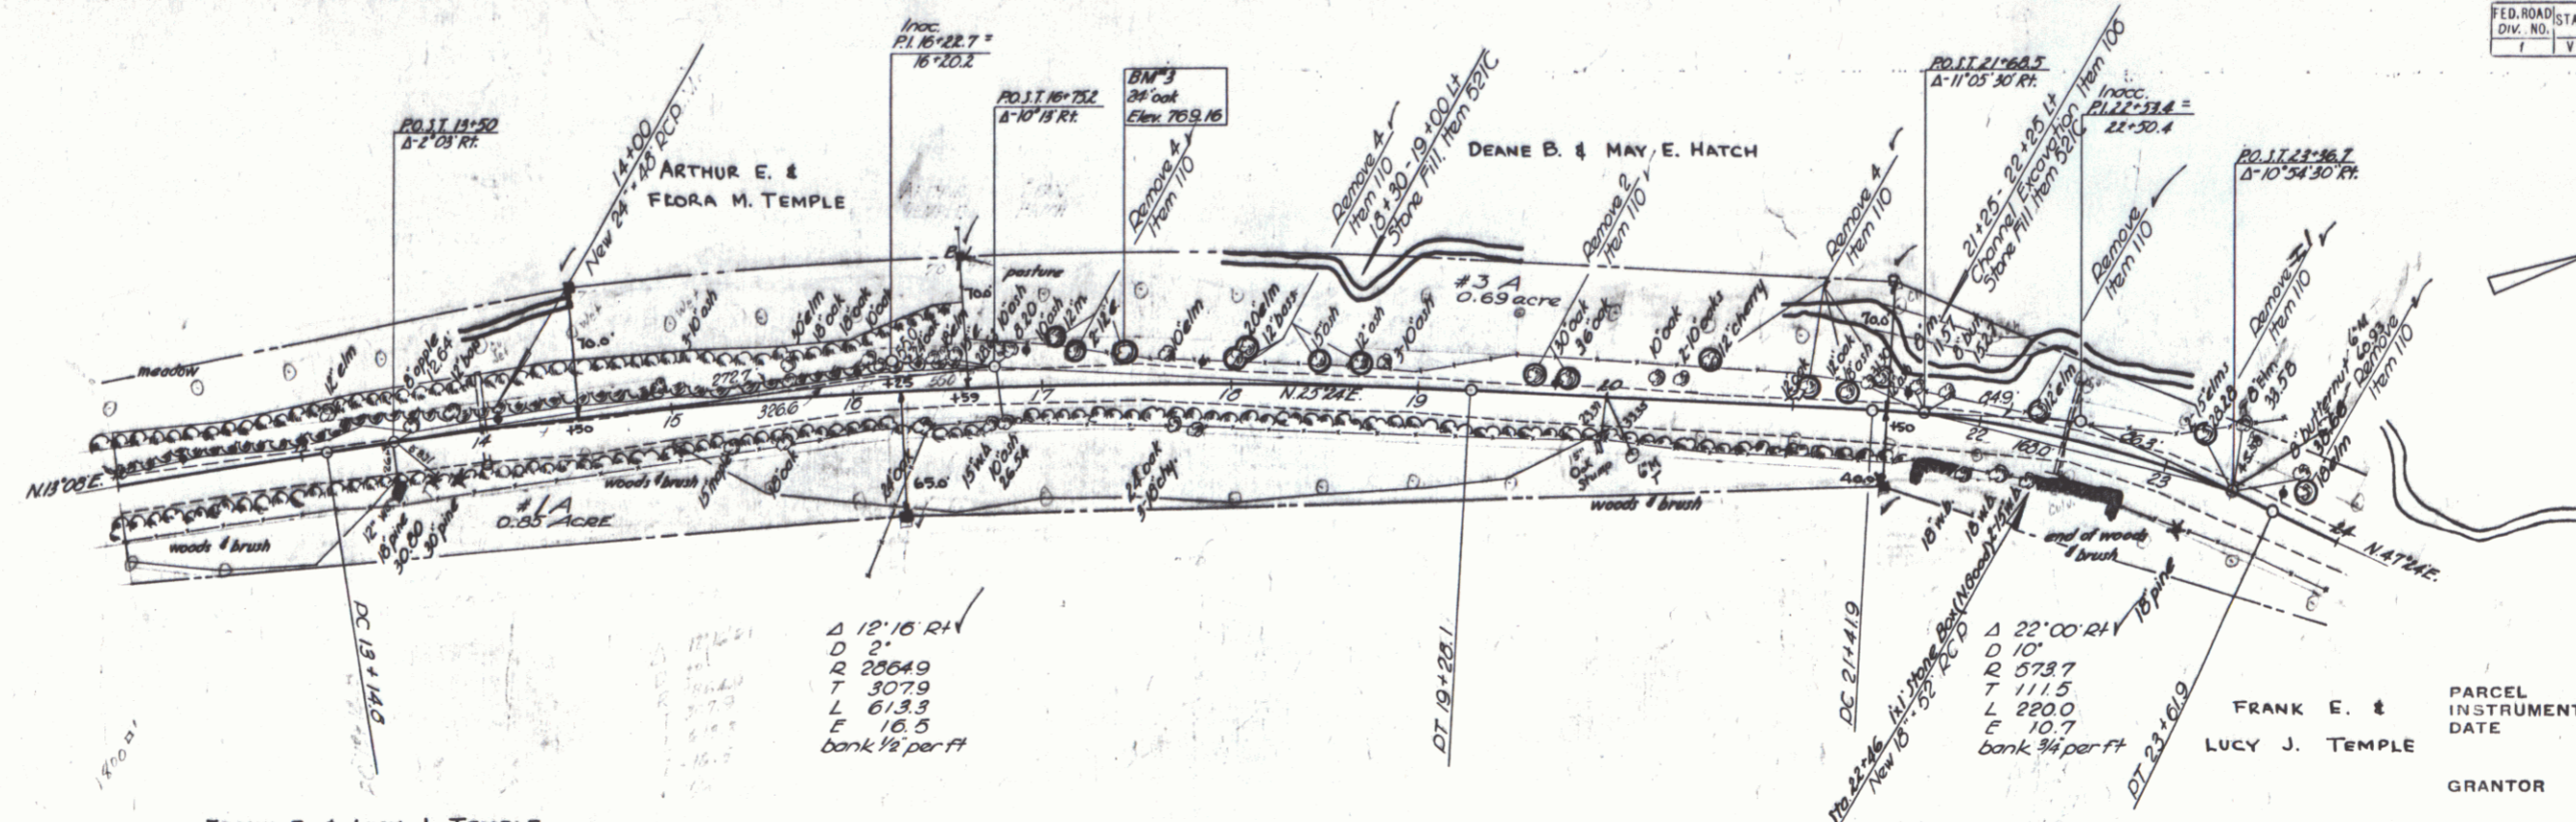

Δ 12°16' RH  
 D 2'  
 R 22649  
 T 3079  
 L 613.3  
 E 10.5  
 bank 1/2 per ft


Δ 22°00' RH  
 D 10'  
 R 27237  
 T 111.5  
 L 220.0  
 E 10.7  
 bank 3/4 per ft

FRANK E. &  
 LUCY J. TEMPLE

PARCEL #3443  
 INSTRUMENT W.D.O.E.  
 DATE 6-1-50  
 GRANTOR DEANE B. & MAY B. HATCH  
 GRANTEE ST. OF VT.  
 RECORDED HARTLAND  
 BOOK 39  
 PAGE 346  
 DATE 5-22-50  
 REMARKS: #3B ON SHEET 17

Clearing & Grubbing Item 104  
 12+00 15+00 LH  
 12+00 14+00 LH  
 15+00 20+00 LH

PROFILE  
 DATE: 5-22-50  
 DRAWN BY: J. J. [unclear]  
 CHECKED BY: [unclear]  
 SCALE: 1" = 40'

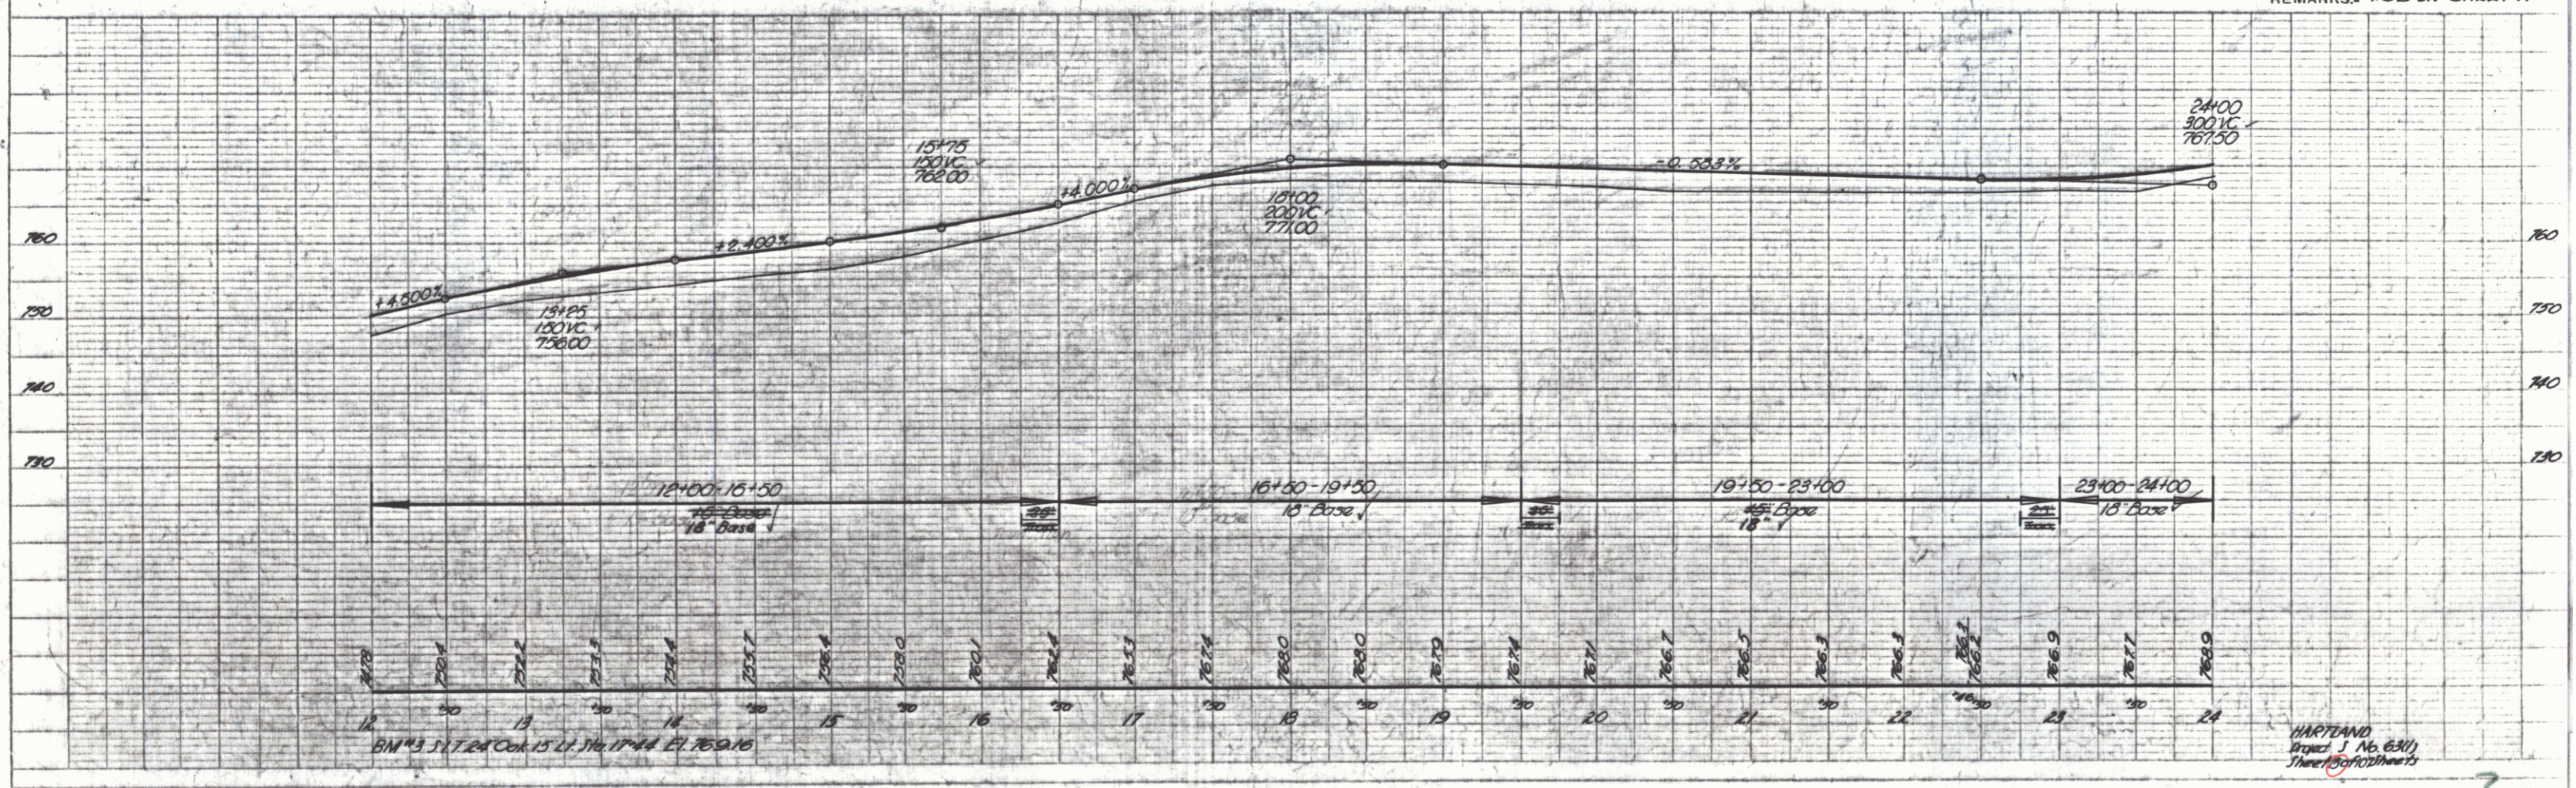

HARTLAND  
 Draft J. No. 6811  
 5/22/50