
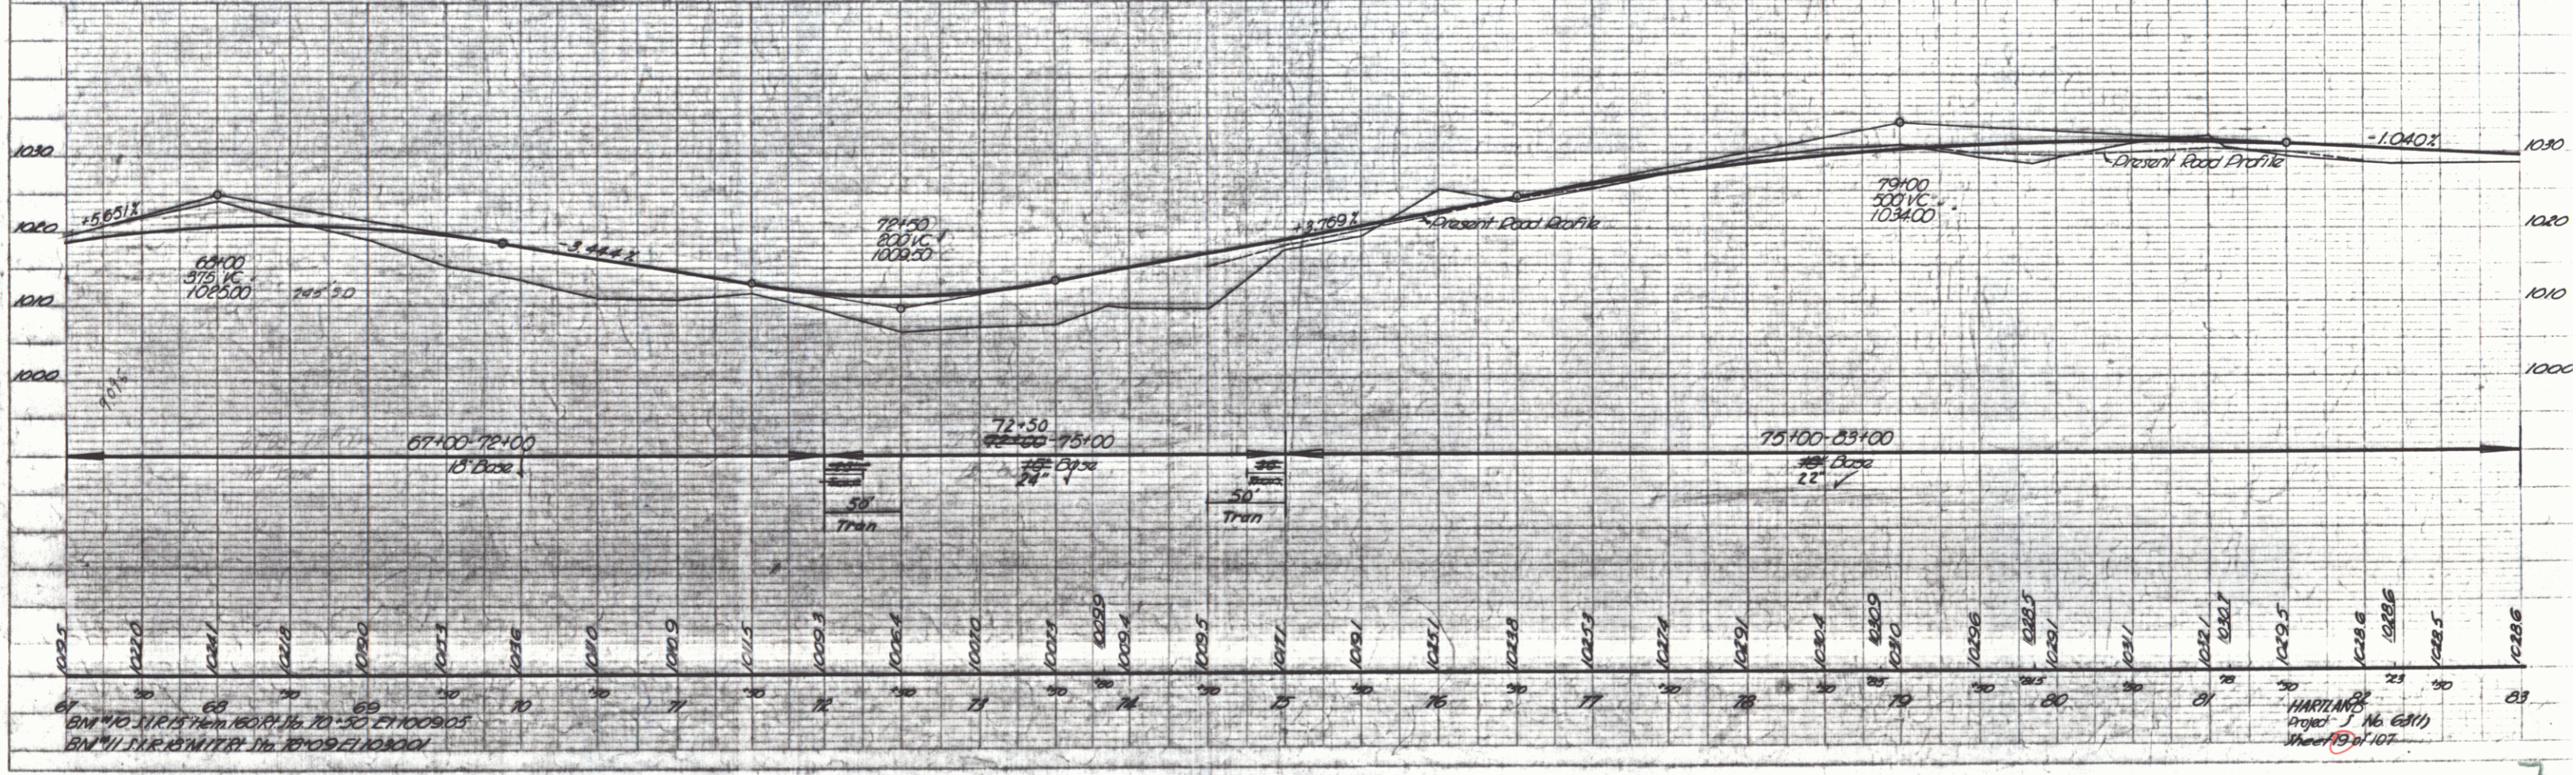


PLAN	DATE	BY
REVISED	DATE	BY
SAFETY CHECKED	DATE	BY
APPROVED	DATE	BY

PROFILE	DATE	BY
REVISED	DATE	BY
SAFETY CHECKED	DATE	BY
APPROVED	DATE	BY

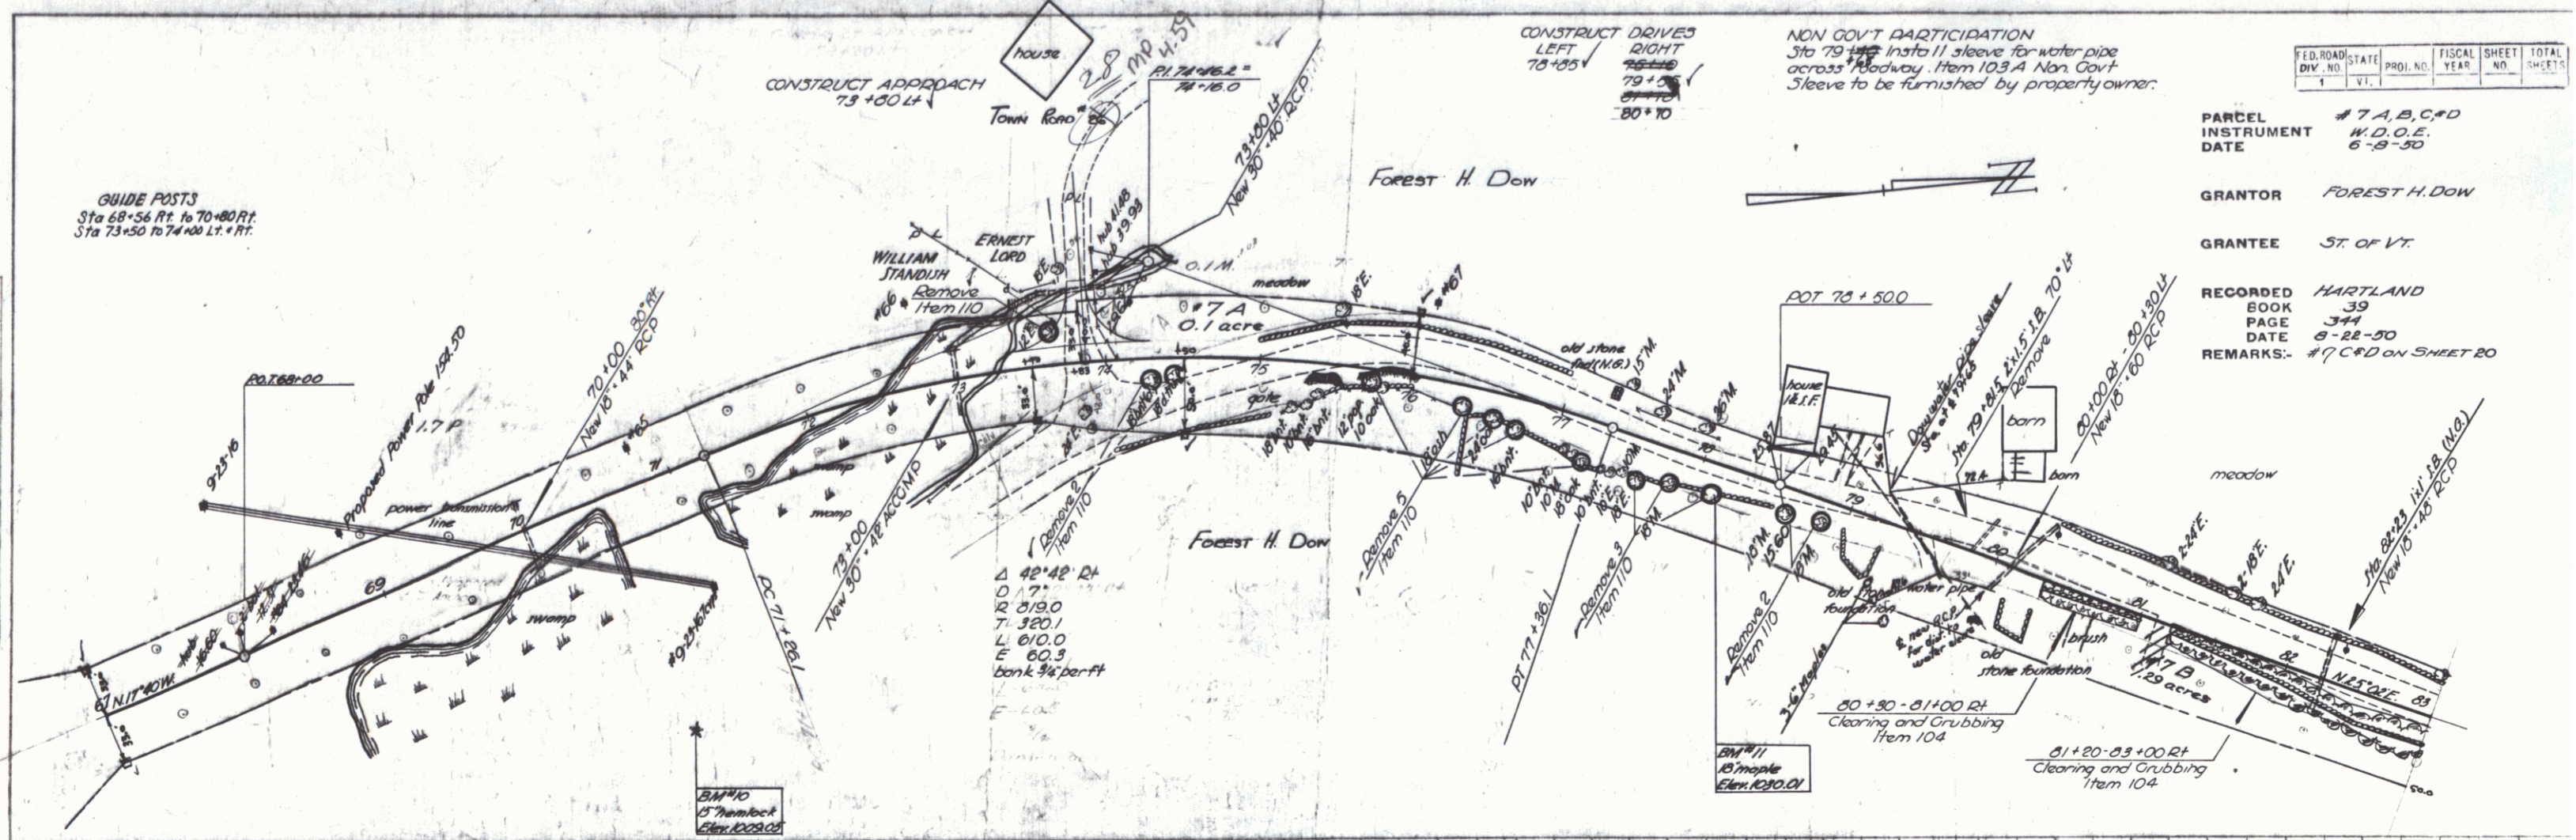

FED. ROAD DIV. NO.	STATE	PROJ. NO.	FISCAL YEAR	SHEET NO.	TOTAL SHEETS
1	VT.				

PARCEL INSTRUMENT # 7 A, B, C, D
DATE W.D.O.E. 6-8-50
GRANTOR FOREST H. DOW
GRANTEE ST. OF VT.
RECORDED HARTLAND BOOK 39 PAGE 344 DATE 8-22-50
REMARKS: #1 C&D ON SHEET 20