



PLAN
 DATE: 8-22-50
 DRAWN BY: [Signature]
 CHECKED BY: [Signature]
 TITLE: [Title]

PROFILE
 DATE: 8-22-50
 DRAWN BY: [Signature]
 CHECKED BY: [Signature]
 TITLE: [Title]

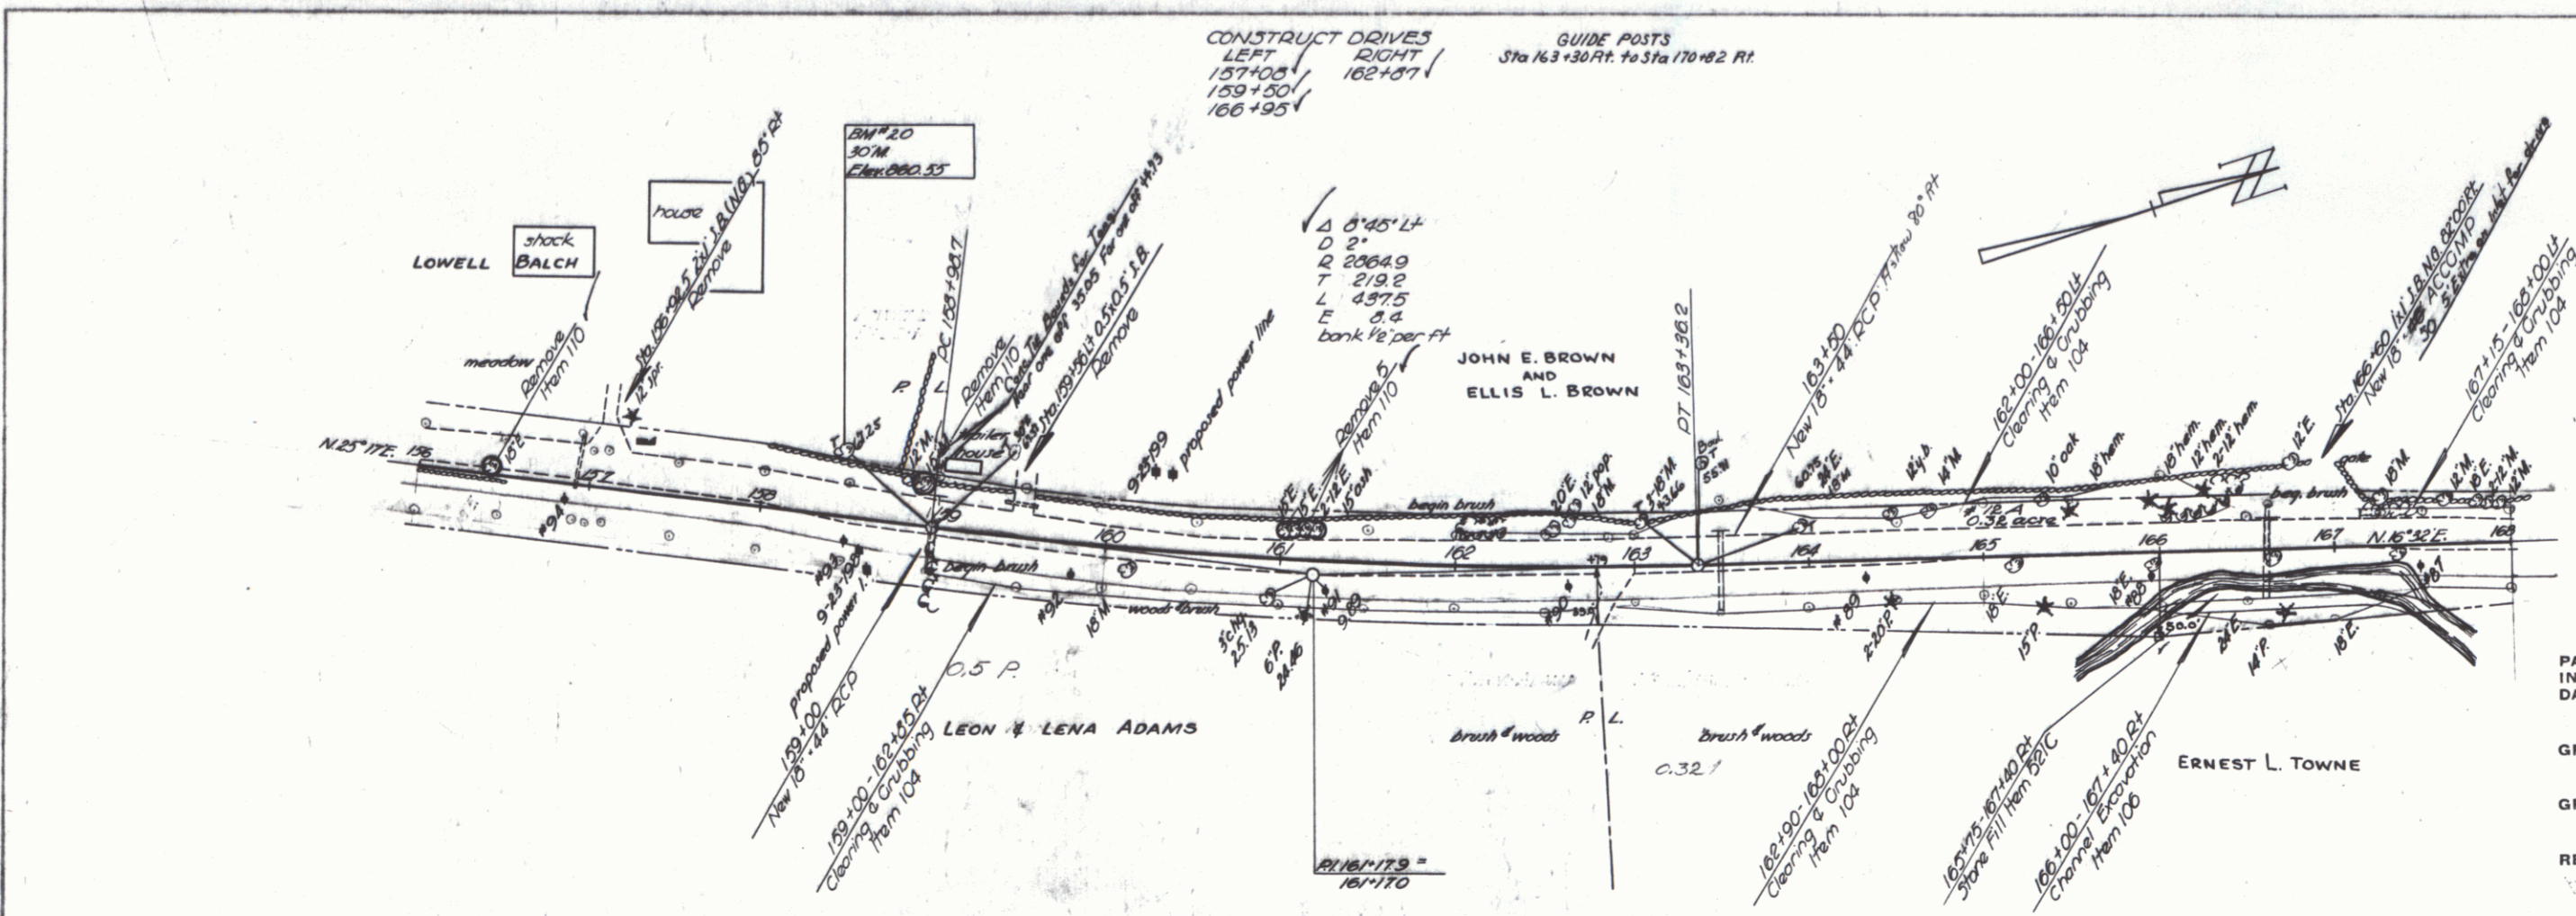

FED. ROAD DIV. NO.	STATE	PROJ. NO.	FISCAL YEAR	SHEET NO.	TOTAL SHEETS
1	VT.				

PARCEL INSTRUMENT DATE #12 A & B W.D.O.E 6-8-50
 GRANTOR ERNEST L. TOWNE
 GRANTEE ST of VT.
 RECORDED HARTLAND BOOK 39 PAGE 366 DATE 8-22-50
 REMARKS- #12 B ON SHEET 26

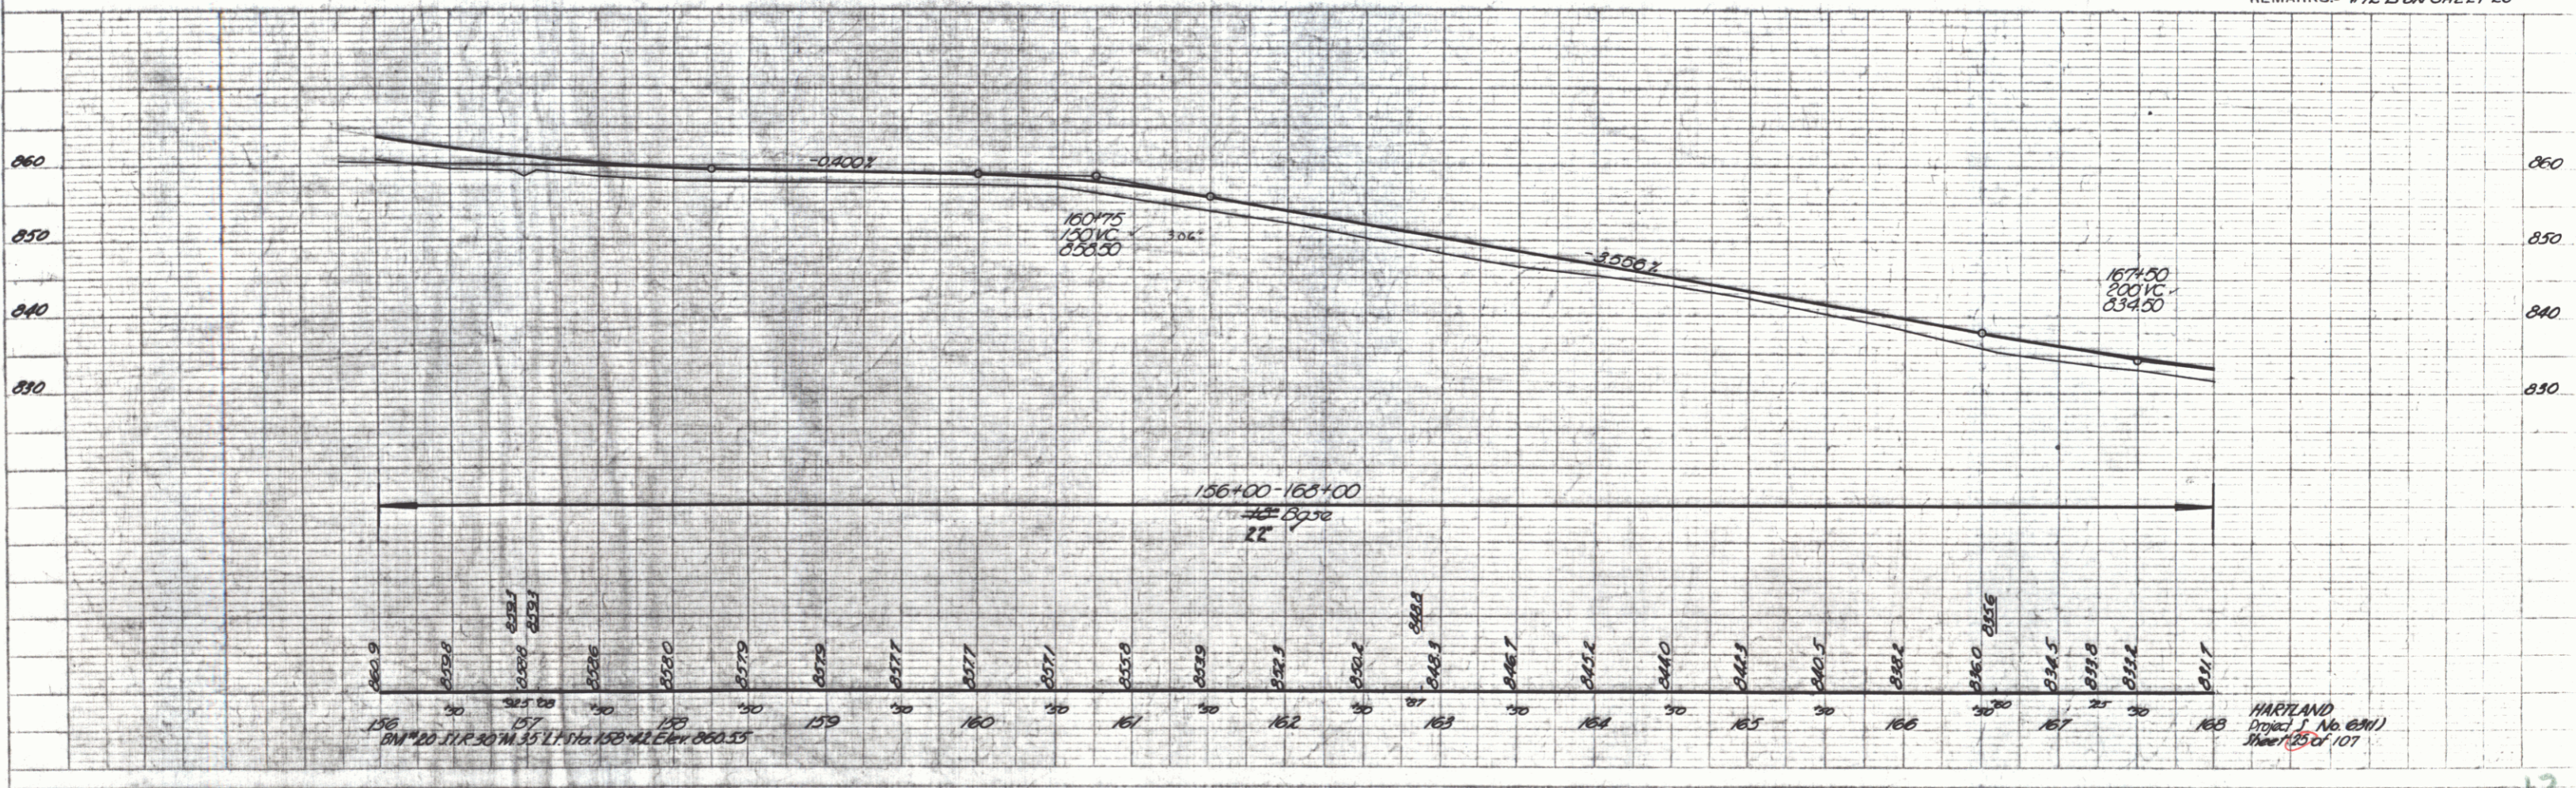

PROFILE - PLAN PROFILE - P & E - 1950

HARTLAND
 Project No. 6911
 Sheet 23 of 107