



FED. ROAD DIV. NO.	STATE	PROJ. NO.	FISCAL YEAR	SHEET NO.	TOTAL SHEETS
1	Vt.				

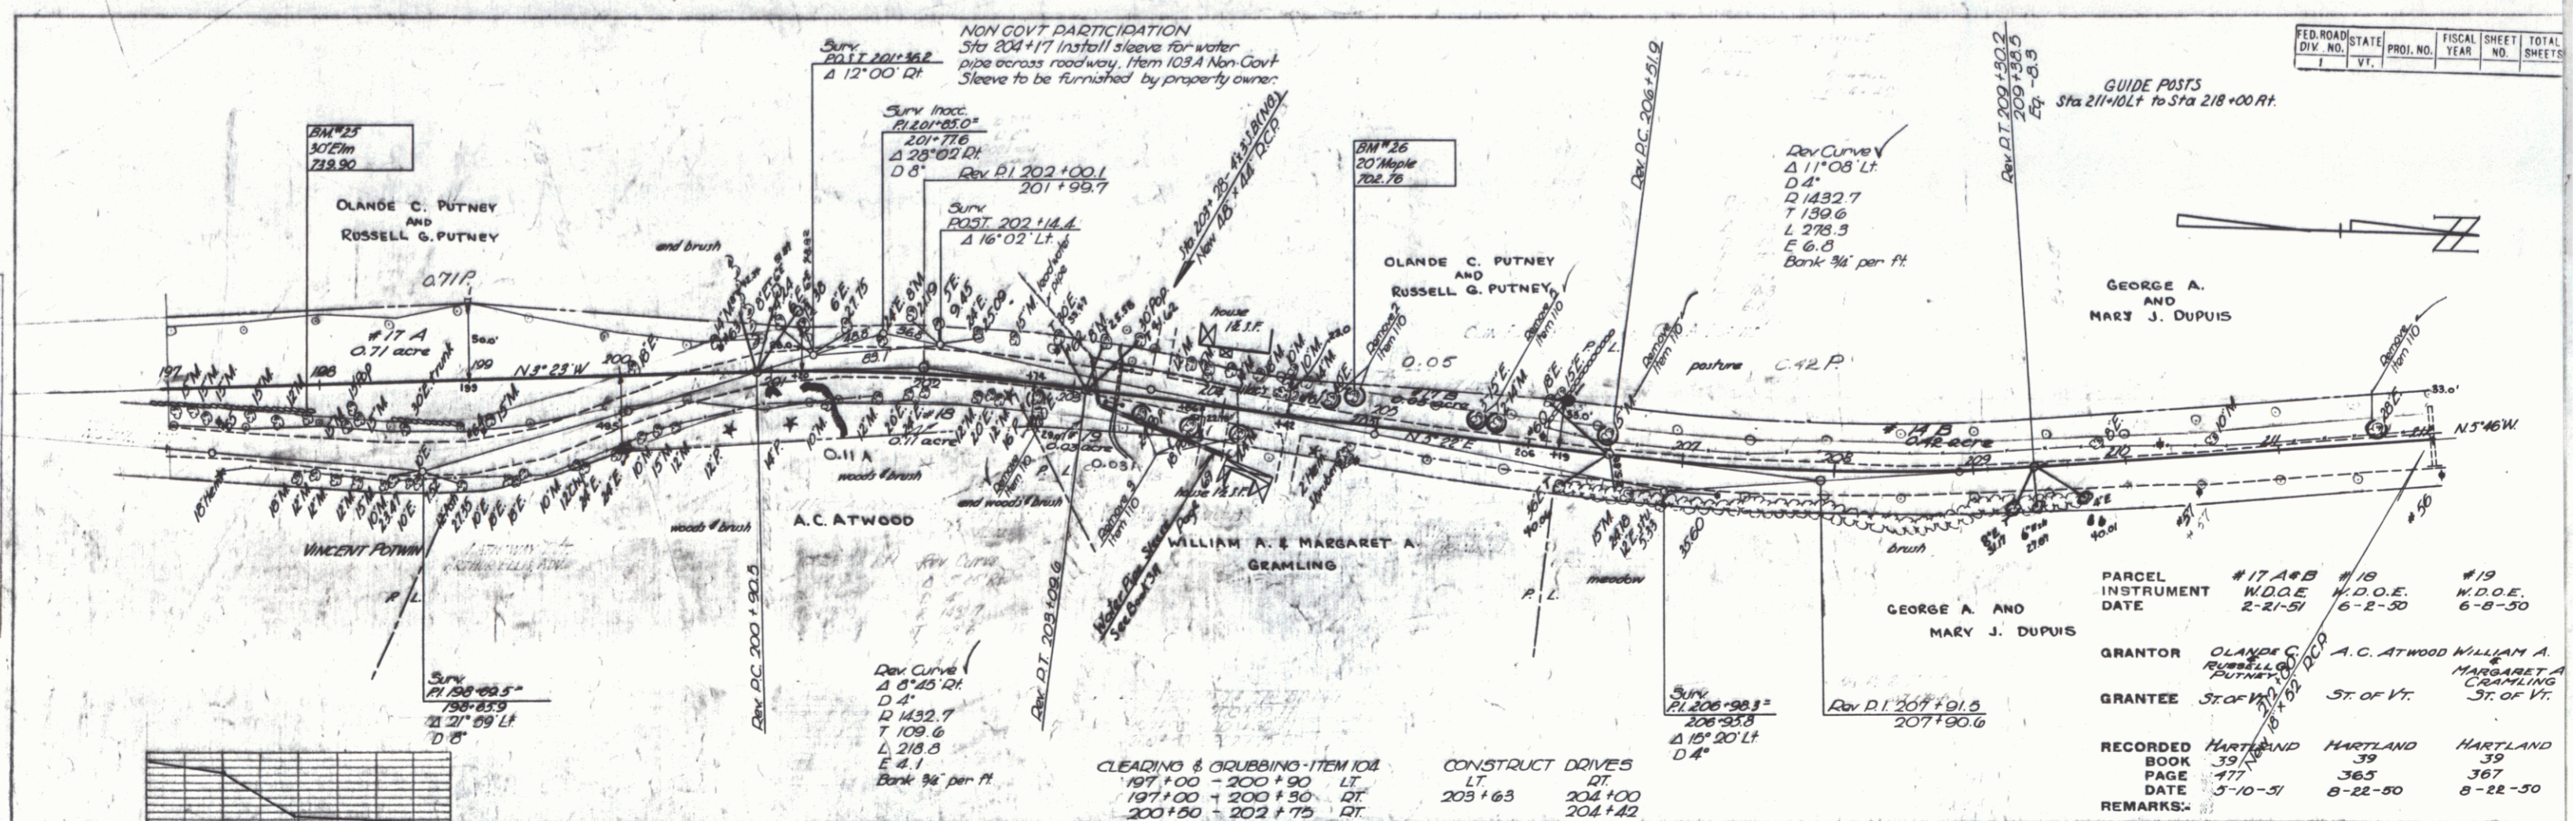

PARCEL INSTRUMENT DATE	#17 A+B W.D.O.E. 2-21-51	#18 W.D.O.E. 6-2-50	#19 W.D.O.E. 6-8-50
GRANTOR	OLANDE C. PUTNEY & RUSSELL G. PUTNEY	A.C. ATWOOD	WILLIAM A. & MARGARET A. GRAMLING
GRANTEE	ST. OF VT.	ST. OF VT.	ST. OF VT.
RECORDED BOOK DATE	HARTLAND 39/37 5-10-51	HARTLAND 39/365 8-22-50	HARTLAND 39/367 8-22-50
REMARKS:			

CLEANING & GRUBBING-ITEM 104
197+00 - 200+90 LT
197+00 - 200+90 DT
200+80 - 202+75 DT

CONSTRUCT DRIVES
LT DT
203+63 204+00
204+42

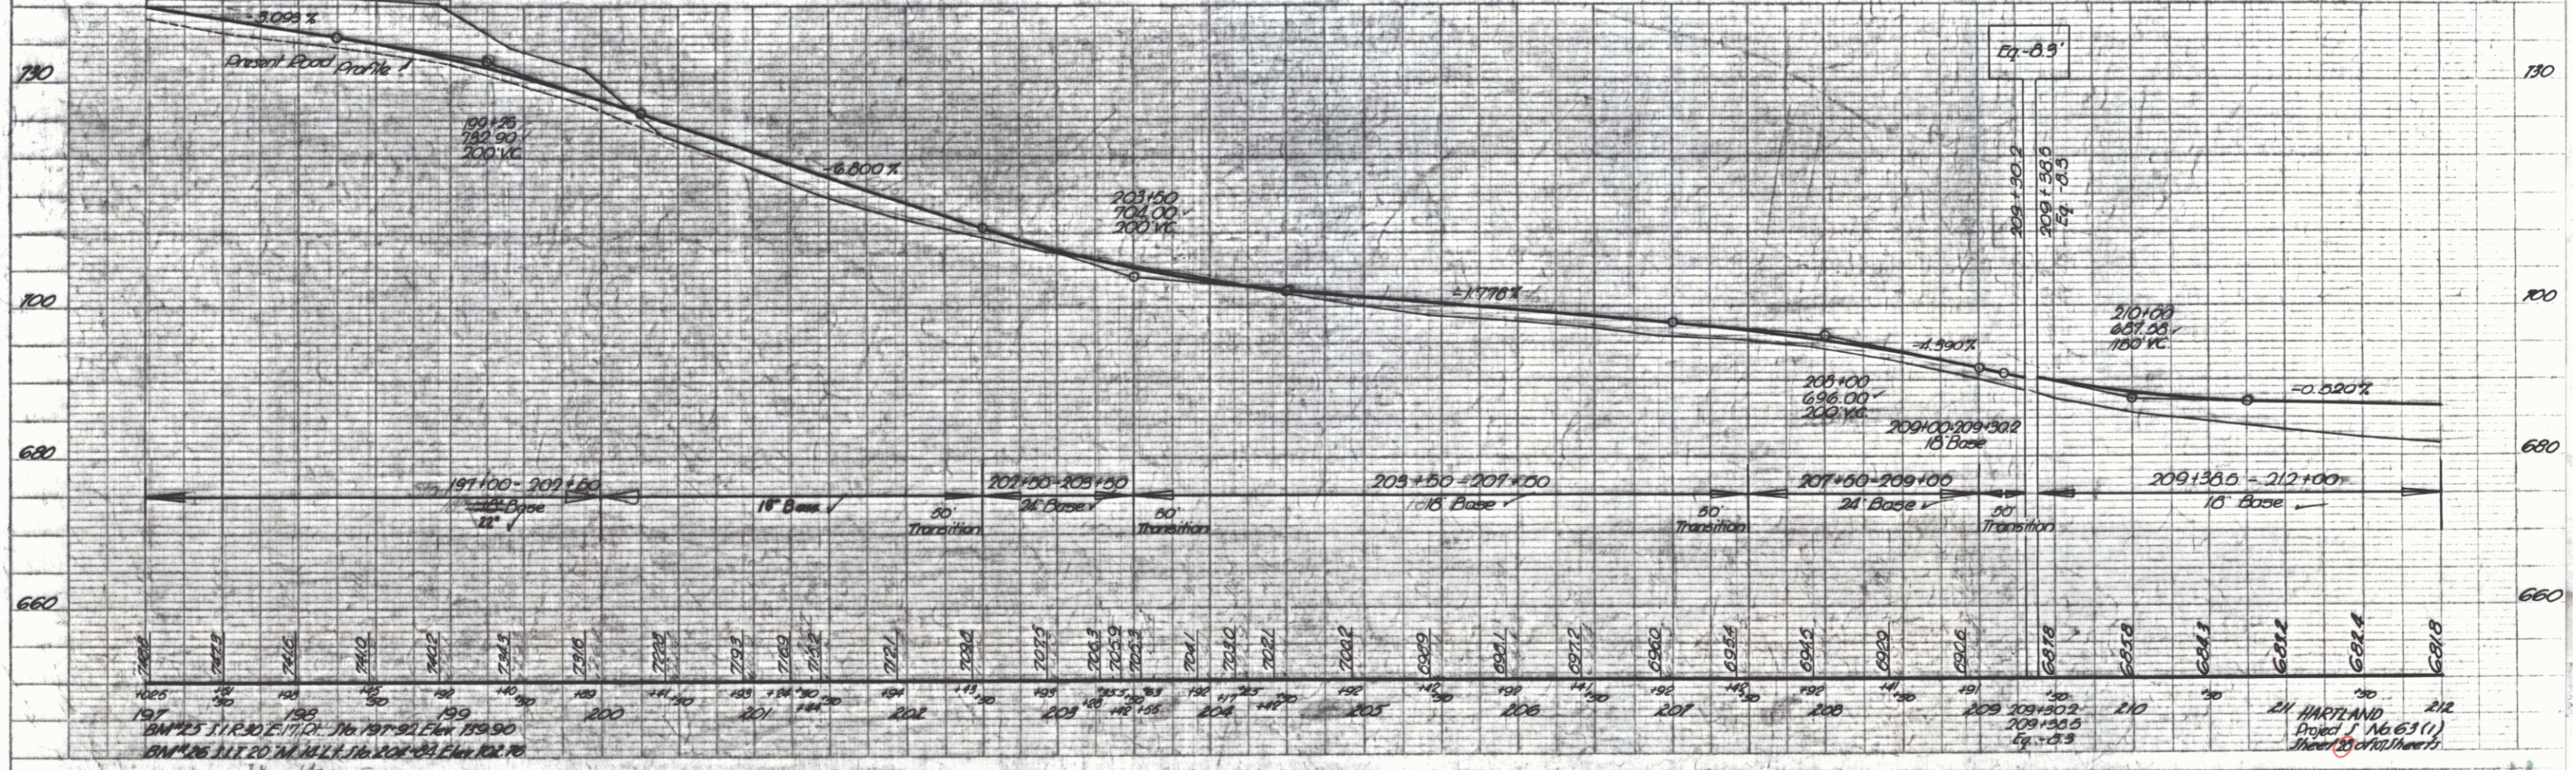

PLAN
DATE: 5/10/51
SCALE: AS SHOWN
DRAWN BY: [Signature]

PROFILE
DATE: 5/10/51
SCALE: AS SHOWN
DRAWN BY: [Signature]