



FED. ROAD DIV. NO.	STATE	PROJ. NO.	FISCAL YEAR	SHEET NO.	TOTAL SHEETS
1	Vt.				

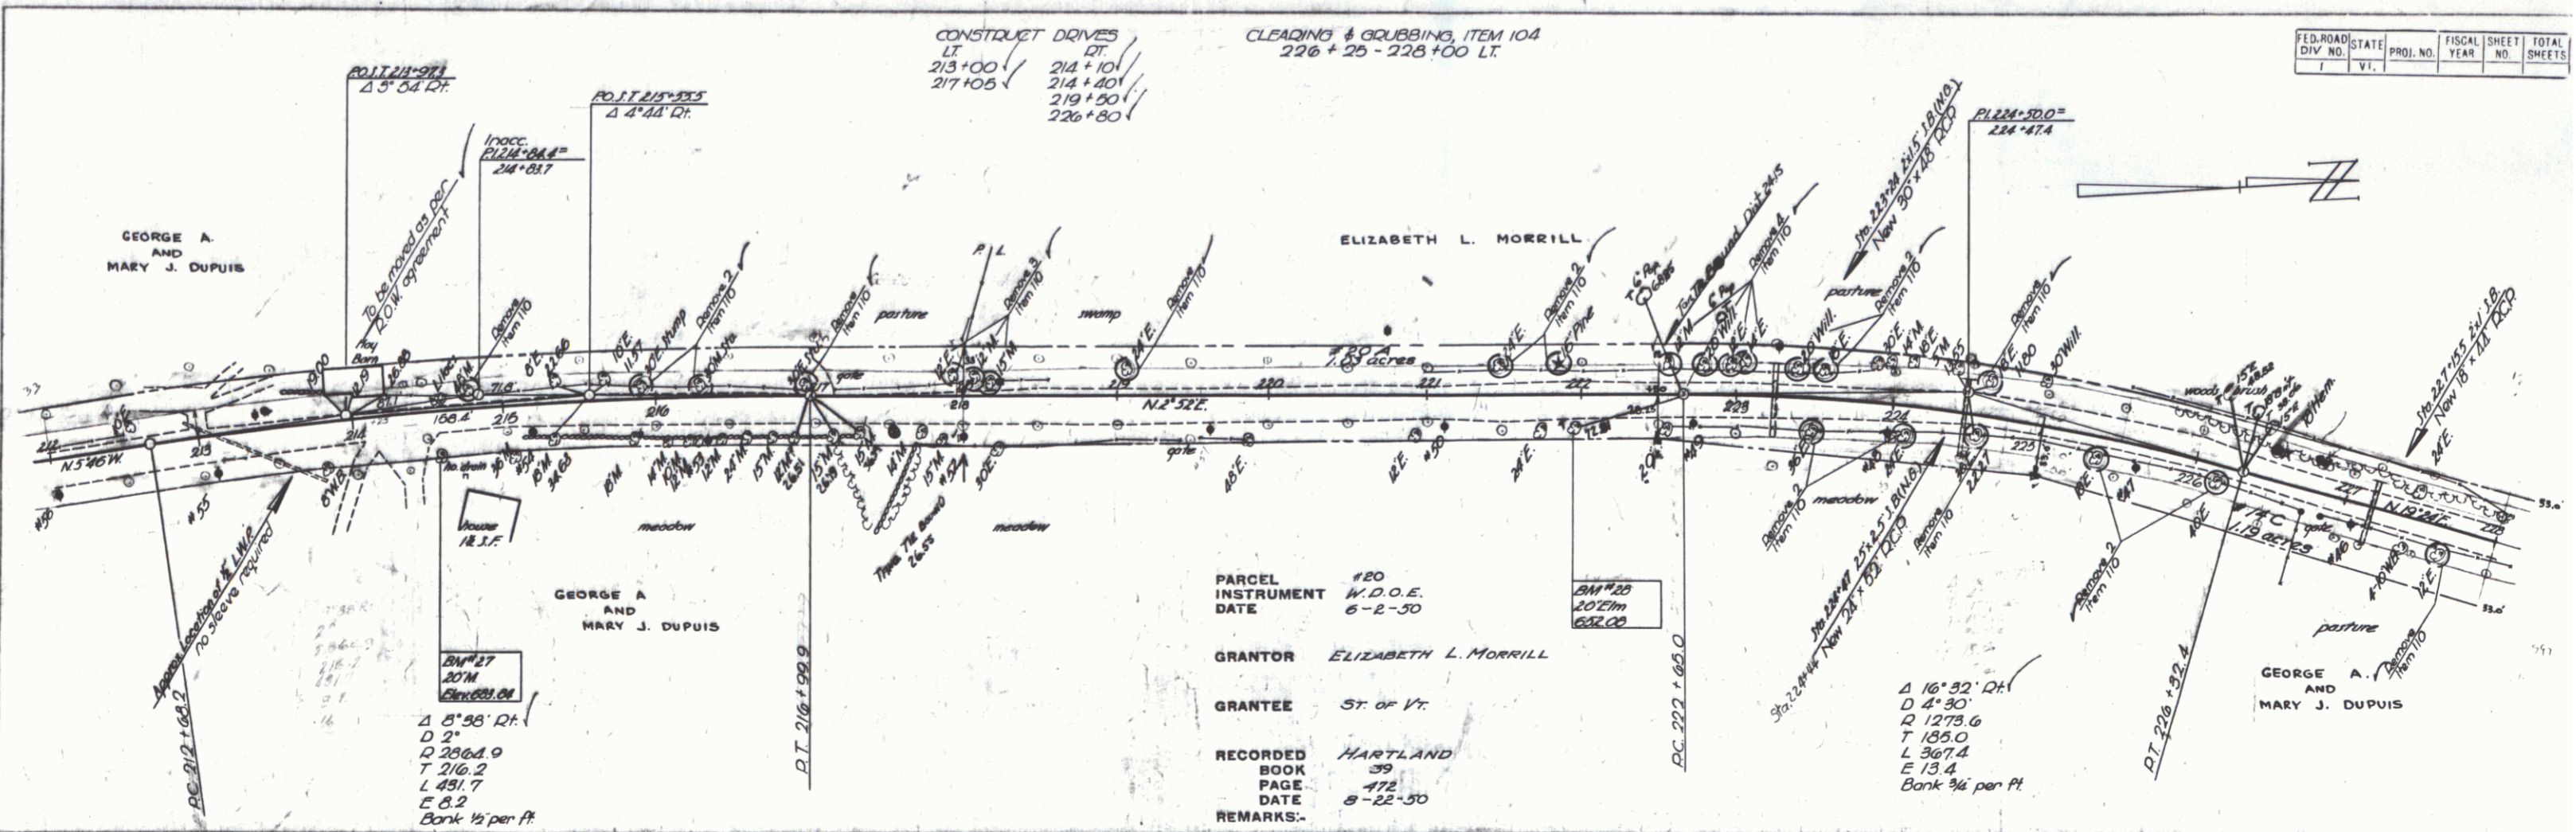

PARCEL #20
 INSTRUMENT W.D.O.E.
 DATE 6-2-30
 GRANTOR ELIZABETH L. MORRILL
 GRANTEE ST. OF VT.
 RECORDED HARTLAND
 BOOK 39
 PAGE 472
 DATE 8-22-30
 REMARKS-

BM#17
 20M
 Elev. 621.04
 Δ 5°58' RT.
 D 21
 Q 2256.0
 T 216.2
 L 451.7
 E 8.2
 Bank 1/2 per Ft.

Δ 16°32' Dt.
 D 4°30'
 R 1273.6
 T 135.0
 L 367.4
 E 13.4
 Bank 3/4 per Ft.

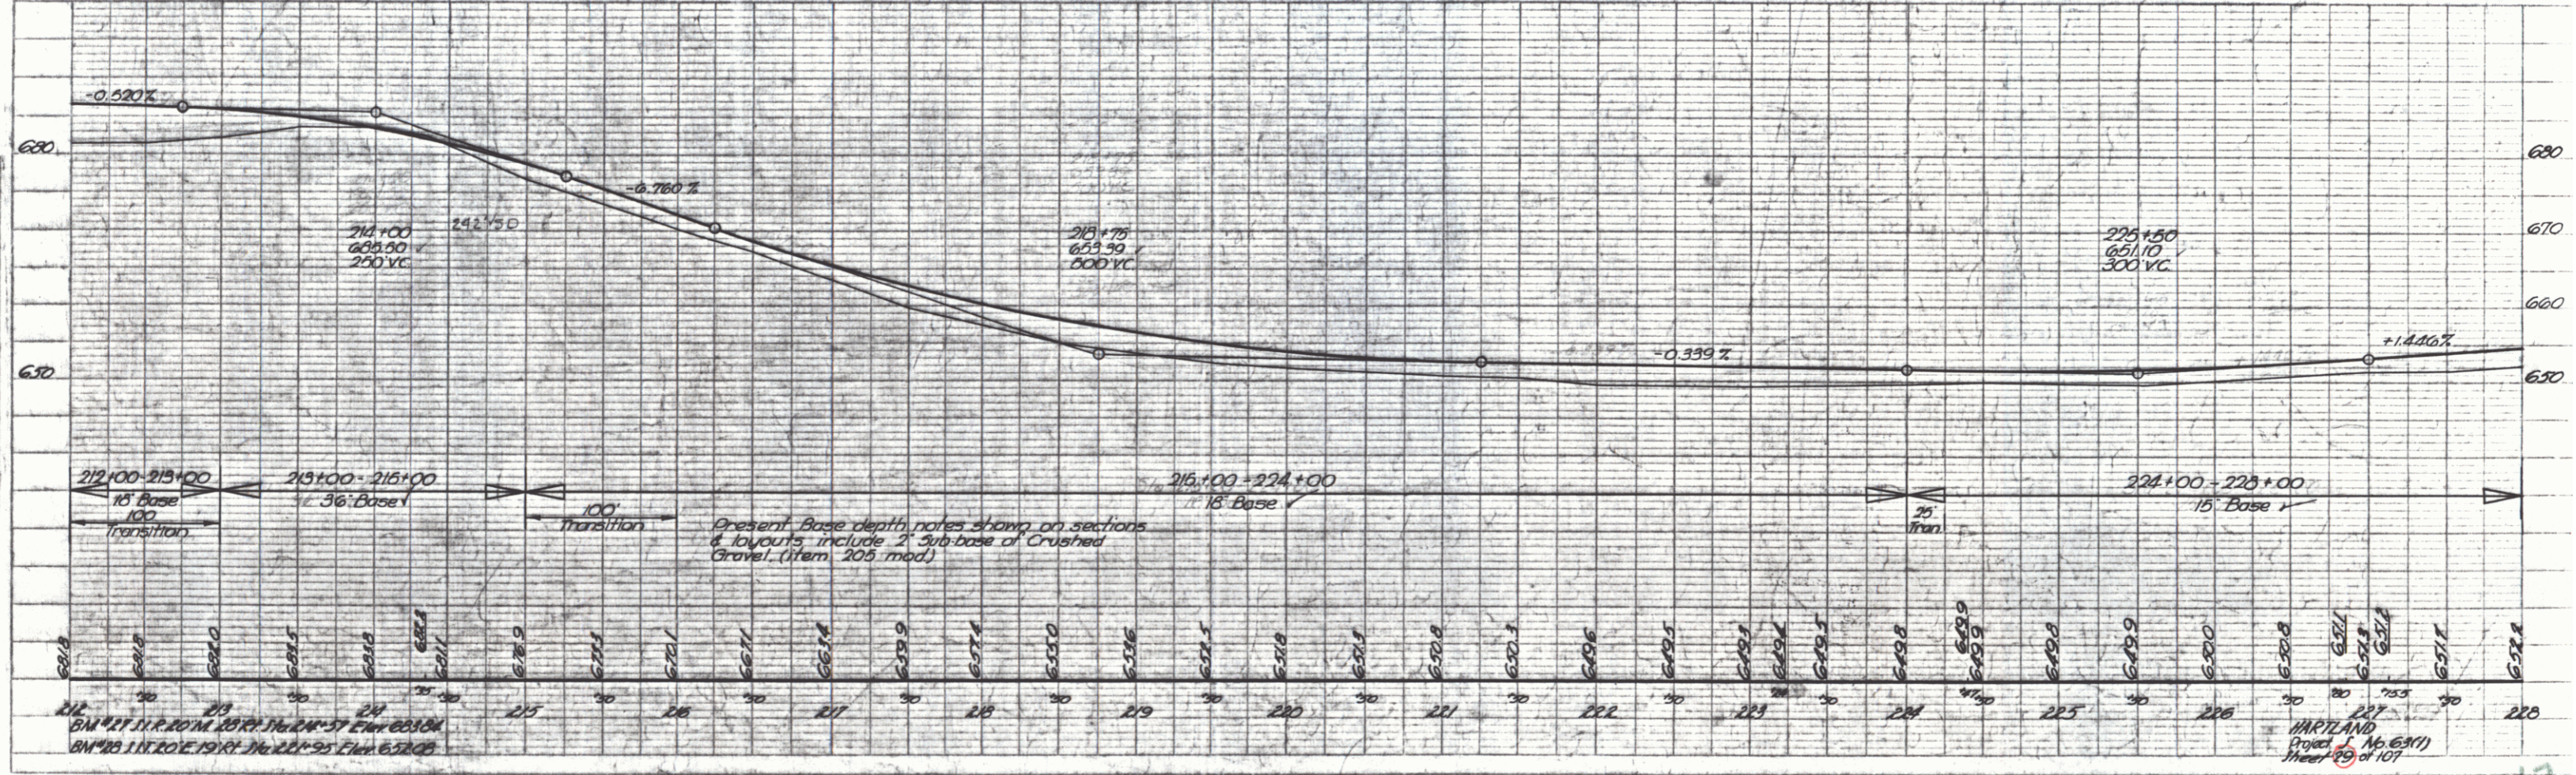

PLAN
 DATE 8/2/30
 DRAWN BY M. J. MORRILL
 CHECKED BY M. J. MORRILL
 PROJECT NO. 104

PROFILE
 DATE 8/2/30
 DRAWN BY M. J. MORRILL
 CHECKED BY M. J. MORRILL
 PROJECT NO. 104