



RIGHT-OF-WAY DIVISION
 TOWN FILE
 PERPETUAL
 Town of W. H. 12
 (To Be Returned To H.O.W. Division)

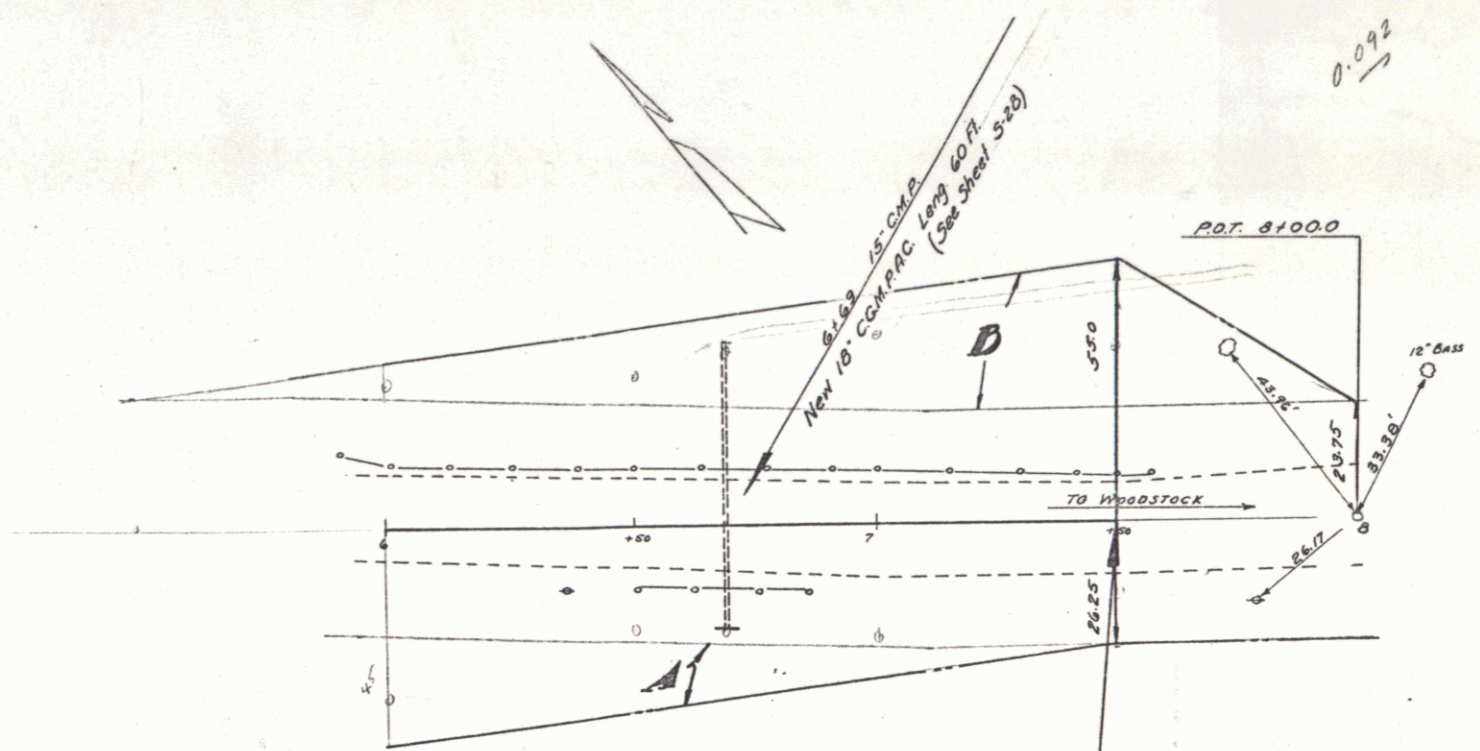

PARCEL	INSTRUMENT	DATE	GRANTOR	GRANTEE	RECORDED
A-B	Q.C.D.	4-13-38	ARCHIE HARLOW	STOP VT. 47	BOOK 21 PAGE 213

STA 7+50
 END OF STATE PROJECT 233-L

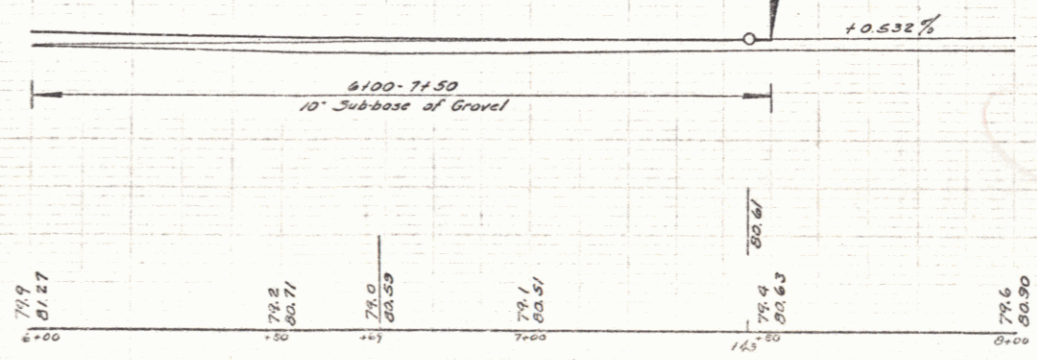

PROSPER BRIDGE
 VT ROUTE #12
 WOODSTOCK, VT.
 STATE 233-L