


BARRETT  
SALLEY  
7/26  
7/36  
Parcel Survey

BARRETT  
SALLEY  
7/26  
7/36



PARCEL	INSTRUMENT	DATE	GRANTOR	GRANTEE	RECORDED	REMARKS
A-B-C	Q.C.D.	3-26-37	MARGARET KOENIG	ST. OF VT.	272	BOOK PAGE DATE
A-B	Q.C.D.	3-27-37	ALTON E. HALLETT WIFE	"	272	302-301-22-37

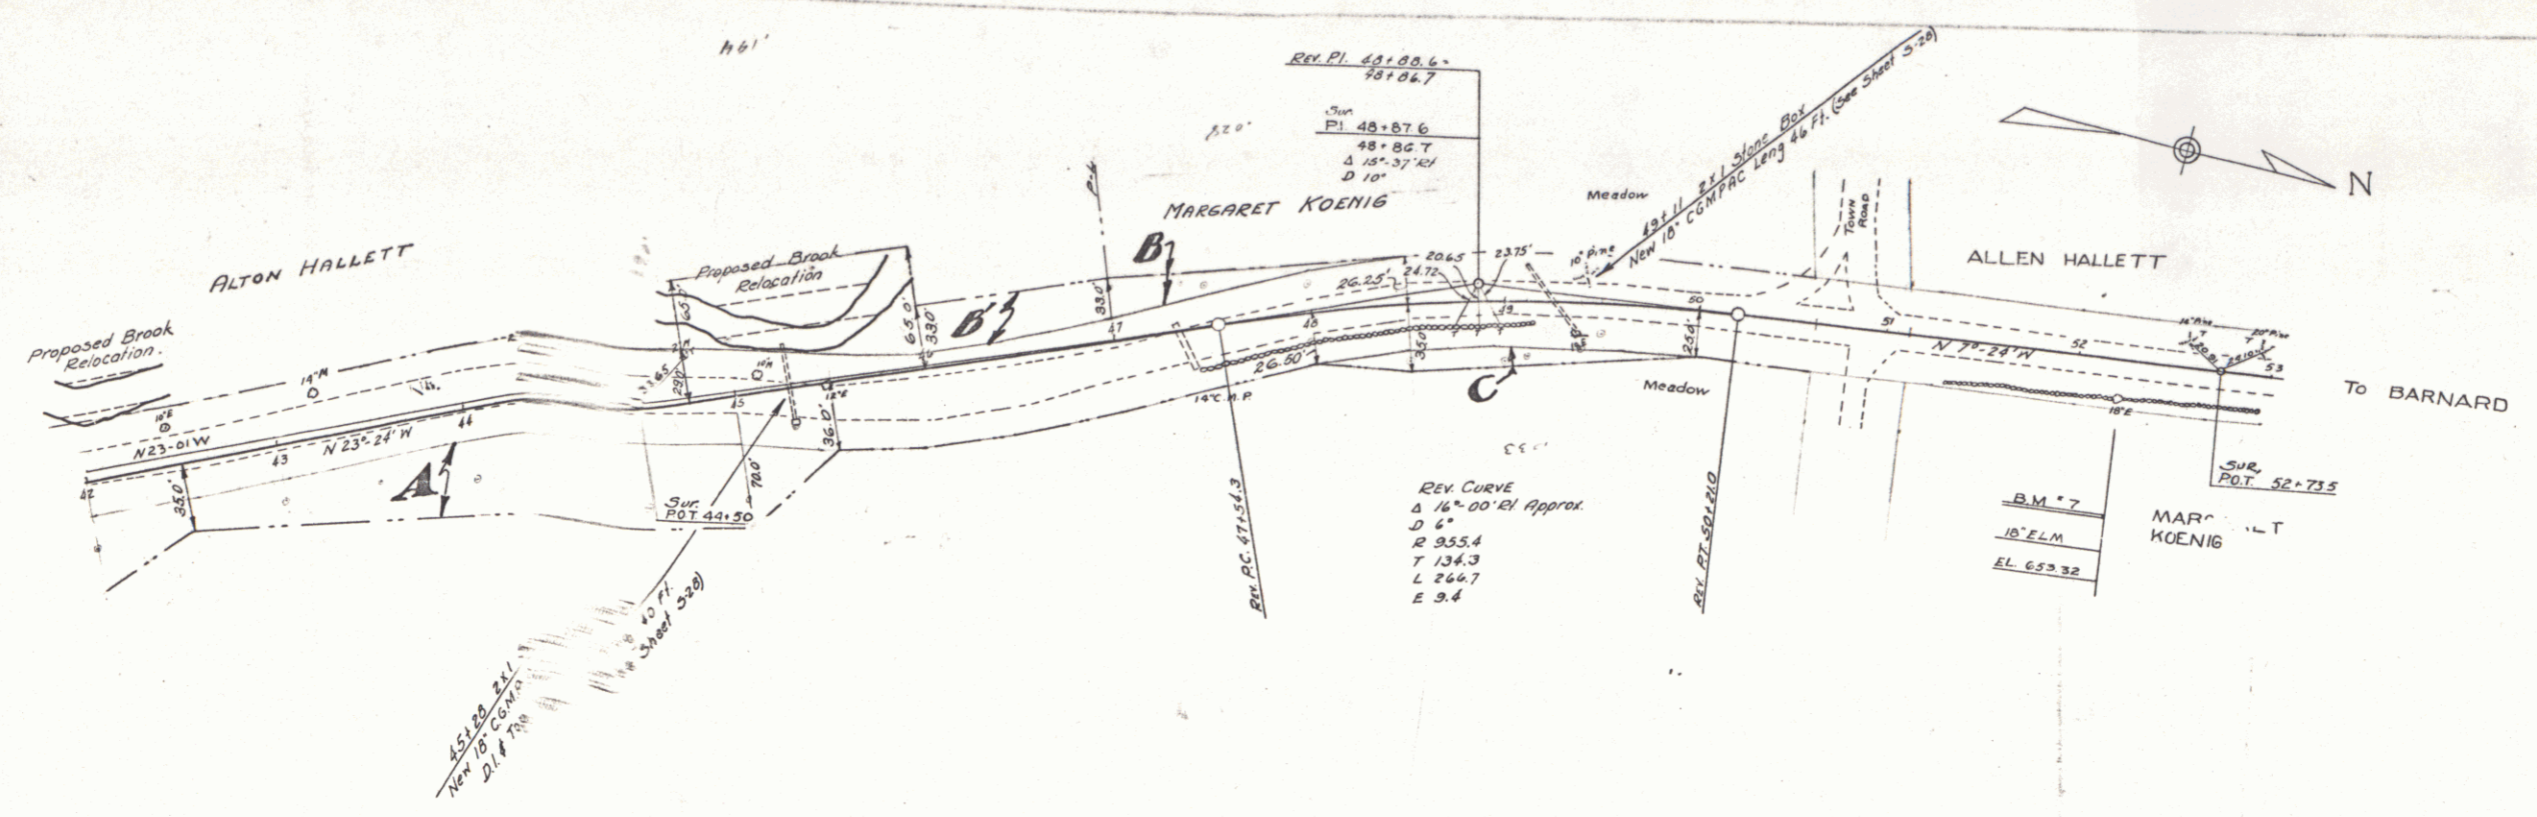