



11-48  
11-49  
11-50  
11-51  
11-52  
11-53  
11-54  
11-55  
11-56  
11-57  
11-58  
11-59  
11-60  
11-61  
11-62  
11-63  
11-64  
11-65  
11-66  
11-67  
11-68  
11-69  
11-70

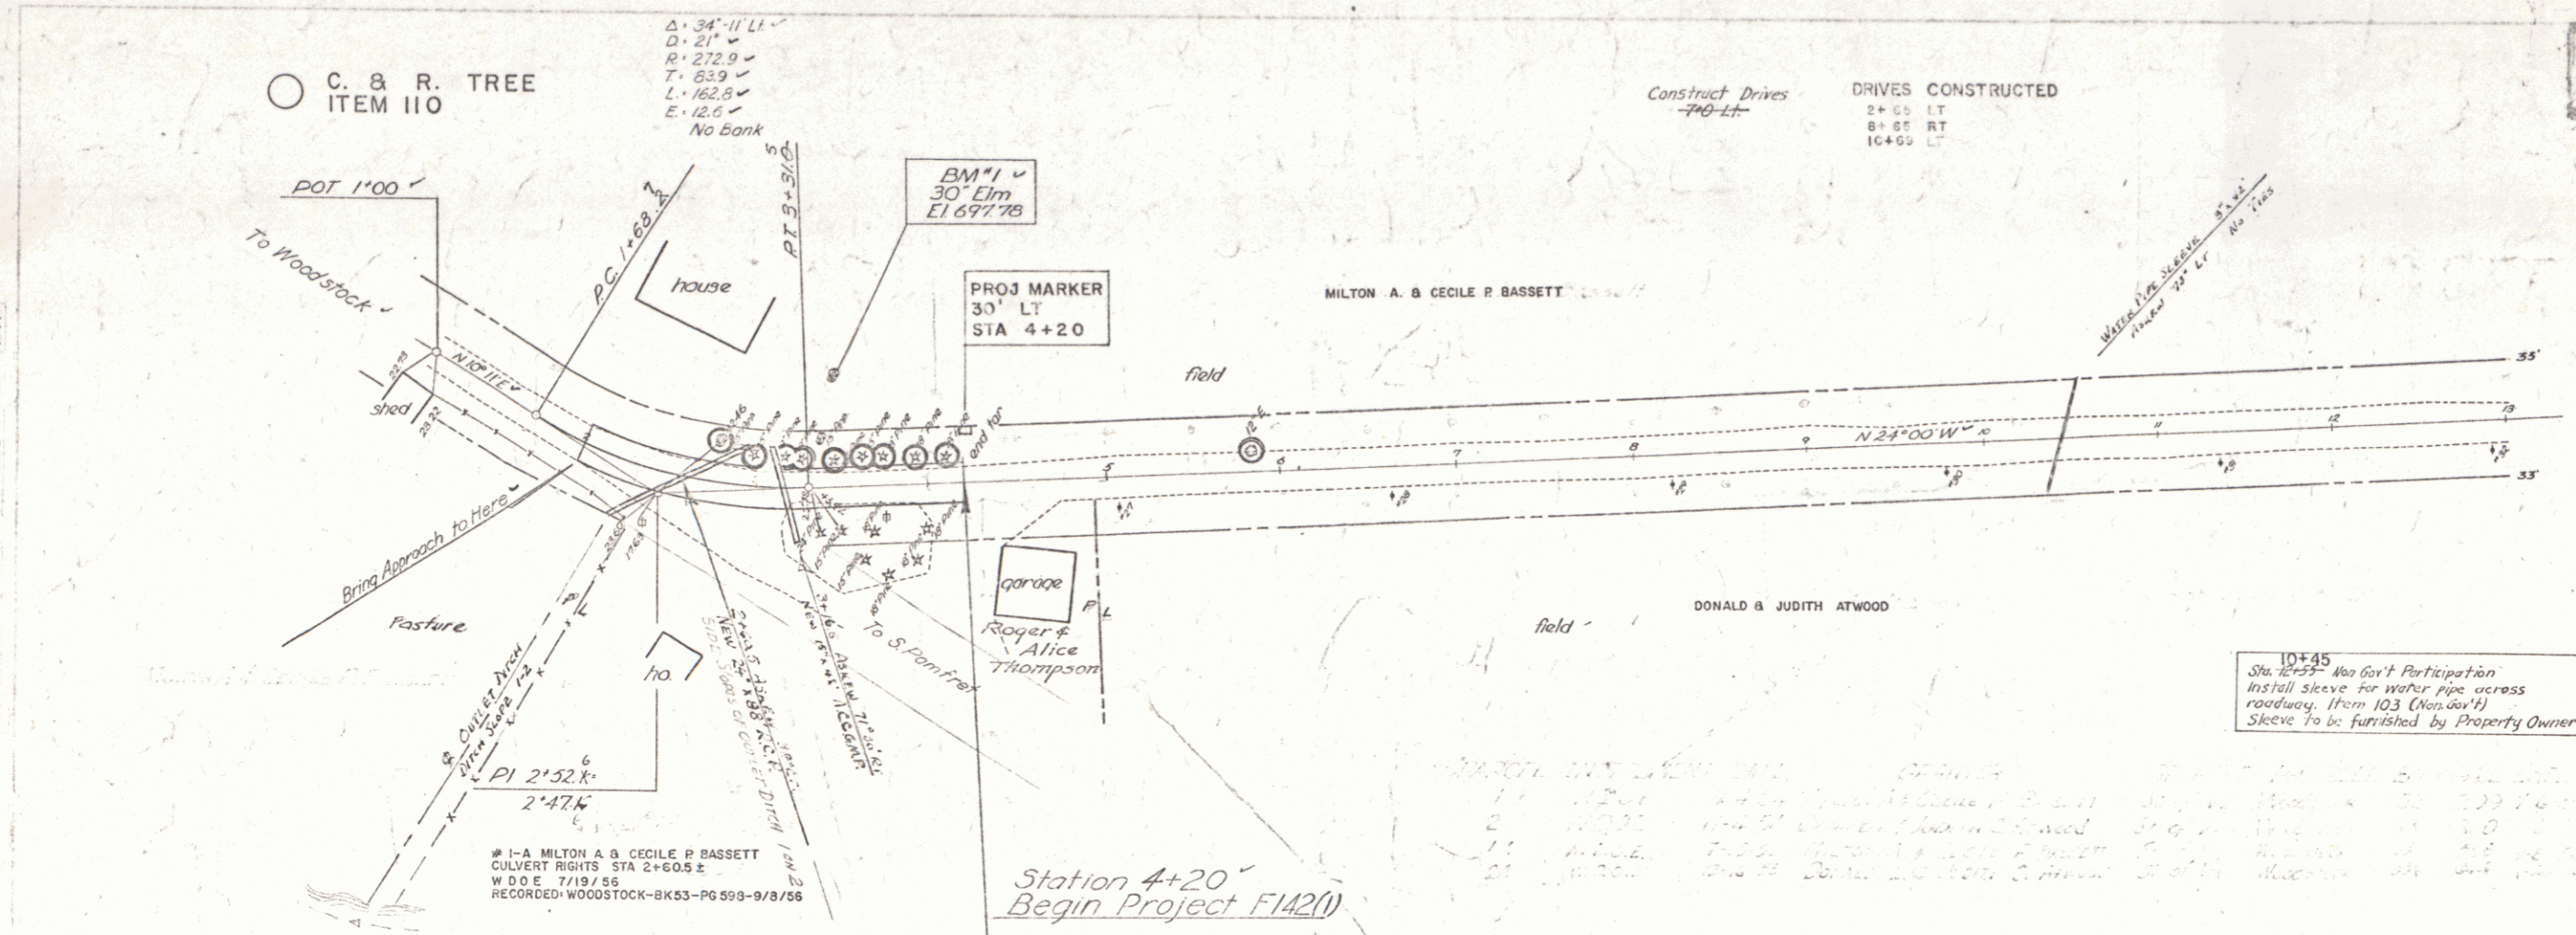

Construct Drives  
-70'-L-

DRIVES CONSTRUCTED  
2+65 LT  
8+51 RT  
10+65 LT

11-48  
11-49  
11-50  
11-51  
11-52  
11-53  
11-54  
11-55  
11-56  
11-57  
11-58  
11-59  
11-60  
11-61  
11-62  
11-63  
11-64  
11-65  
11-66  
11-67  
11-68  
11-69  
11-70

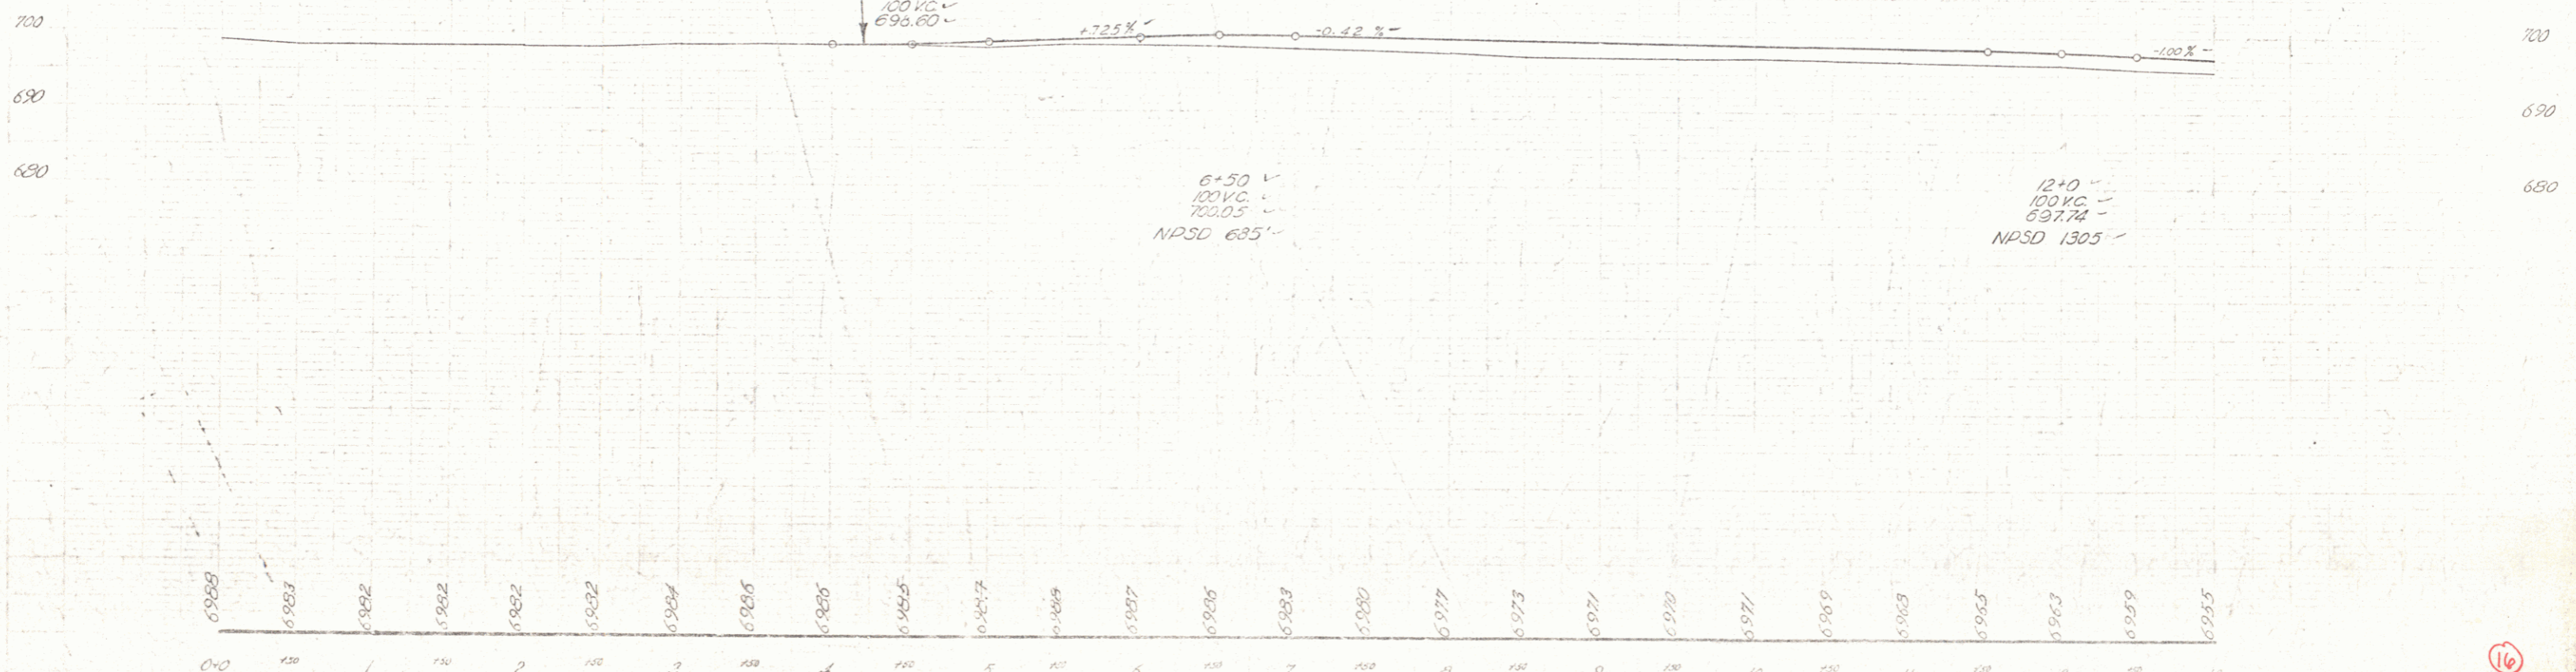

BM#1 30" Elm 64.11' of sta 3+41 Elev 697.74

10+45  
Sta. 10+55 No Gov't Participation  
Install sleeve for water pipe across  
roadway, from 103 (Sta. 98+15)  
Sleeve to be furnished by Property Owner

13 WOODSTOCK-ROXBURY BARNARD  
Series P No. 142 (1)

THE CLARKSON ENGINEERING CO.  
CONSULTING ENGINEERS  
BOSTON MASSACHUSETTS

16

2