
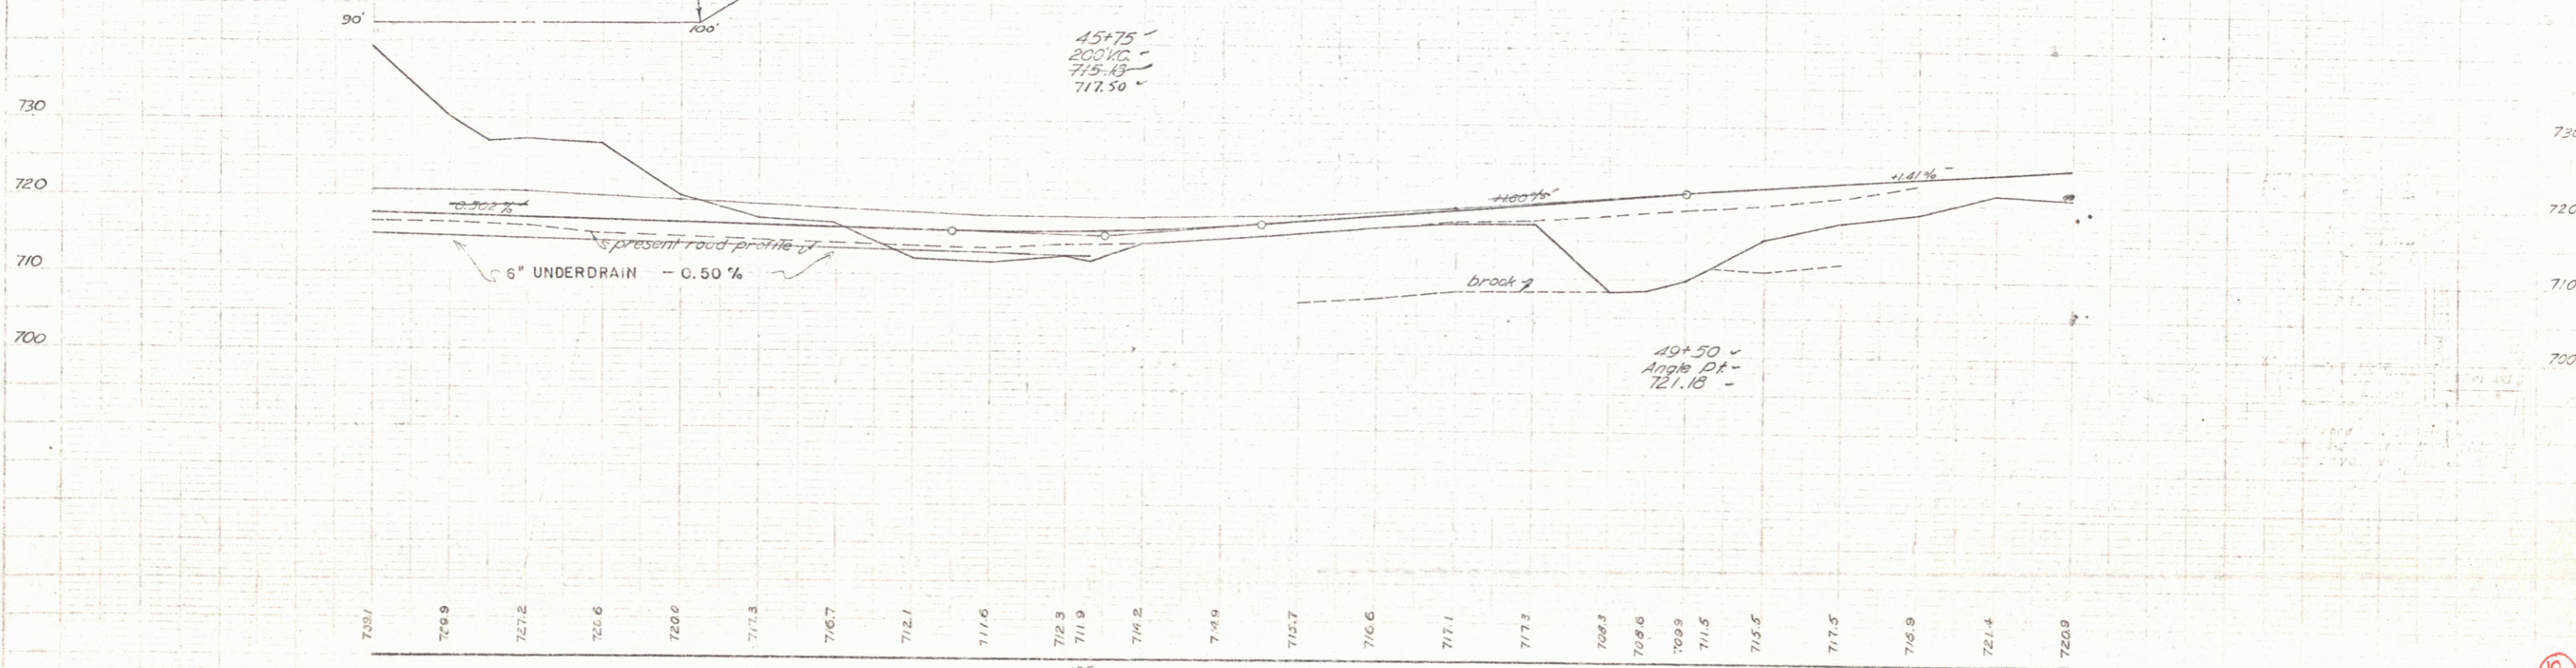


○ C. & R. TREE  
ITEM 110

PL 3130  
Δ 30° 18' RT

PL 3130  
Δ 30° 18' RT

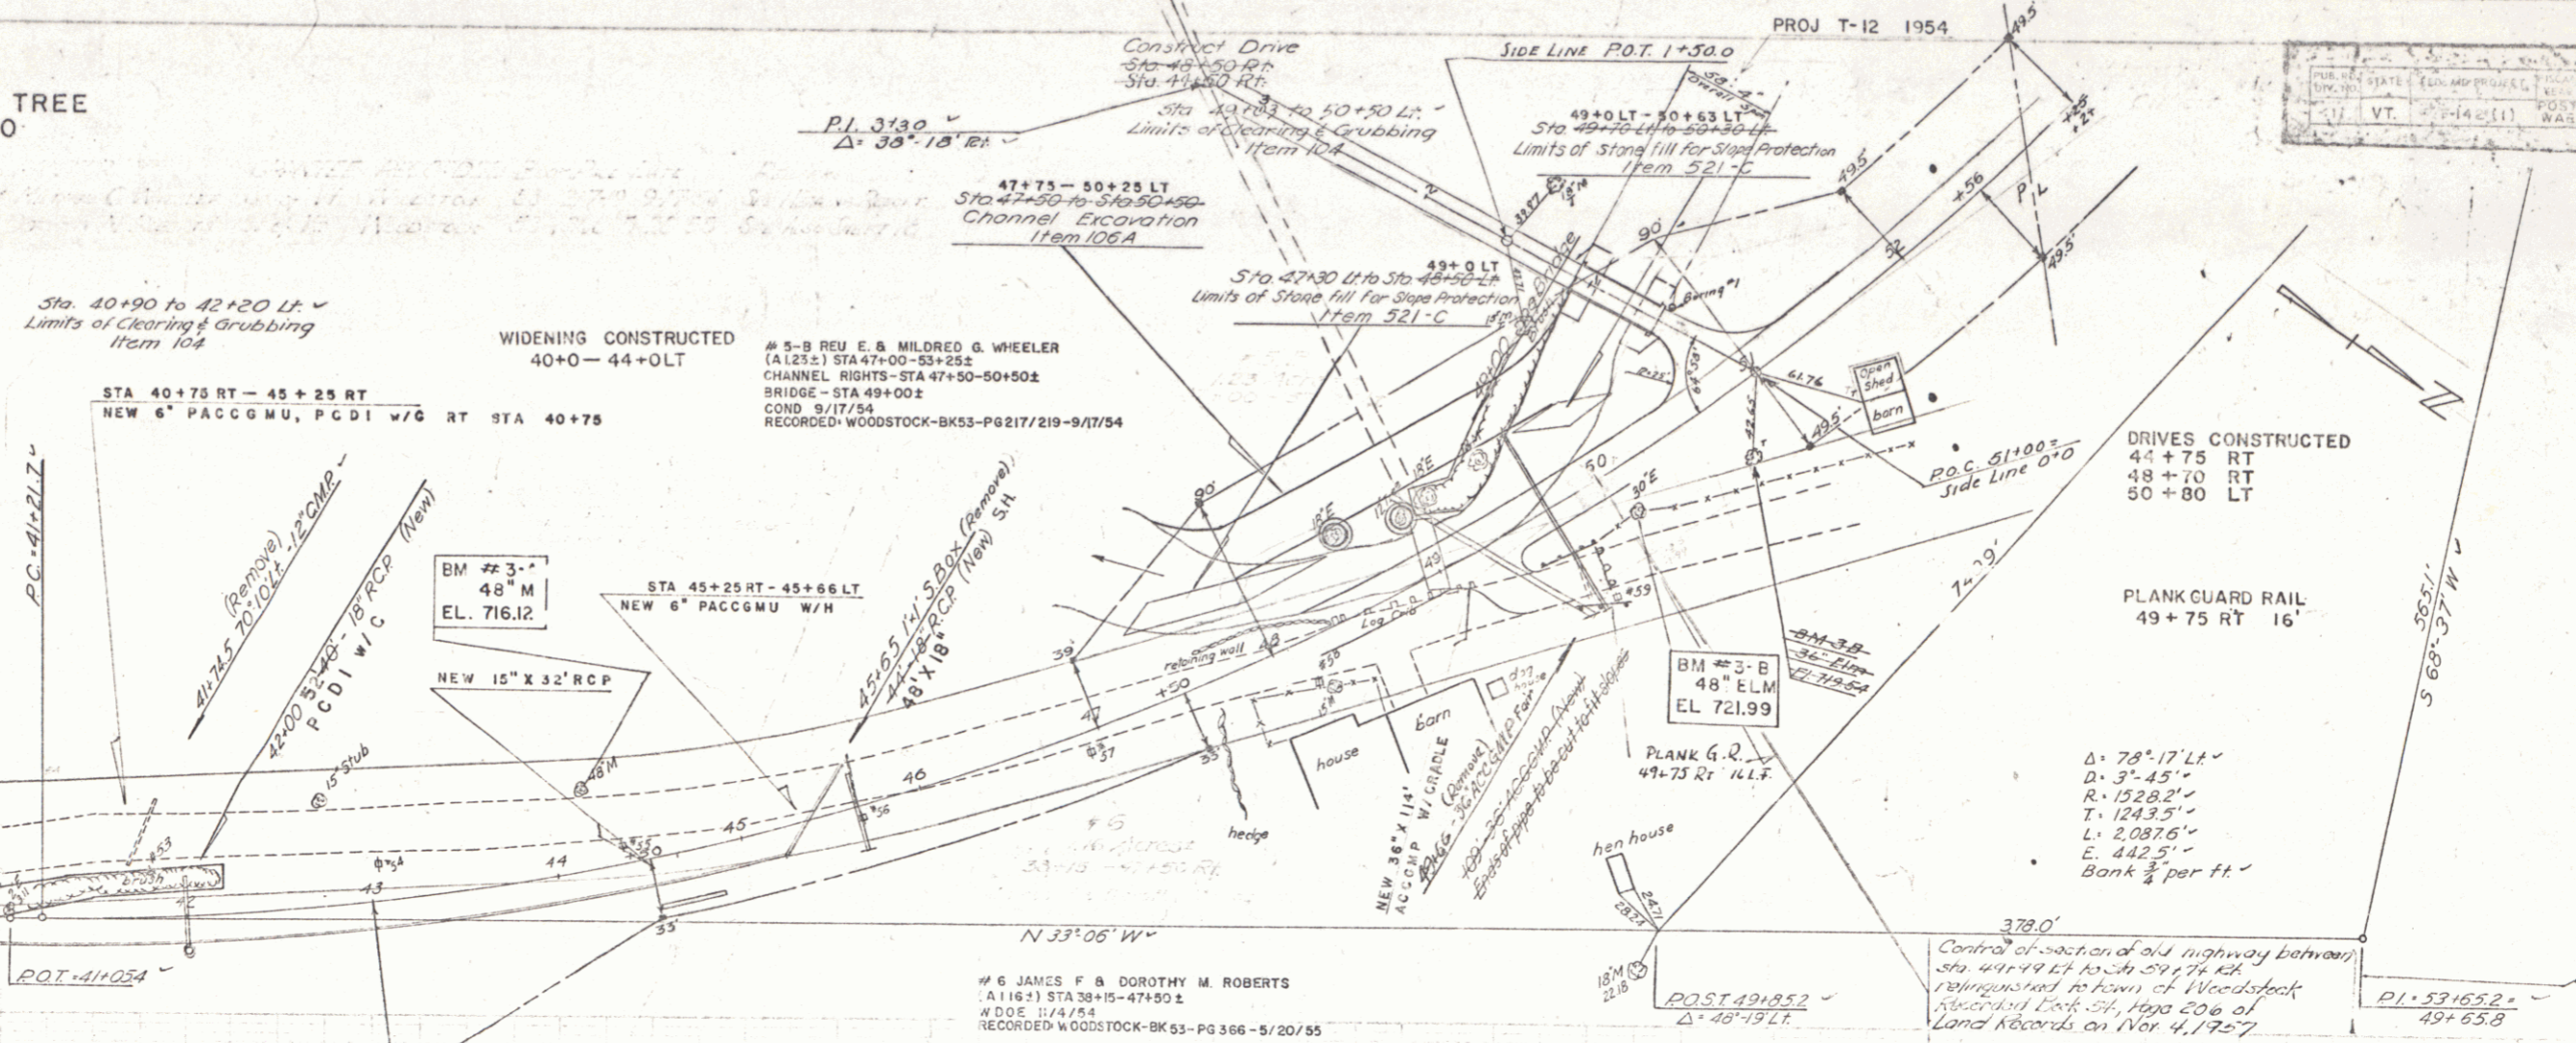

41	42	43	44	45	46	47	48	49	50	51	52
B.M. #1 SITE 45' MARK EL 716.12			B.M. #3 SITE 45' MARK EL 721.99								

WOODSTOCK-POMFRET-BARNARD

THE CLARKSON ENGINEERING CO., INC.  
CONSULTING ENGINEERS  
BOSTON MASSACHUSETTS

19

5