

#22-B CARL S. & MILDRED C. LEWIS  
 (A.O.G.B.) STA 172+50 - 182+75  
 CHANNEL RIGHTS - STA 174+50 - 182+75  
 W.D.O.E. 11/3/54  
 RECORDED - POMFRET - BK27-P6504-5/20/55

BM # 14  
 8" M  
 EL. 908.09

C. & R. TREE  
 ITEM 110

Sta 175+00 to 182+00 LT  
 Limits of Clearing & Grubbing  
 Item 104

Sta 175+00 to 182+50 LT  
 Limits of Clearing & Grubbing  
 Item 104

172+85 LT - 182+50 LT  
 Sta 177+25 to 182+50 LT  
 Limits Stone Fill for Slope Protection  
 Item 521-C

172+75 LT - 182+25 LT  
 Sta 174+50 to 182+25 LT  
 Channel Excavation  
 Item 106A

#23-C GRA C. & ESTELLE C. LEWIS  
 (A.O.G.B.) STA 181+70 - 185+00  
 CULVERT RIGHTS - STA 186+88  
 W.D.O.E. 11/12/54  
 RECORDED - POMFRET - BK27-P6503-5/20/55

#23-A GRA C. & ESTELLE C. LEWIS  
 (A.O.G.B.) STA 174+86 - 181+50  
 W.D.O.E. 11/12/54  
 RECORDED - POMFRET - BK27-P6503-5/20/55



#23-B GRA C. & ESTELLE C. LEWIS  
 (A.O.G.B.) STA 181+50 - 186+00  
 W.D.O.E. 11/12/54  
 RECORDED - POMFRET - BK27-P6503-5/20/55

WIDENING CONSTRUCTED  
 171+50 - 179+50 LT

Sta 175+00 to 185+95 R/L  
 Limits of Clearing & Grubbing  
 Item 104

PI 180+05.3  
 179+97.7

THREE CABLE GUARD RAIL w/ STEEL POSTS  
 169+83 - 185+41 LT

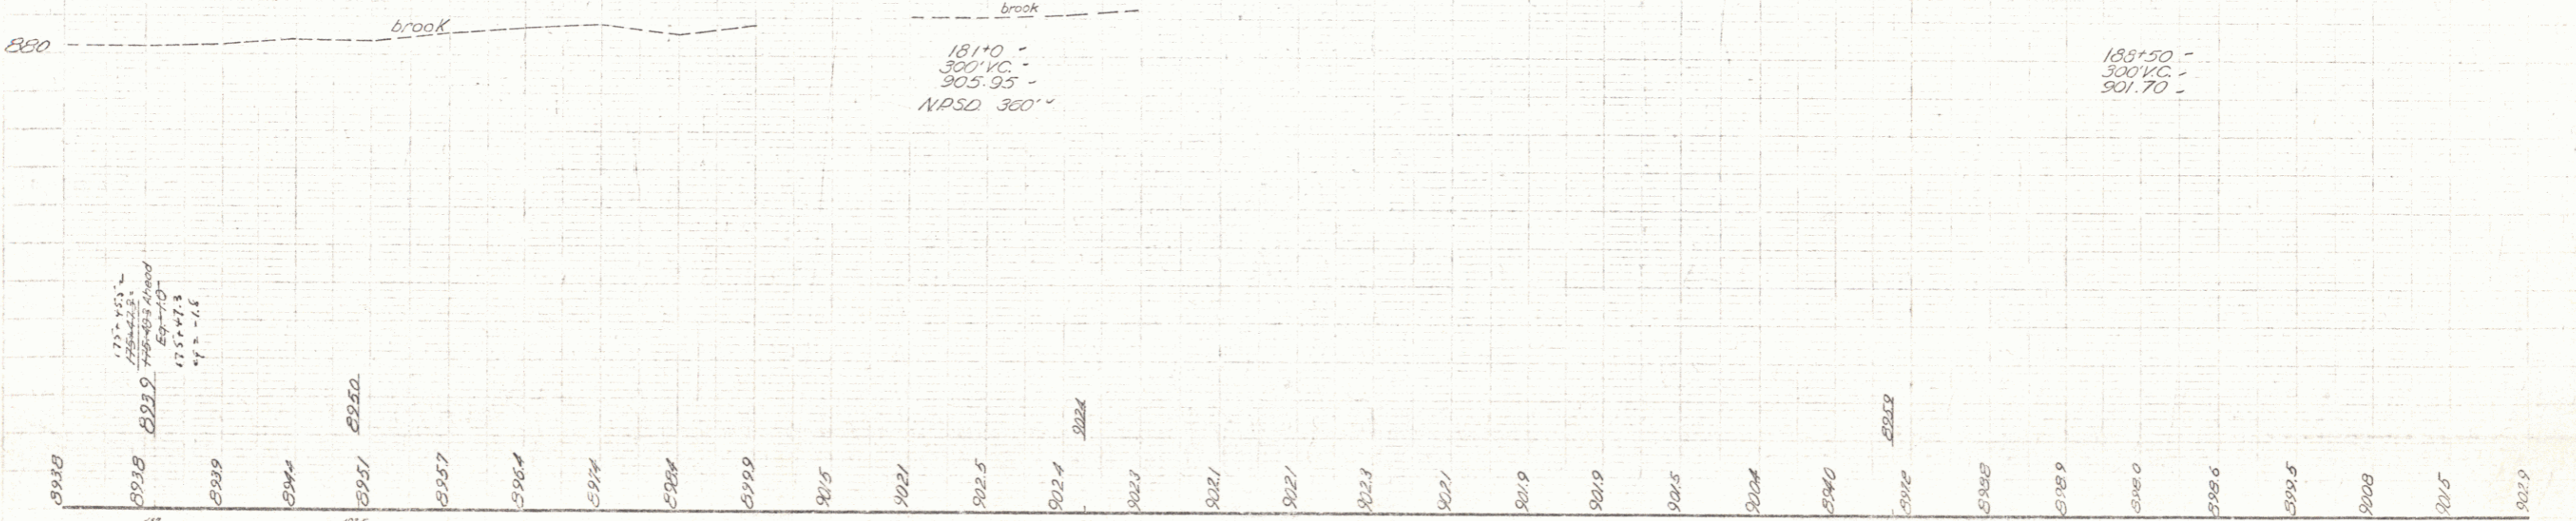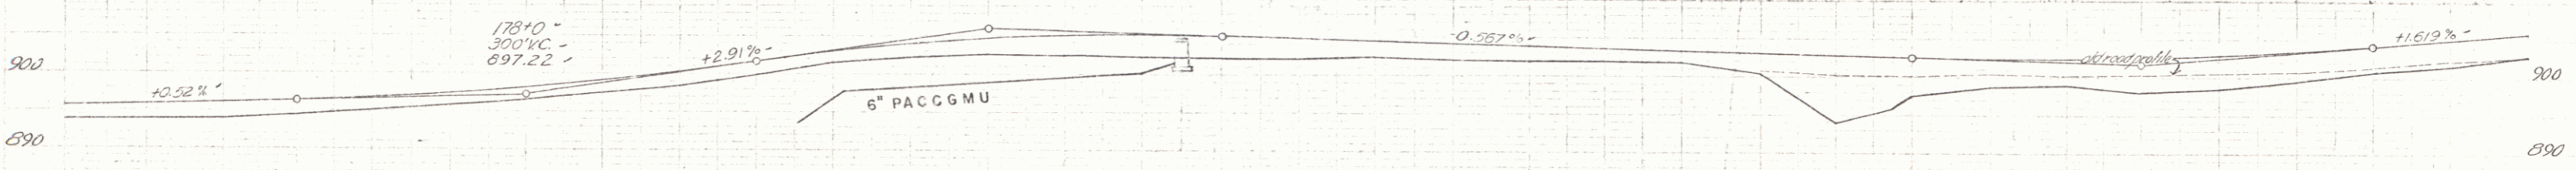

175	176	177	178	179	180	181	182	183	184	185	186	187	188	189	190	191														
893.8	893.9	893.9	894.4	895.1	895.7	896.4	897.4	898.4	899.9	901.5	902.1	902.5	902.4	902.7	902.1	902.1	902.3	902.1	901.9	901.9	902.5	902.4	899.0	898.9	898.0	898.6	899.5	900.8	901.5	902.9

WOODSTOCK POMFRET BARNARD  
 THE CLARKSON ENGINEERING CO., INC.  
 CONSULTING ENGINEERS  
 BOSTON MASSACHUSETTS