
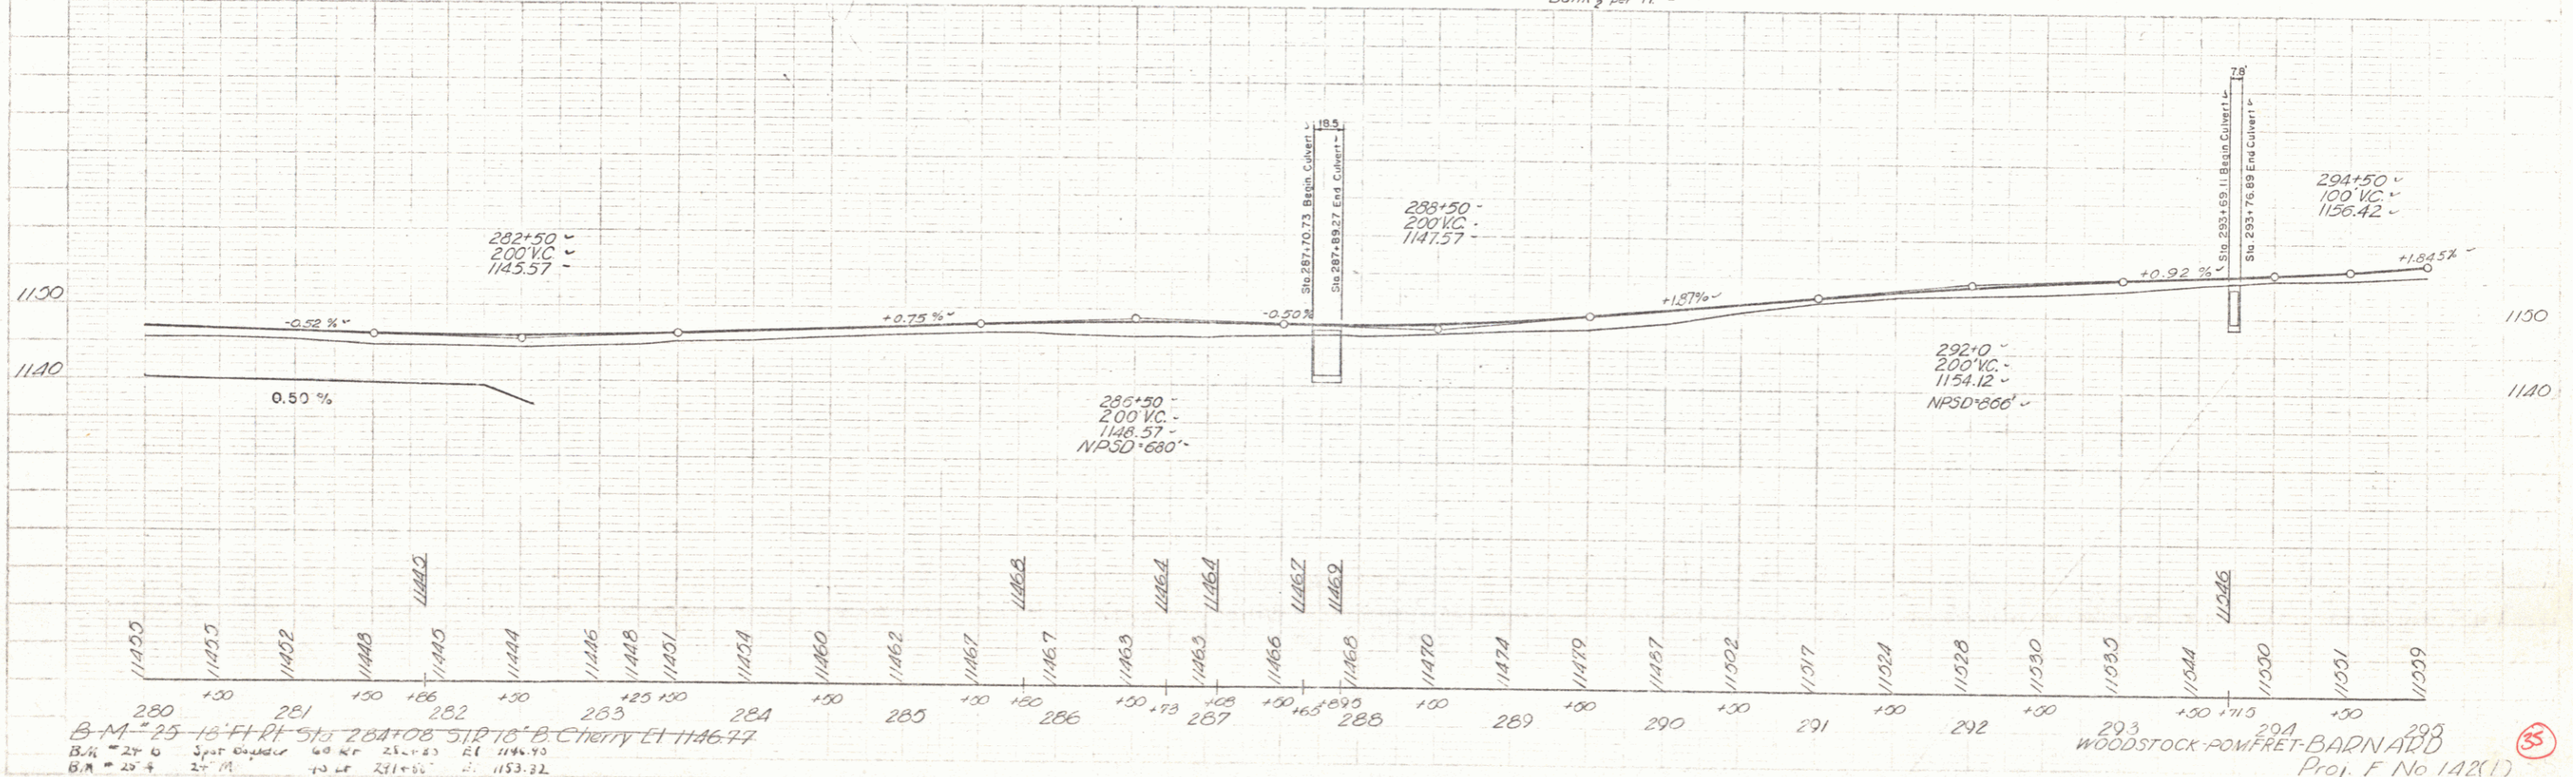


PLAN  
 DATE: 9-23  
 DRAWN BY: Z.M. Spier  
 CHECKED BY: T. Palmer  
 SCALE: 1" = 40'

PROFILE  
 DATE: 9-23  
 DRAWN BY: Z.M. Spier  
 CHECKED BY: T. Palmer  
 SCALE: 1" = 40'

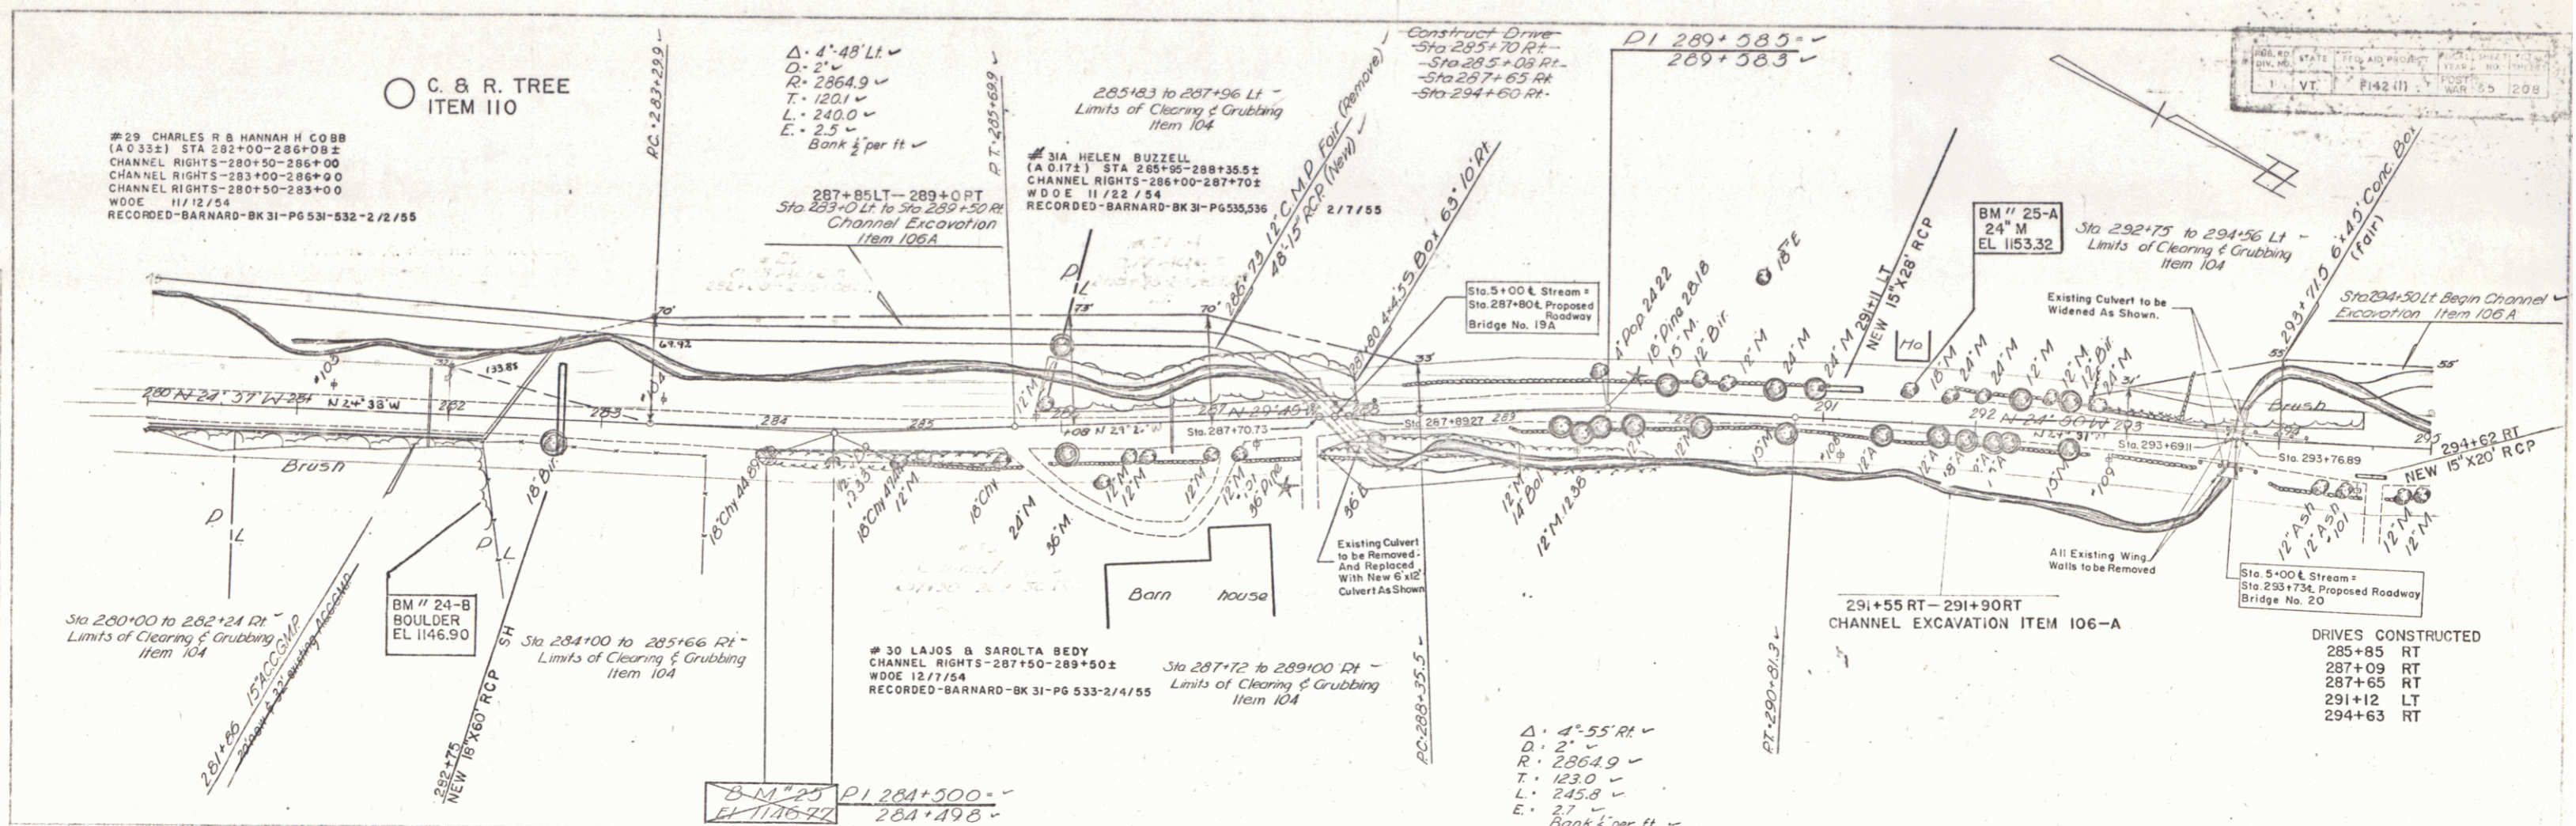

B.M. #25 15' FT RT STA 288+08.51 TO B. Cherry EL 1146.77  
 B.M. #26 0 3' FT BOULDER 60 RT STA 281+83 EL 1146.90  
 B.M. #27 4 25' FT 70 RT STA 291+55 EL 1153.22

WOODSTOCK-POMFRET-BARNARD  
 Proj. No. 142(1)

THE CLARKSON ENGINEERING CO., INC.  
 CONSULTING ENGINEERS  
 BOSTON MASSACHUSETTS