
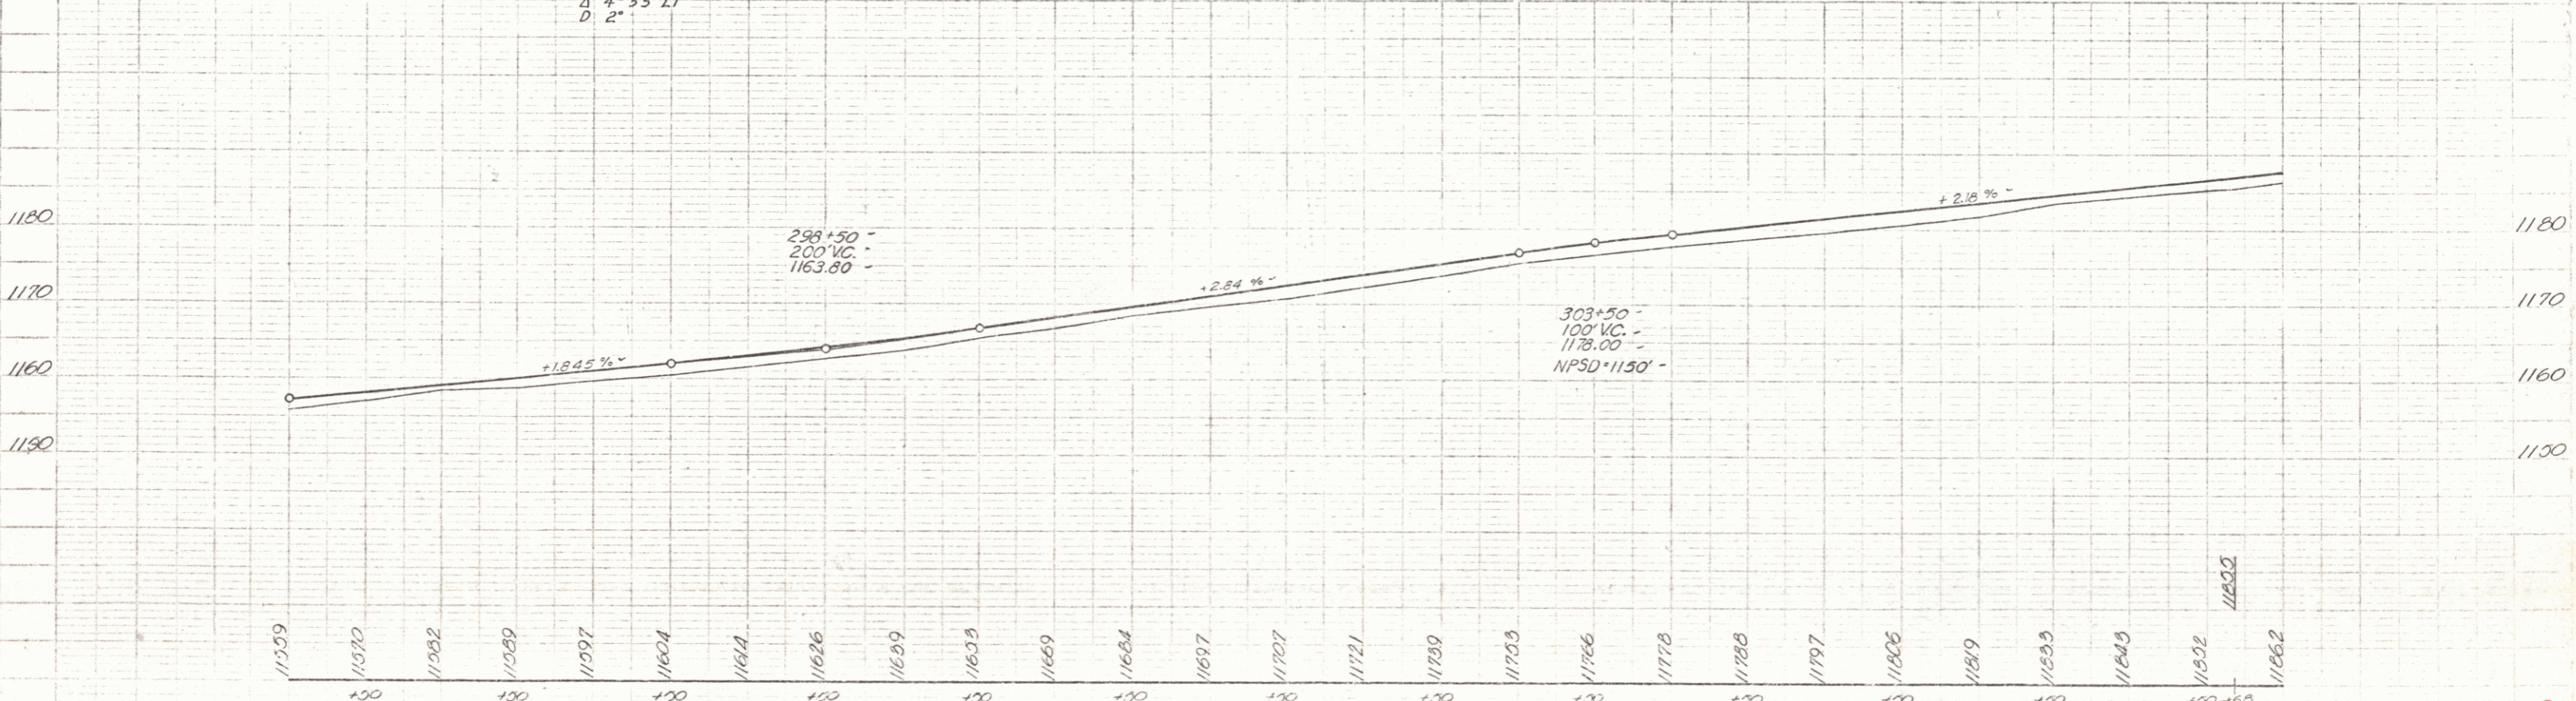


PLAN
 DATE 3-23-54
 DRAWN BY J. W. BARNARD
 CHECKED BY J. W. BARNARD

PLAN
 DATE 3-23-54
 DRAWN BY J. W. BARNARD
 CHECKED BY J. W. BARNARD

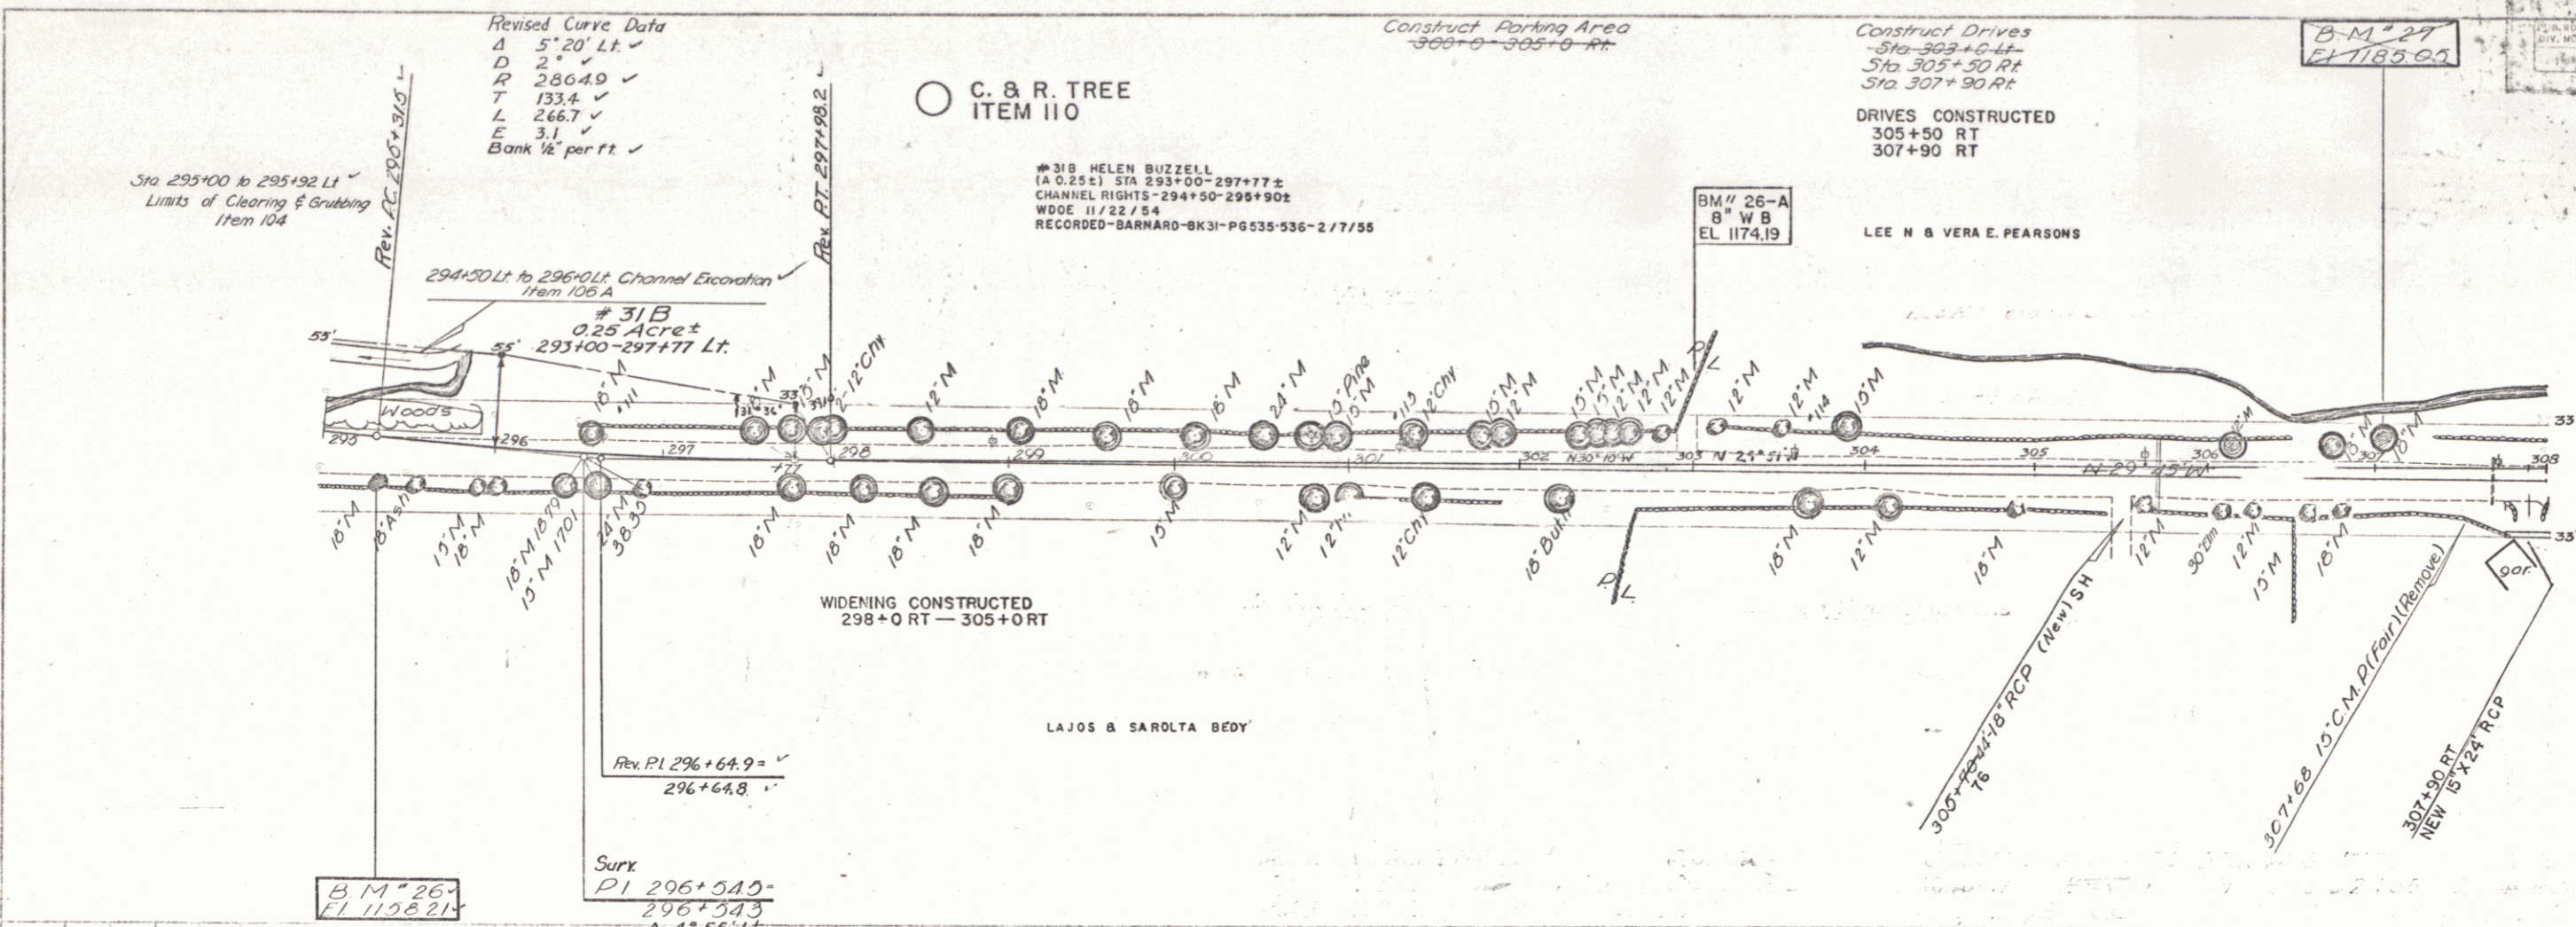

B.M. 26, 27, F.I. DI Sta 295+00, 312 18" Maple EL 1158.21
 B.M. 27, 24, F.I. DI Sta 307+00, 512 18" Maple EL 1185.00
 B.M. 26, 27, 8" W.B. 60' Lt 30370 EL 1174.19

306
 WOODSTOCK-POMFRET-BARNARD
 Proj. F No 142(1)
 THE CLARKSON ENGINEERING CO., INC.
 CONSULTING ENGINEERS
 BOSTON MASSACHUSETTS