
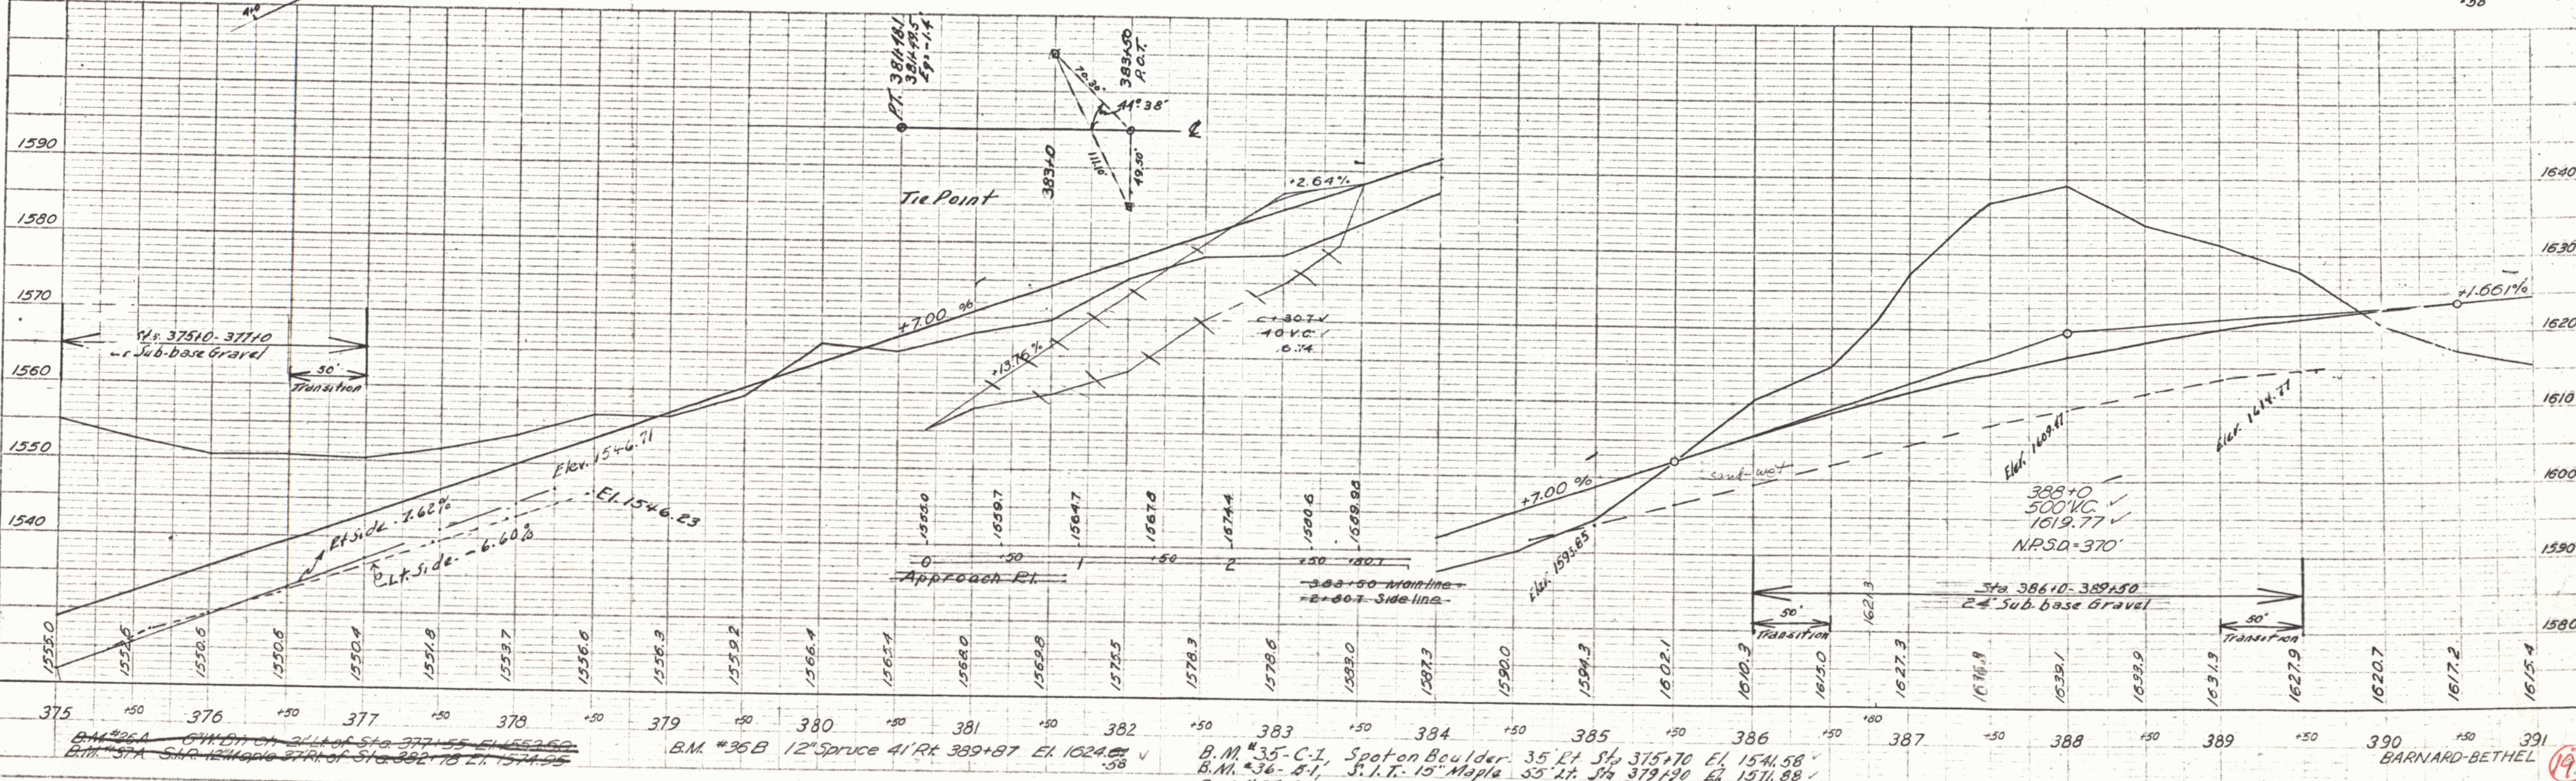


DATE: 11/8/54
 DRAWING: 142(4)7
 SHEET: 19
 PLAN: 375+00 TO 391+00
 CHECKED: Z.W. Esper
 NO. OF WAYS CHECKED: 2

DATE: 11/8/54
 DRAWING: 142(4)7
 SHEET: 19
 PROFILE: 375+00 TO 391+00
 CHECKED: Z.W. Esper
 NO. OF WAYS CHECKED: 2

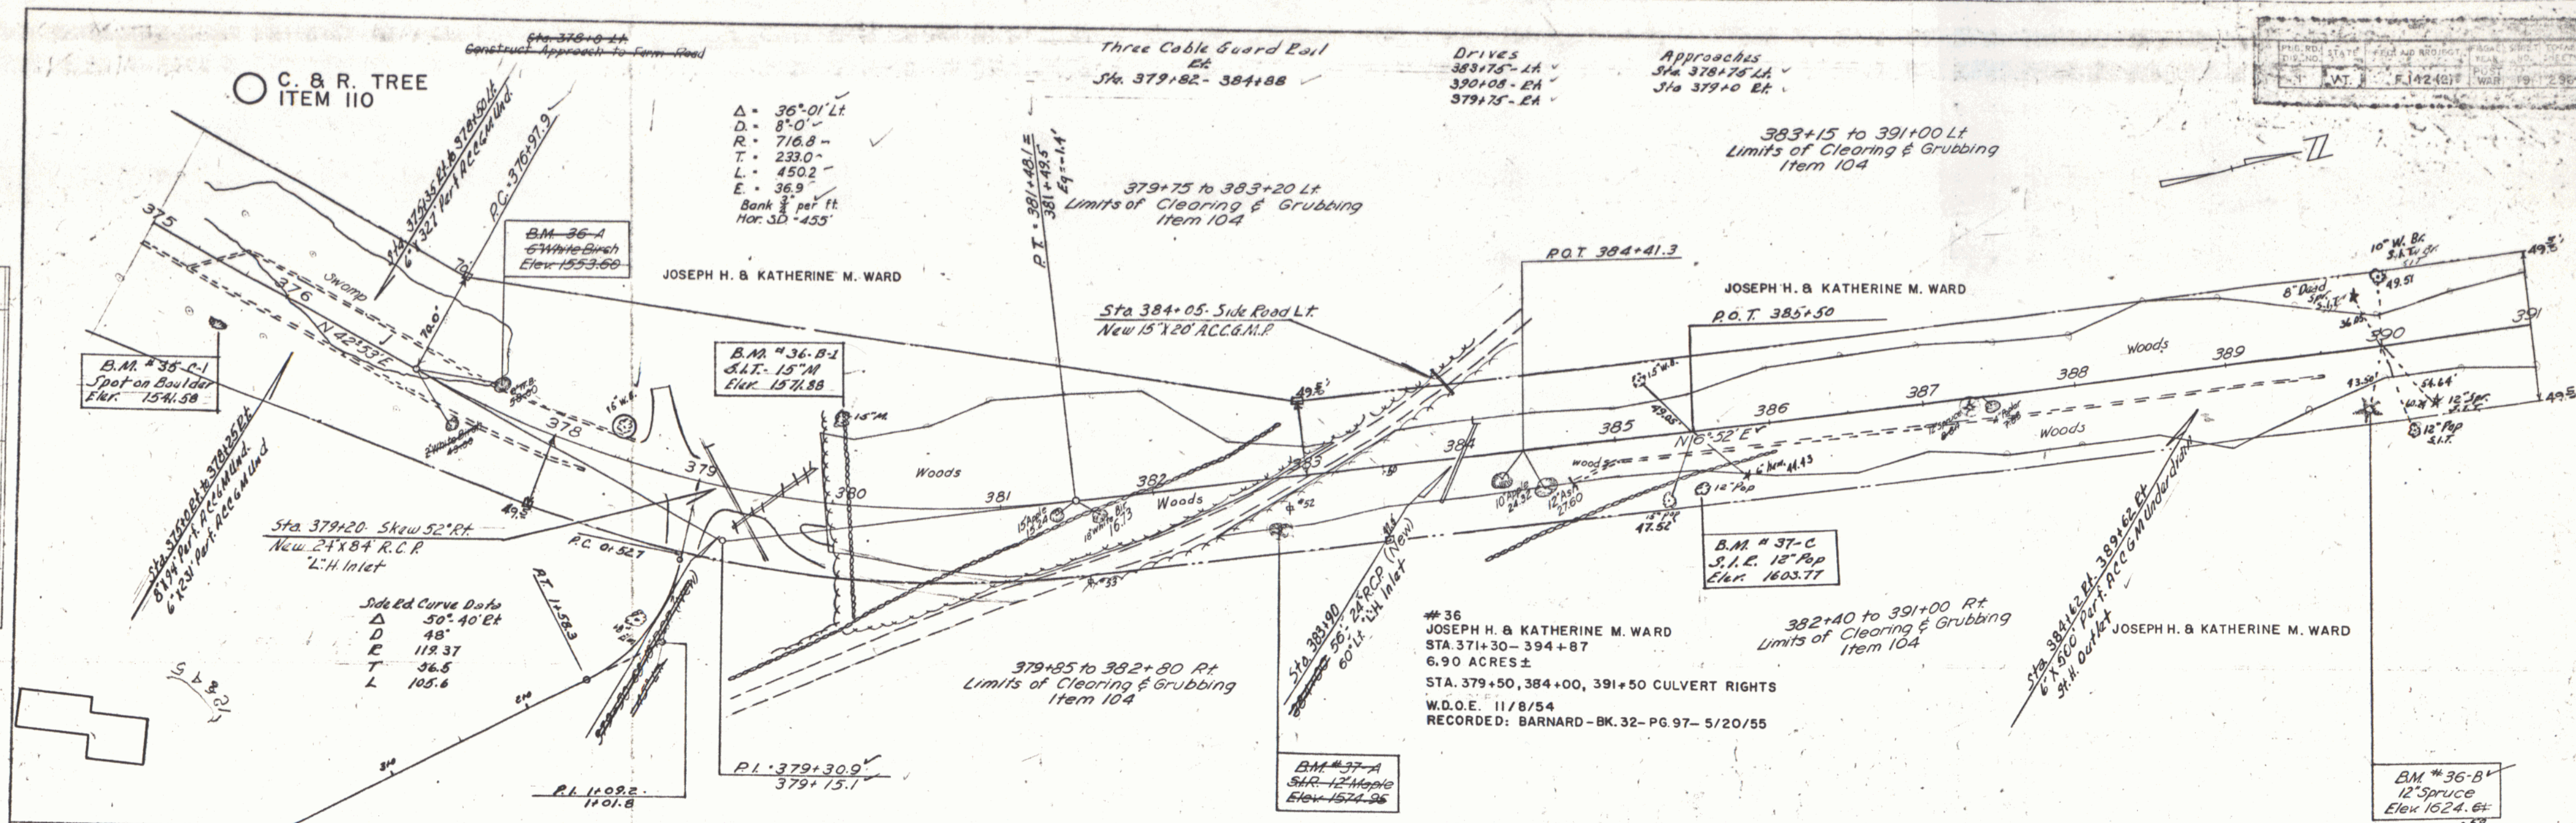

B.M. #36-A G.W.D. in 2" dia. of Sta. 377+55 Elev. 1553.60
 B.M. #37-A S.H.R. 12" Maple 35' Lt. Sta. 381+78 Lt. Elev. 1574.26
 B.M. #36-B 12" Spruce 41' Rt. Sta. 389+87 Elev. 1624.58
 B.M. #35-C-1 Spot on Boulder 35' Lt. Sta. 375+70 Elev. 1541.58
 B.M. #36-B-1 S.I.L. 15" Maple 35' Lt. Sta. 379+50 Elev. 1571.88
 B.M. #37-C S.I.L. 12" Pop 38' Rt. Sta. 385+52 Elev. 1603.77