
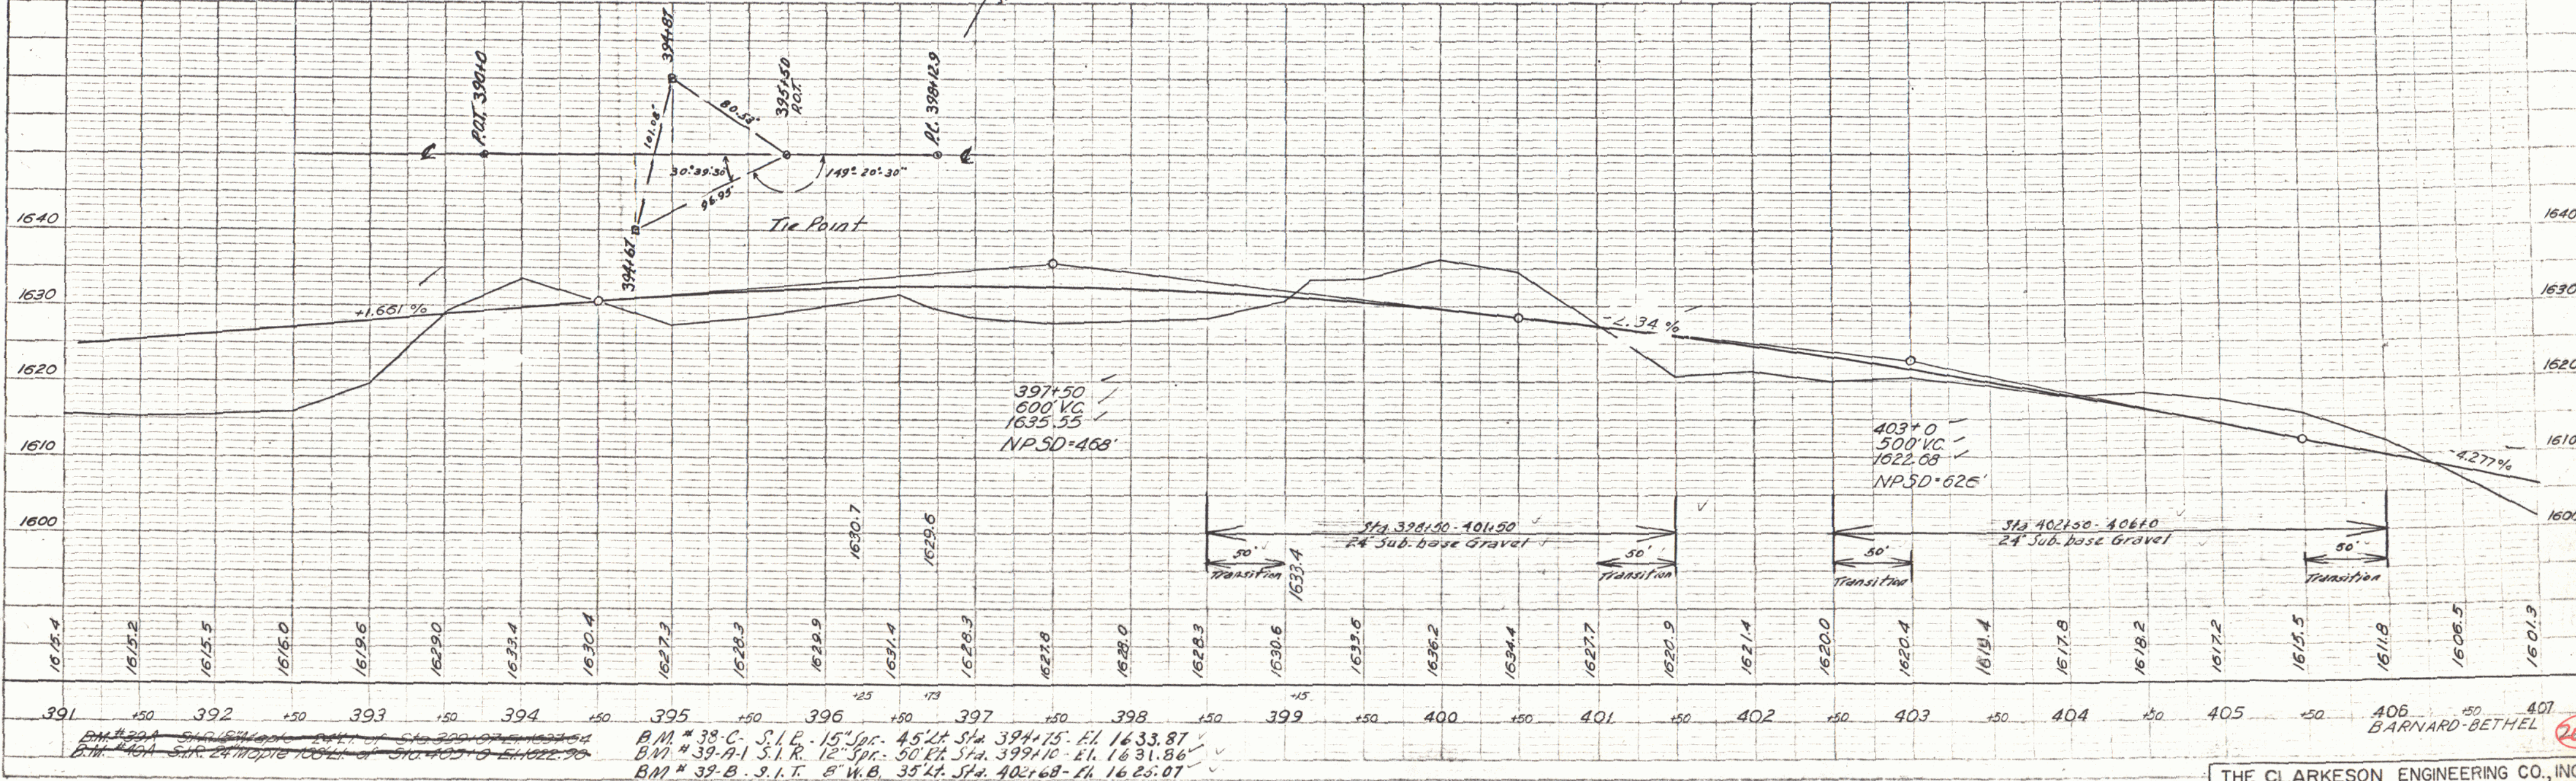


PLAN  
 REVISIONS  
 NO. DATE BY  
 10/53  
 11/53  
 12/53  
 Z.W. Espar  
 Z.W. Espar  
 Z.W. Espar  
 NOTE: BOOK DAMAGED BY WATER  
 BY OF MAP CHECKED

PROFILE  
 REVISIONS  
 NO. DATE BY  
 10/53  
 11/53  
 12/53  
 G. G. Goss  
 Z.W. Espar  
 Z.W. Espar  
 NOTE: BOOK DAMAGED BY WATER  
 BY OF MAP CHECKED

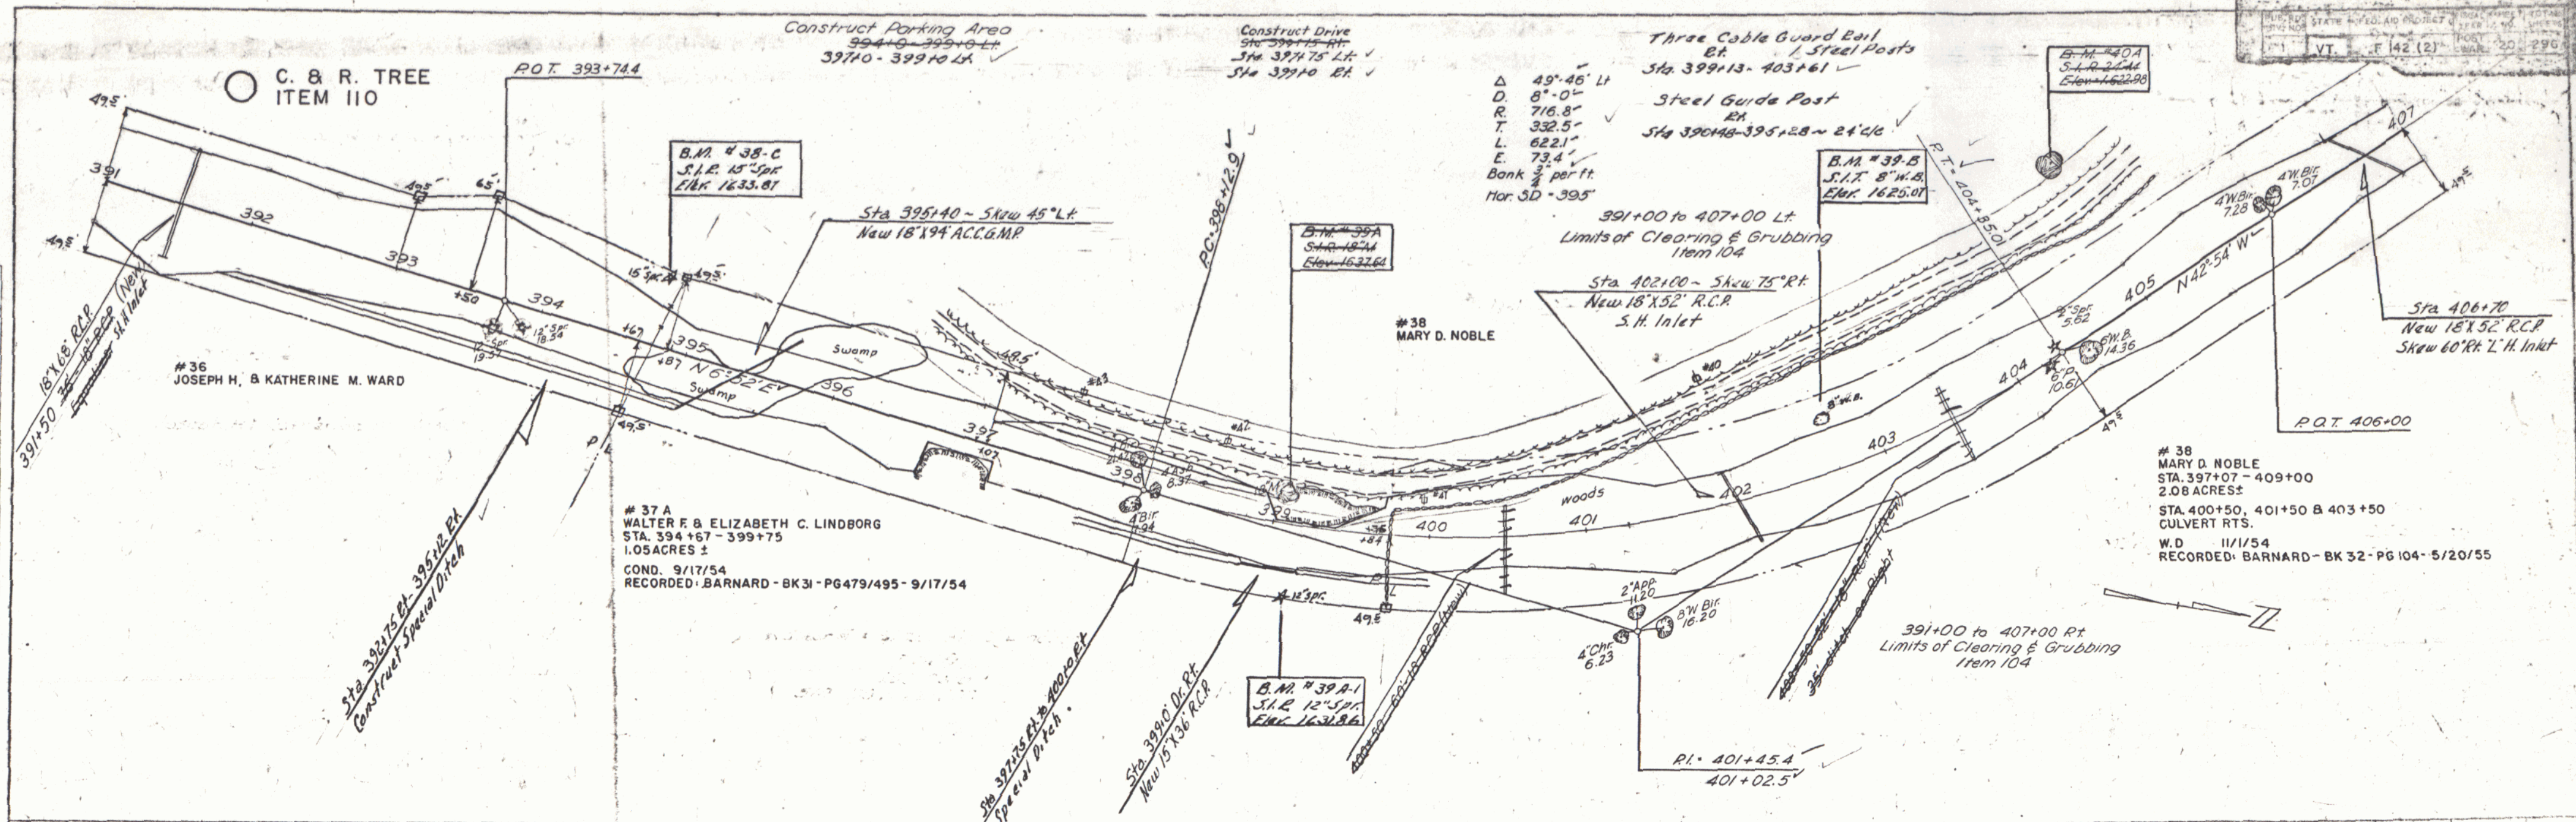

B.M. #39A S.I.R. 24" Sp. 100' Lt. Sta. 390+10 El. 1622.90  
 B.M. #38-C S.I.R. 15" Sp. 45' Lt. Sta. 394+15 El. 1633.87  
 B.M. #39-A-1 S.I.R. 12" Sp. 50' Lt. Sta. 399+10 El. 1631.86  
 B.M. #39-B S.I.T. 8" W.B. 35' Lt. Sta. 402+68 El. 1625.07