
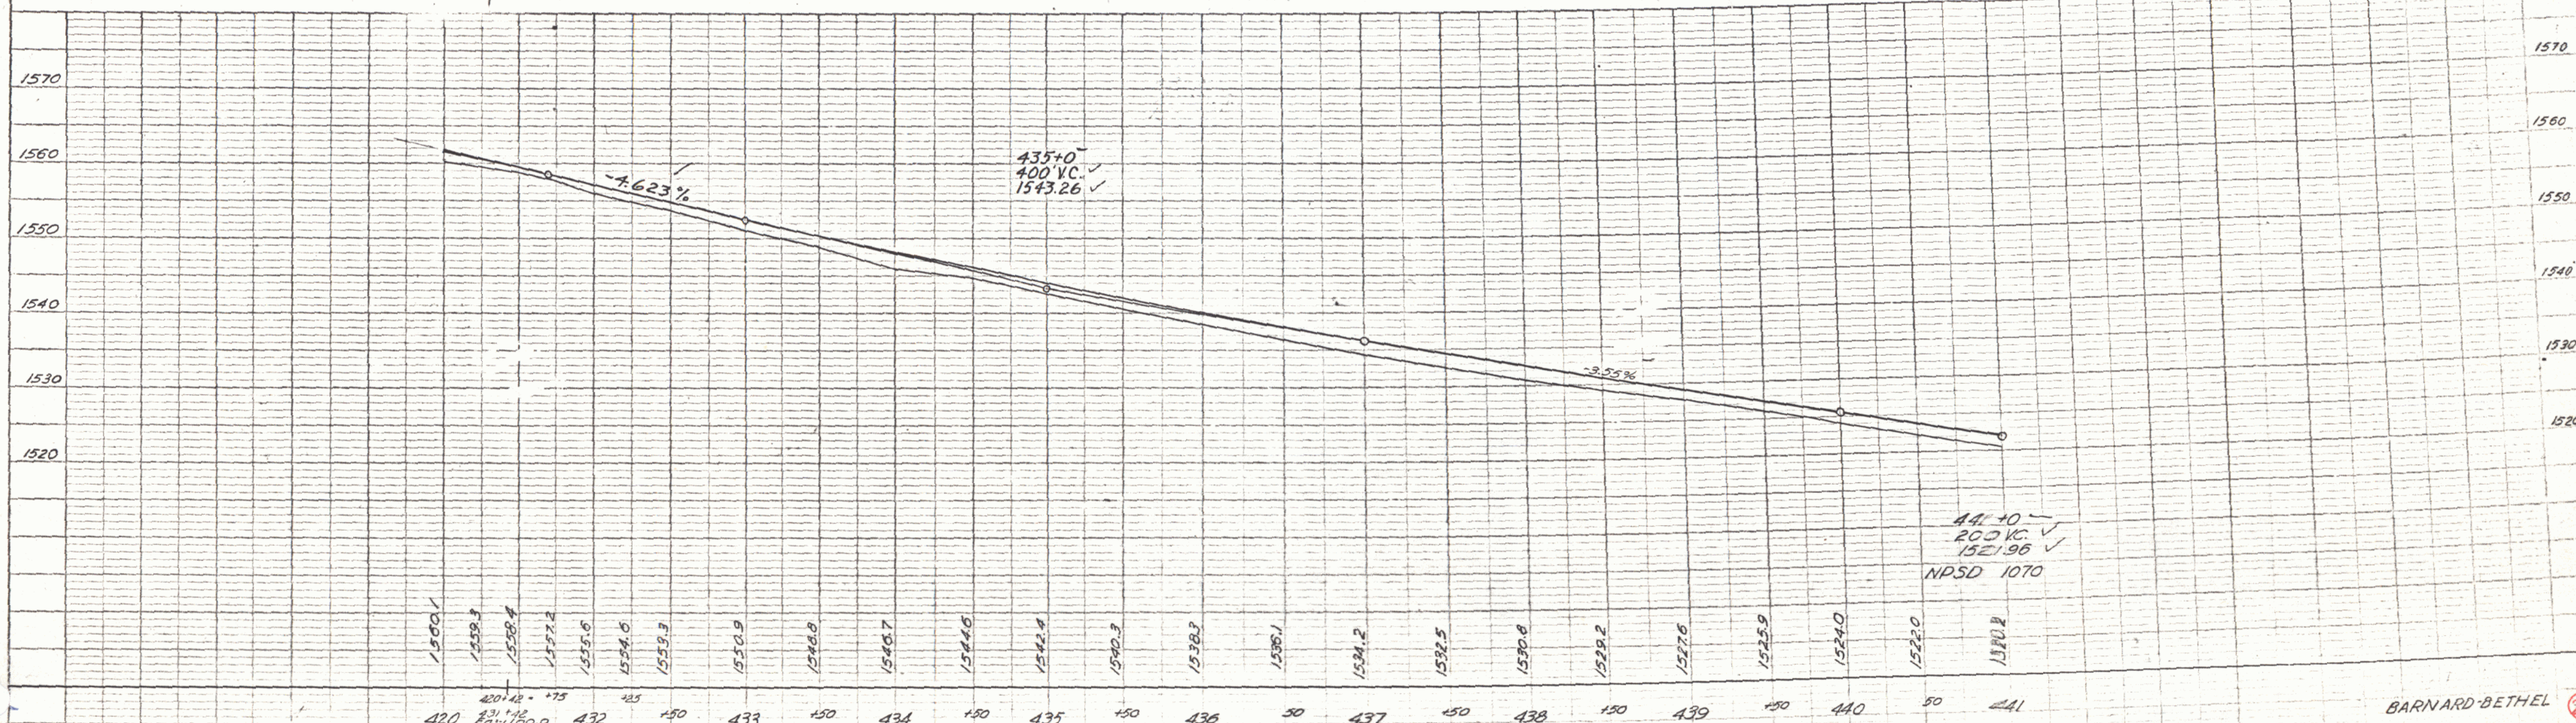


C. & R. TREE
ITEM 110

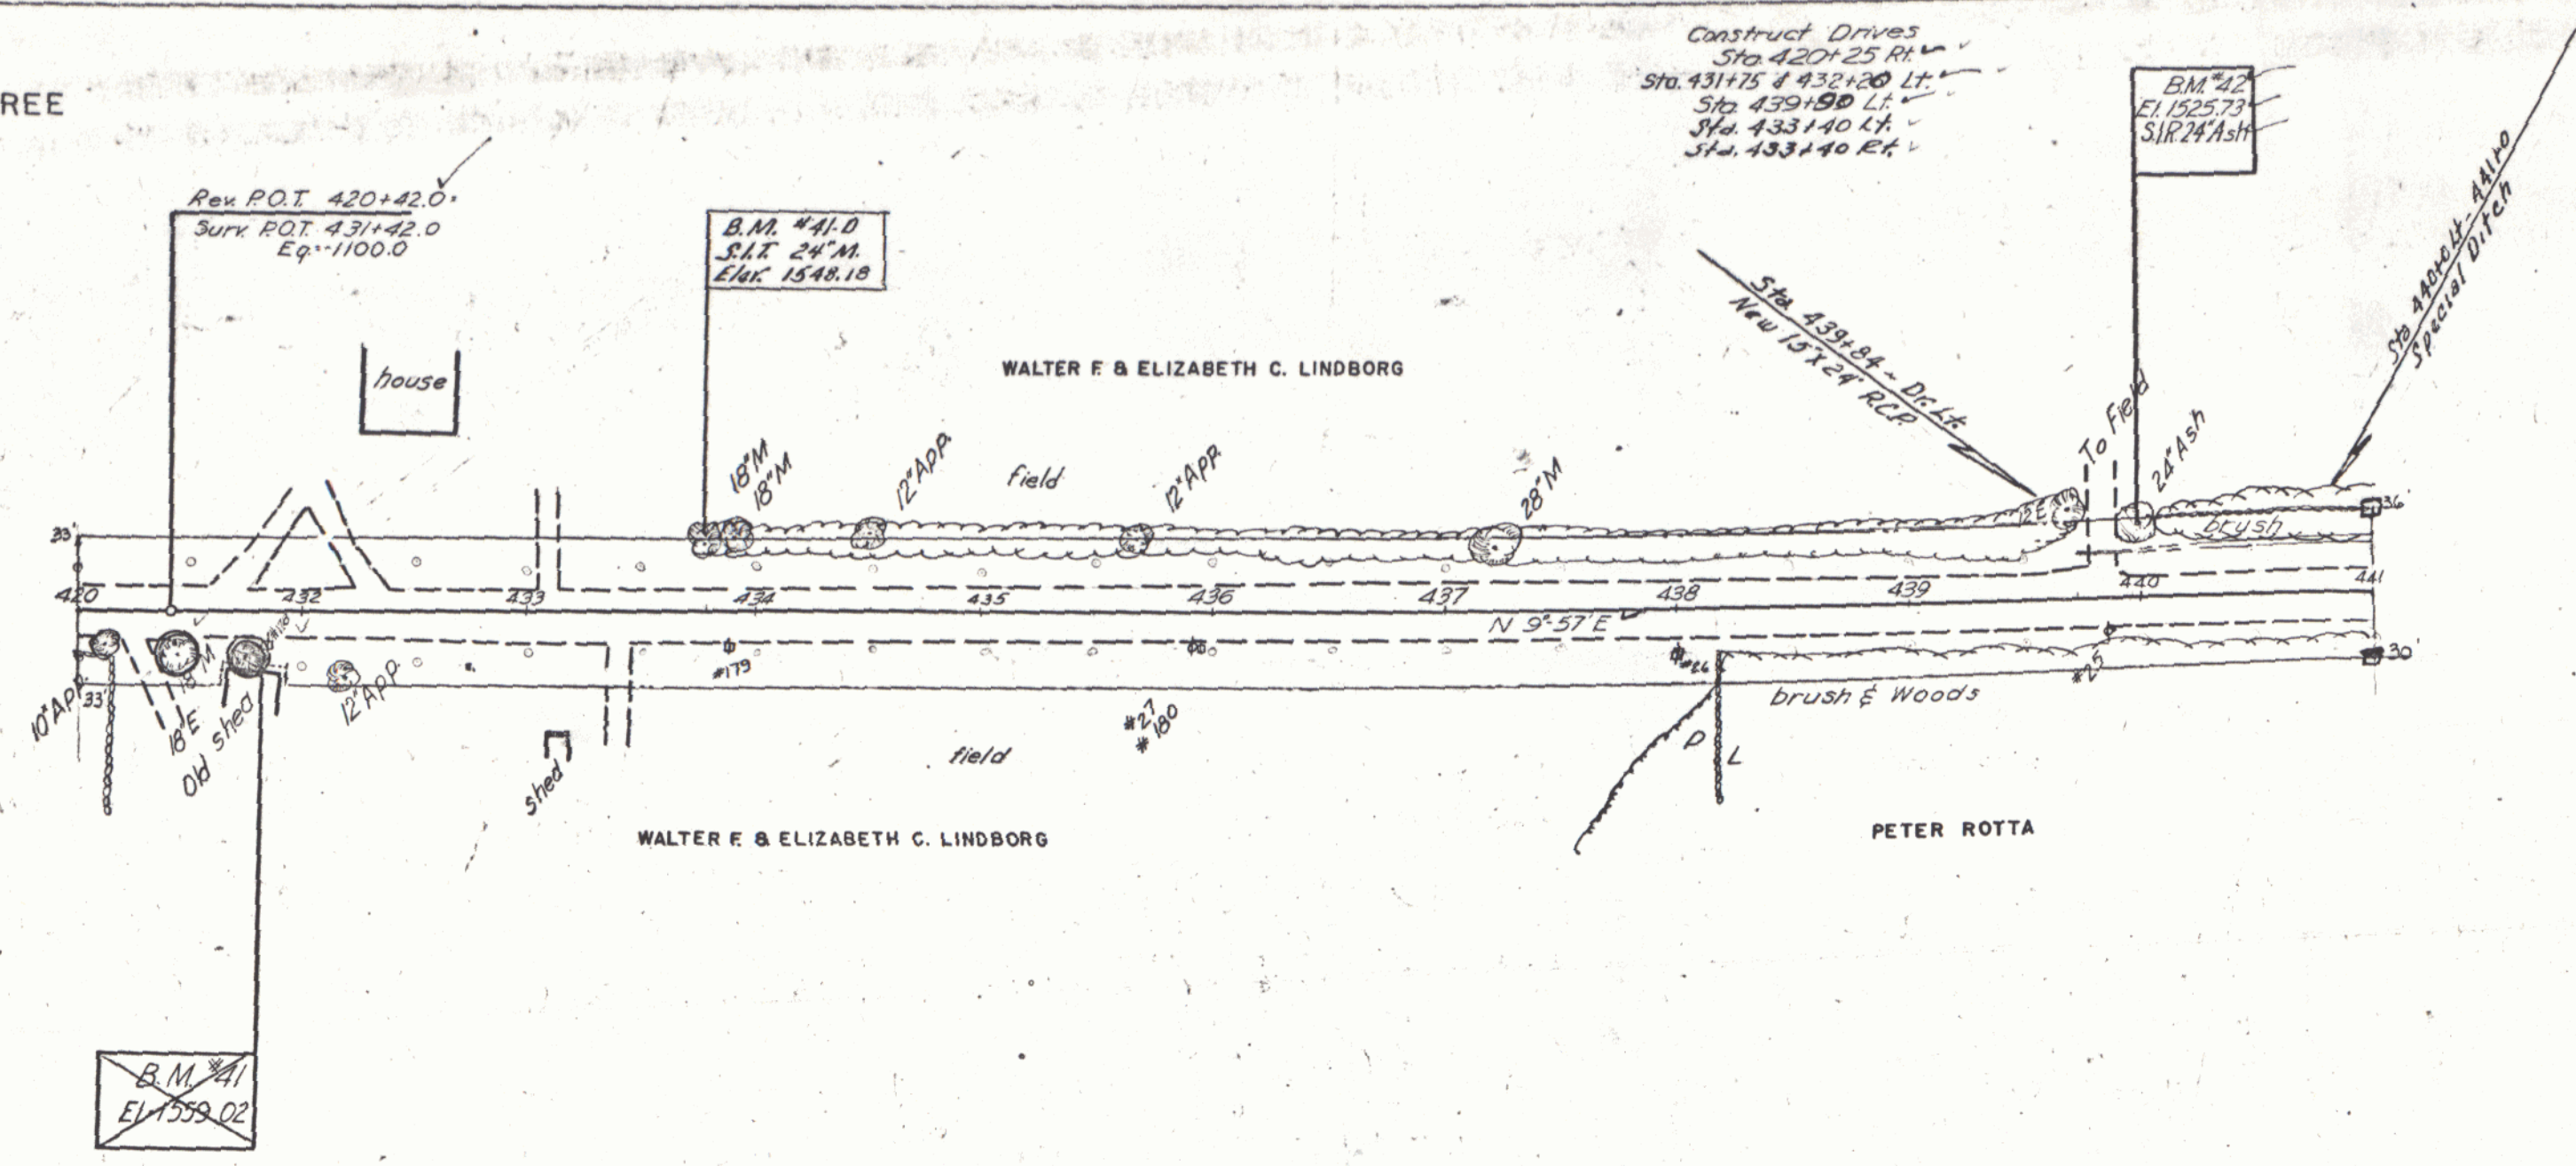

PLAN
DESIGNED BY: [Name]
CHECKED BY: [Name]
DATE: [Date]

PROFILE
DESIGNED BY: [Name]
CHECKED BY: [Name]
DATE: [Date]

B.M. #41 S.I.R. 18' M 26' L Sta 420+00 EL 1559.02
B.M. #42 S.I.R. 24' Ash 34' L Sta 440+00 EL 1525.73
B.M. #41-D S.I.T. 24' Maple 35' L Sta 433+80 EL 1548.18