


○ C. & R. TREE
ITEM 110

VT. 142(2) 296

PLAN
DRAWN BY
CHECKED BY
DATE
NO.

FILE
DRAWN BY
CHECKED BY
DATE
NO.

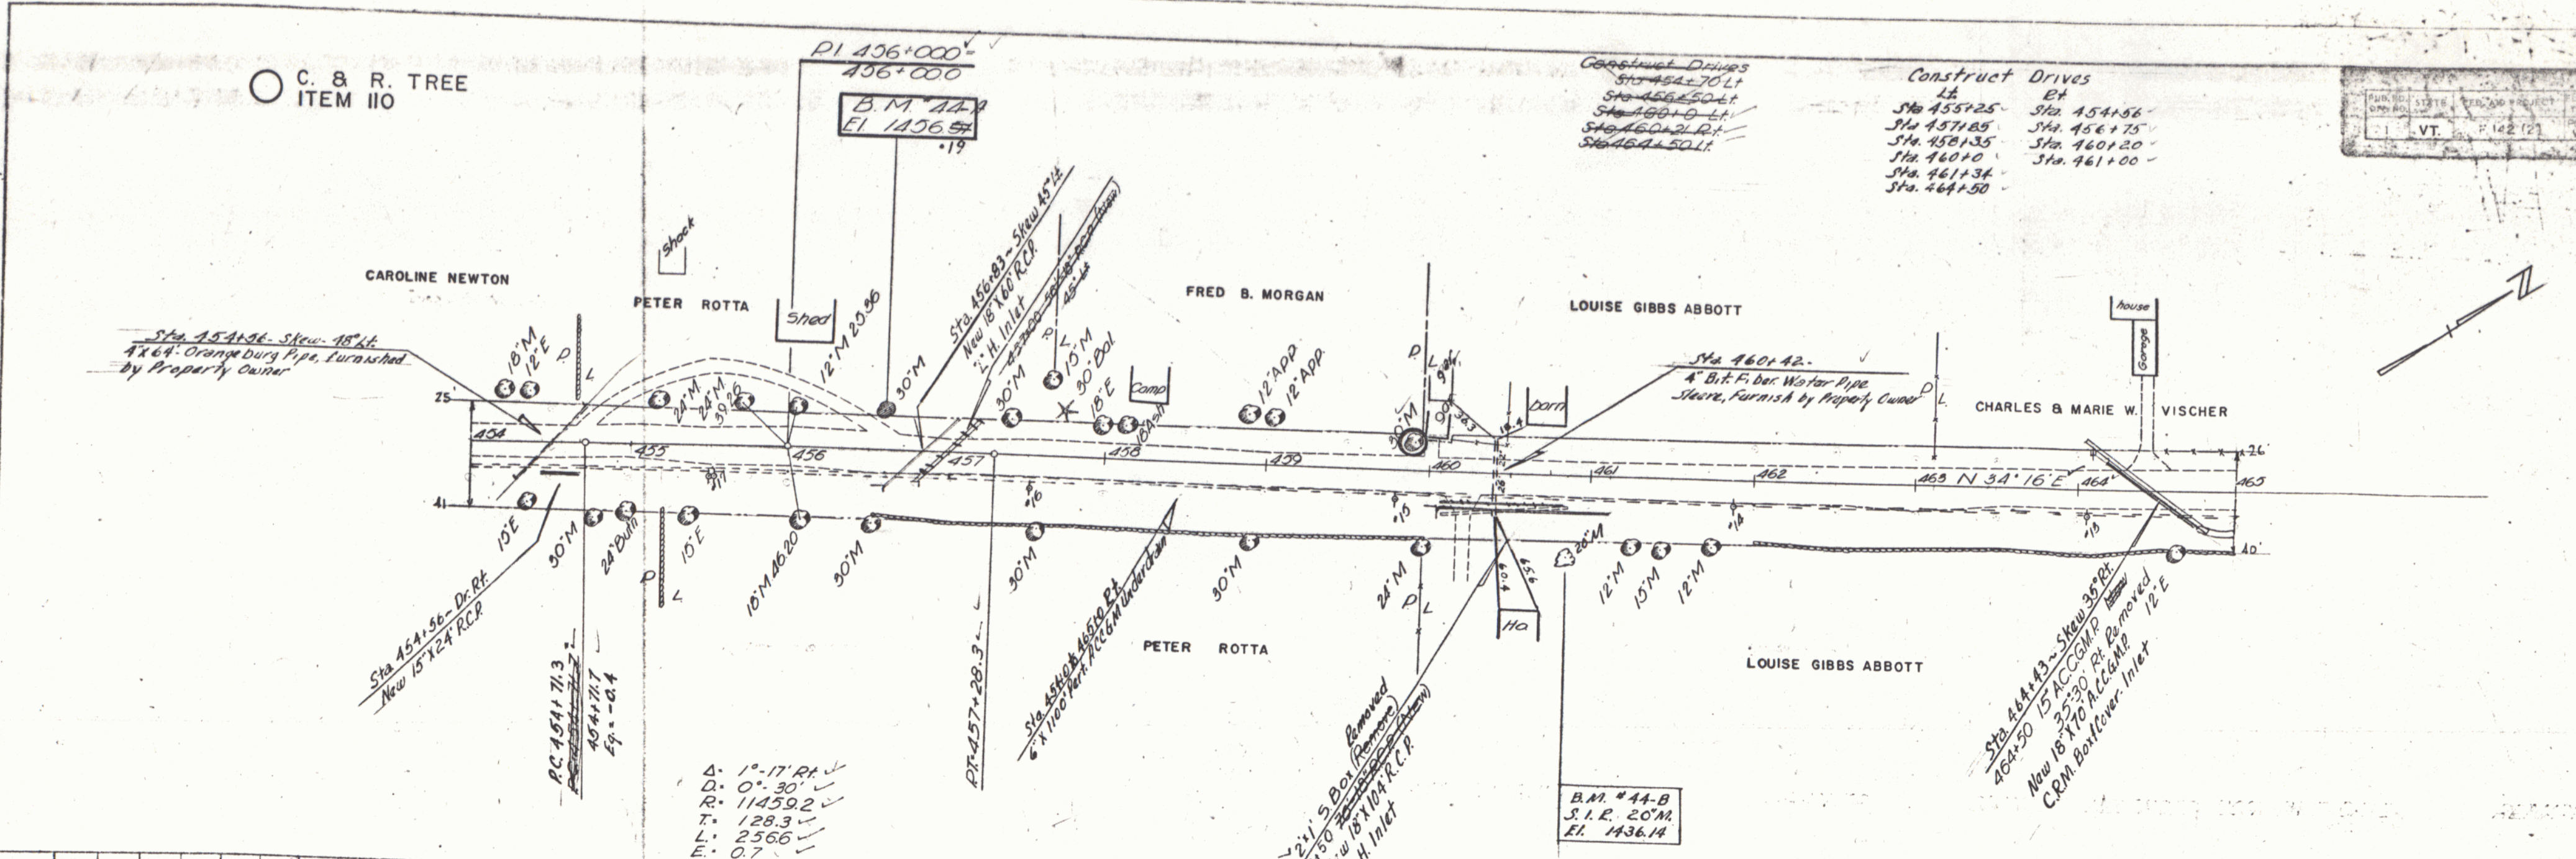

Δ: 1°-17' R ✓
D: 0°-30' ✓
R: 11459.2 ✓
T: 128.3 ✓
L: 2566 ✓
E: 0.7 ✓
No Bank ✓

