
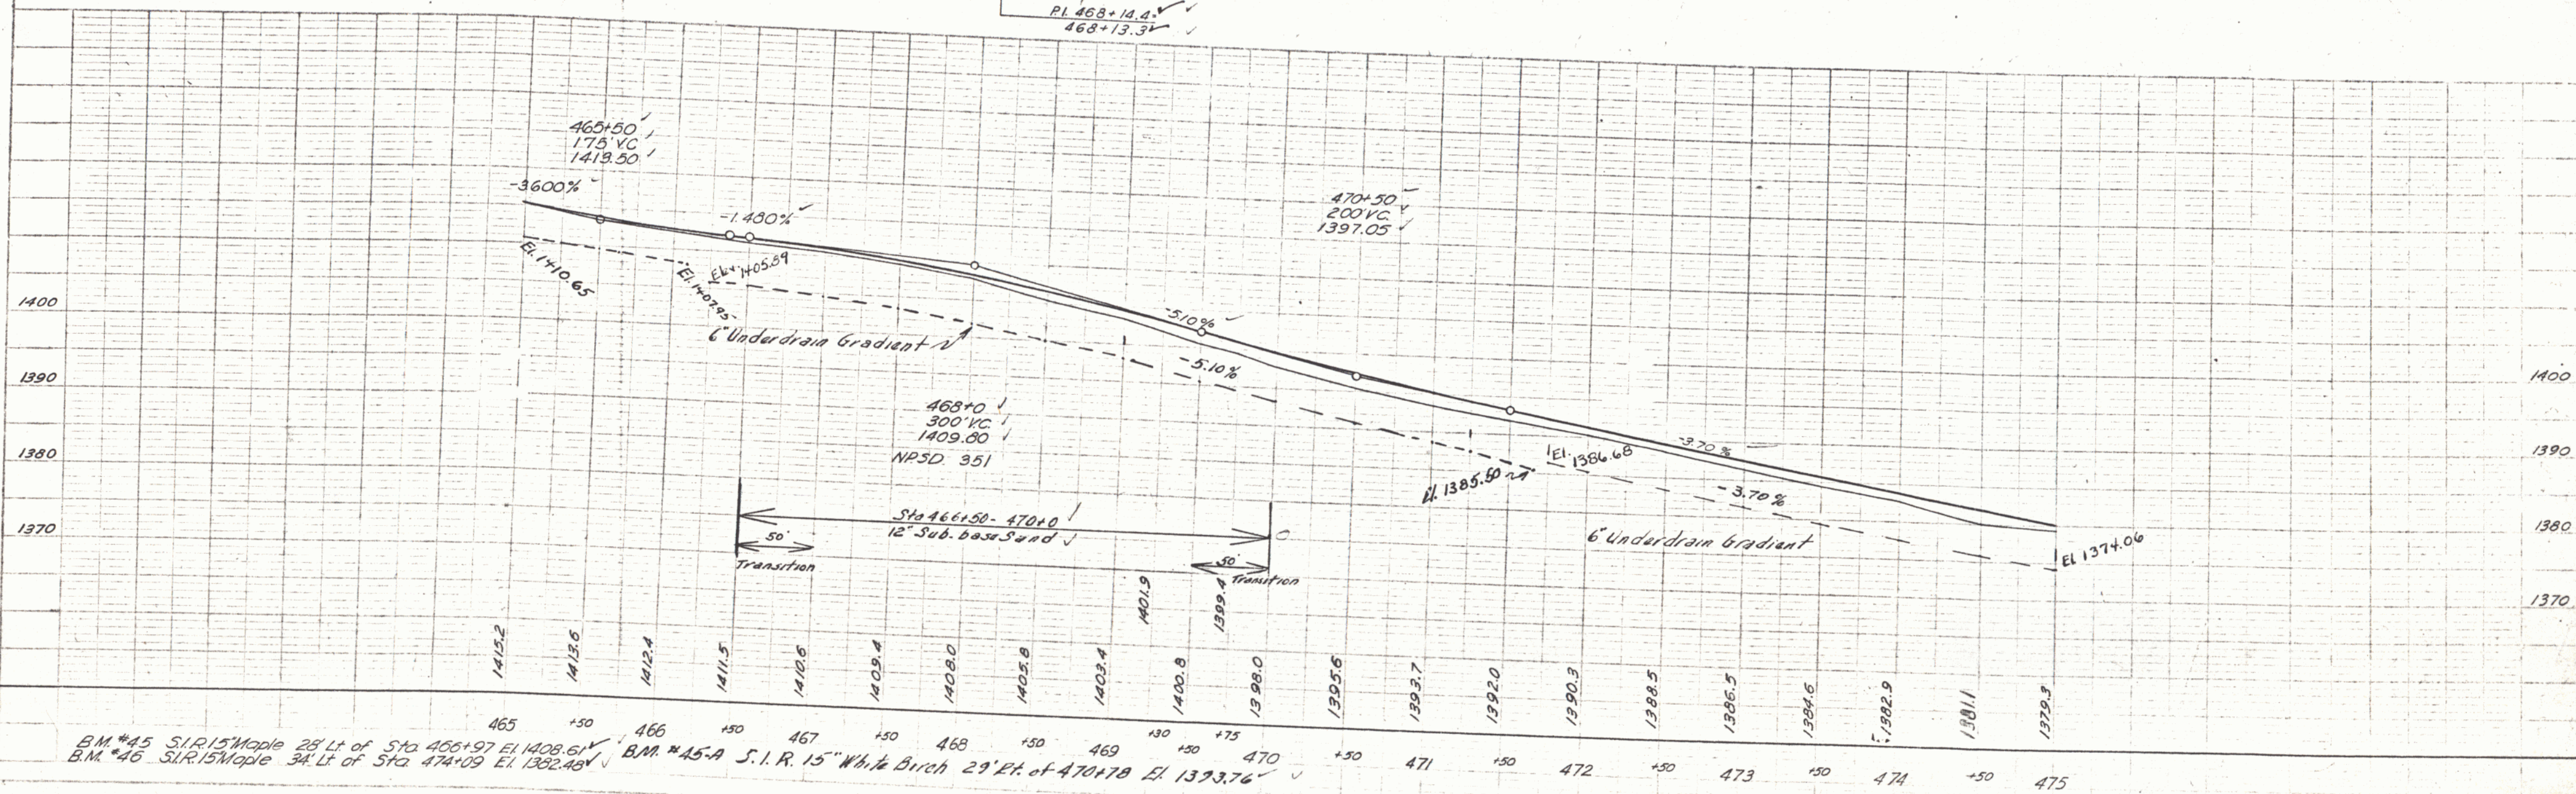


○ C. & R. TREE
ITEM 110

PLAN
DATE 9-11-53
SCALE 1" = 40'
NOTE BOOK ALIGNMENT CHECKED
BY Z. W. E. SPUR

DATE 9-9-53
SCALE 1" = 40'
NOTE BOOK LONG CHECKED
BY Z. W. E. SPUR

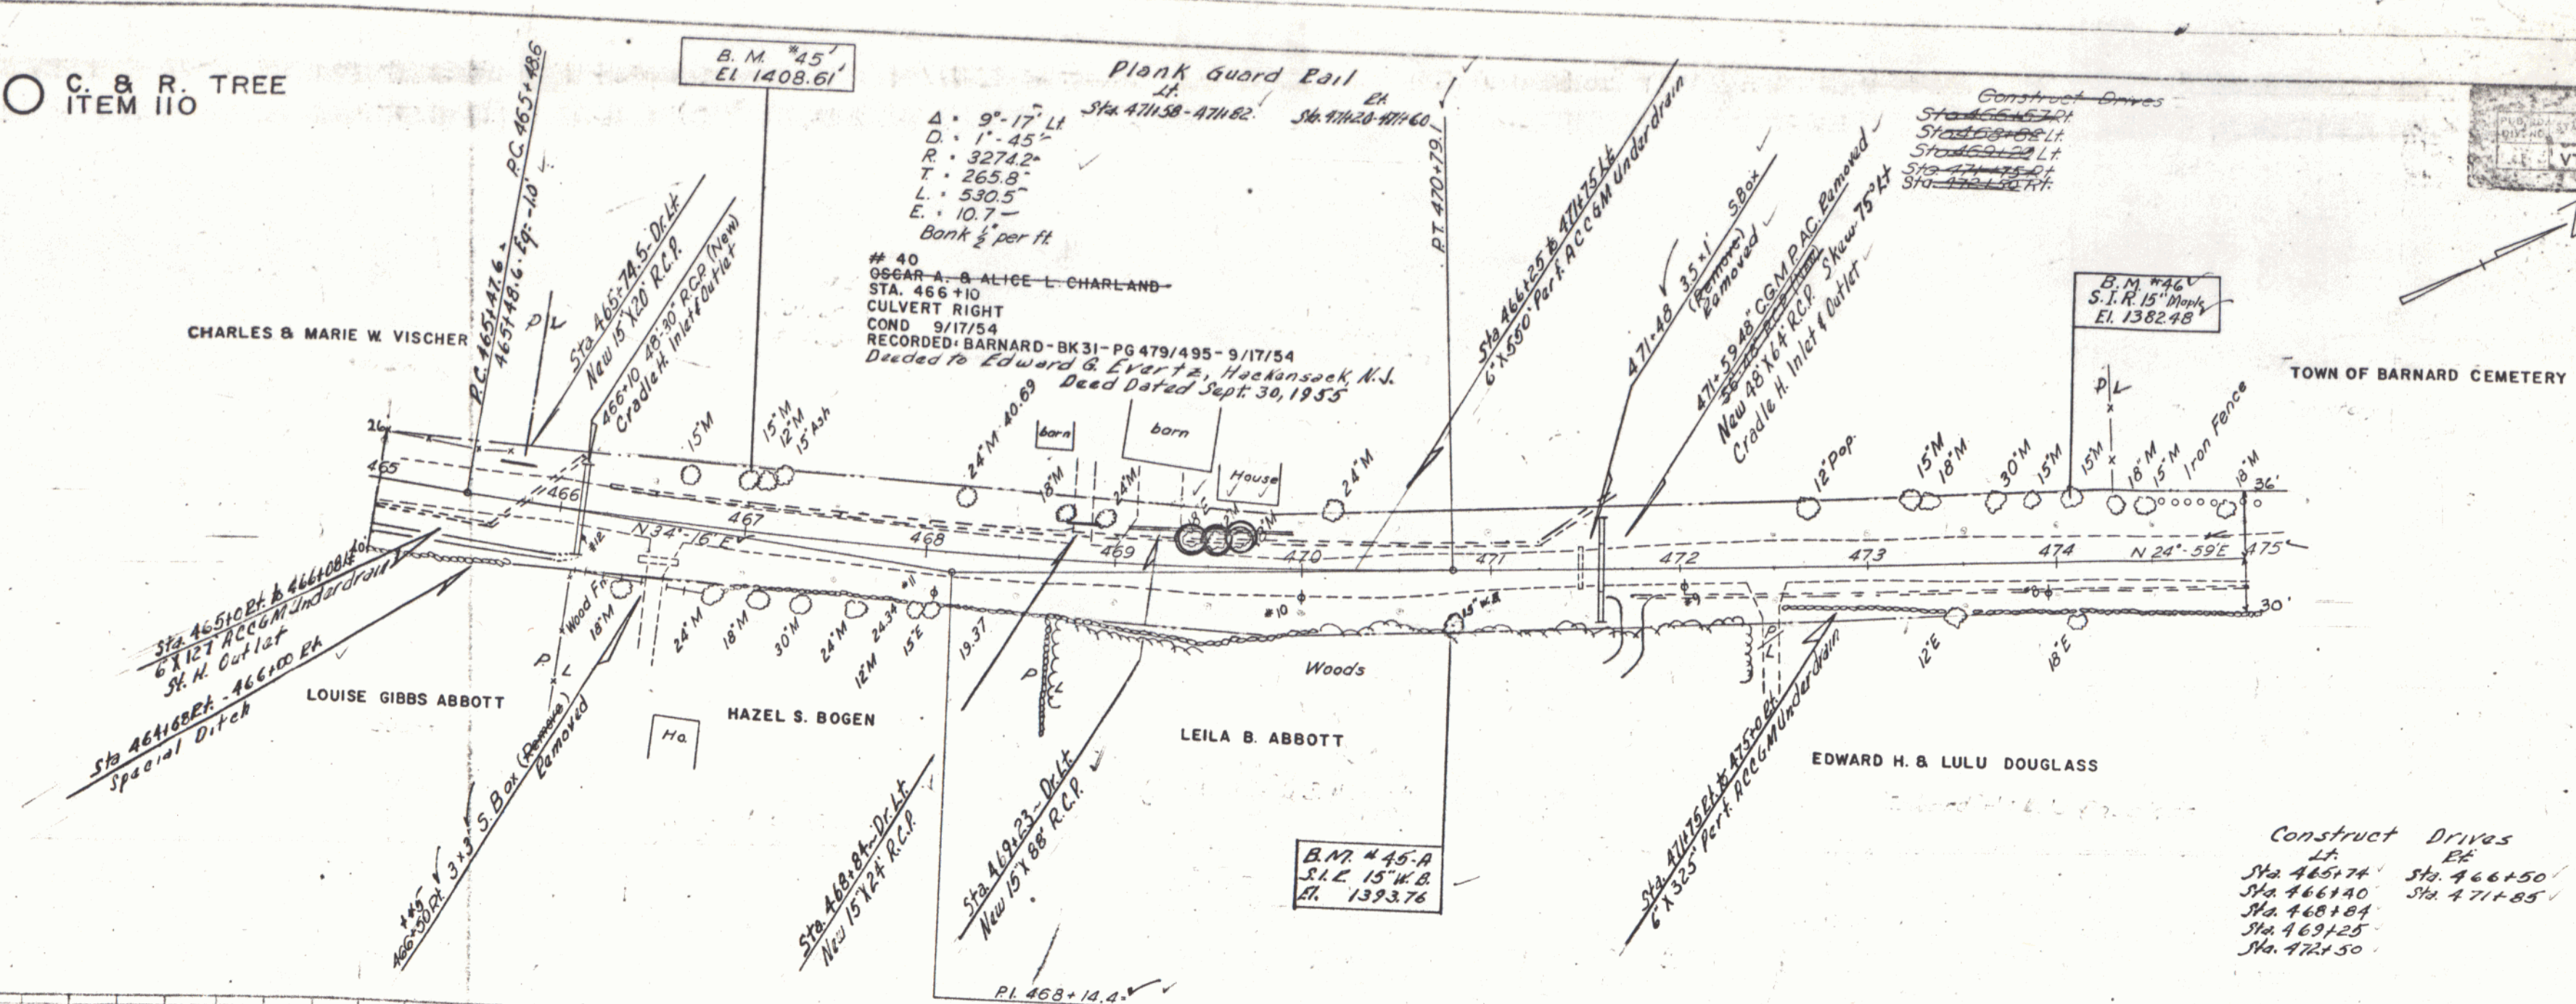

VT. F 142 (2) NOV 25 1956



Construct Drives
LT
Sta. 465+74 Sta. 466+50
Sta. 466+140 Sta. 471+85
Sta. 466+184
Sta. 469+25
Sta. 472+50

B.M. #45 S.I.R. 15' Maple 28' Lt. of Sta. 466+97 El. 1408.61
B.M. #46 S.I.R. 15' Maple 34' Lt. of Sta. 474+09 El. 1382.48
B.M. #45-A S.I.R. 15' White Birch 29' Lt. of 470+78 El. 1393.76