

DATE: _____
 BY: _____
 SURVEYED: _____
 PLOTTED: _____
 CHECKED: _____
 BY: _____

DATE: _____
 BY: _____
 SURVEYED: _____
 PLOTTED: _____
 CHECKED: _____
 BY: _____

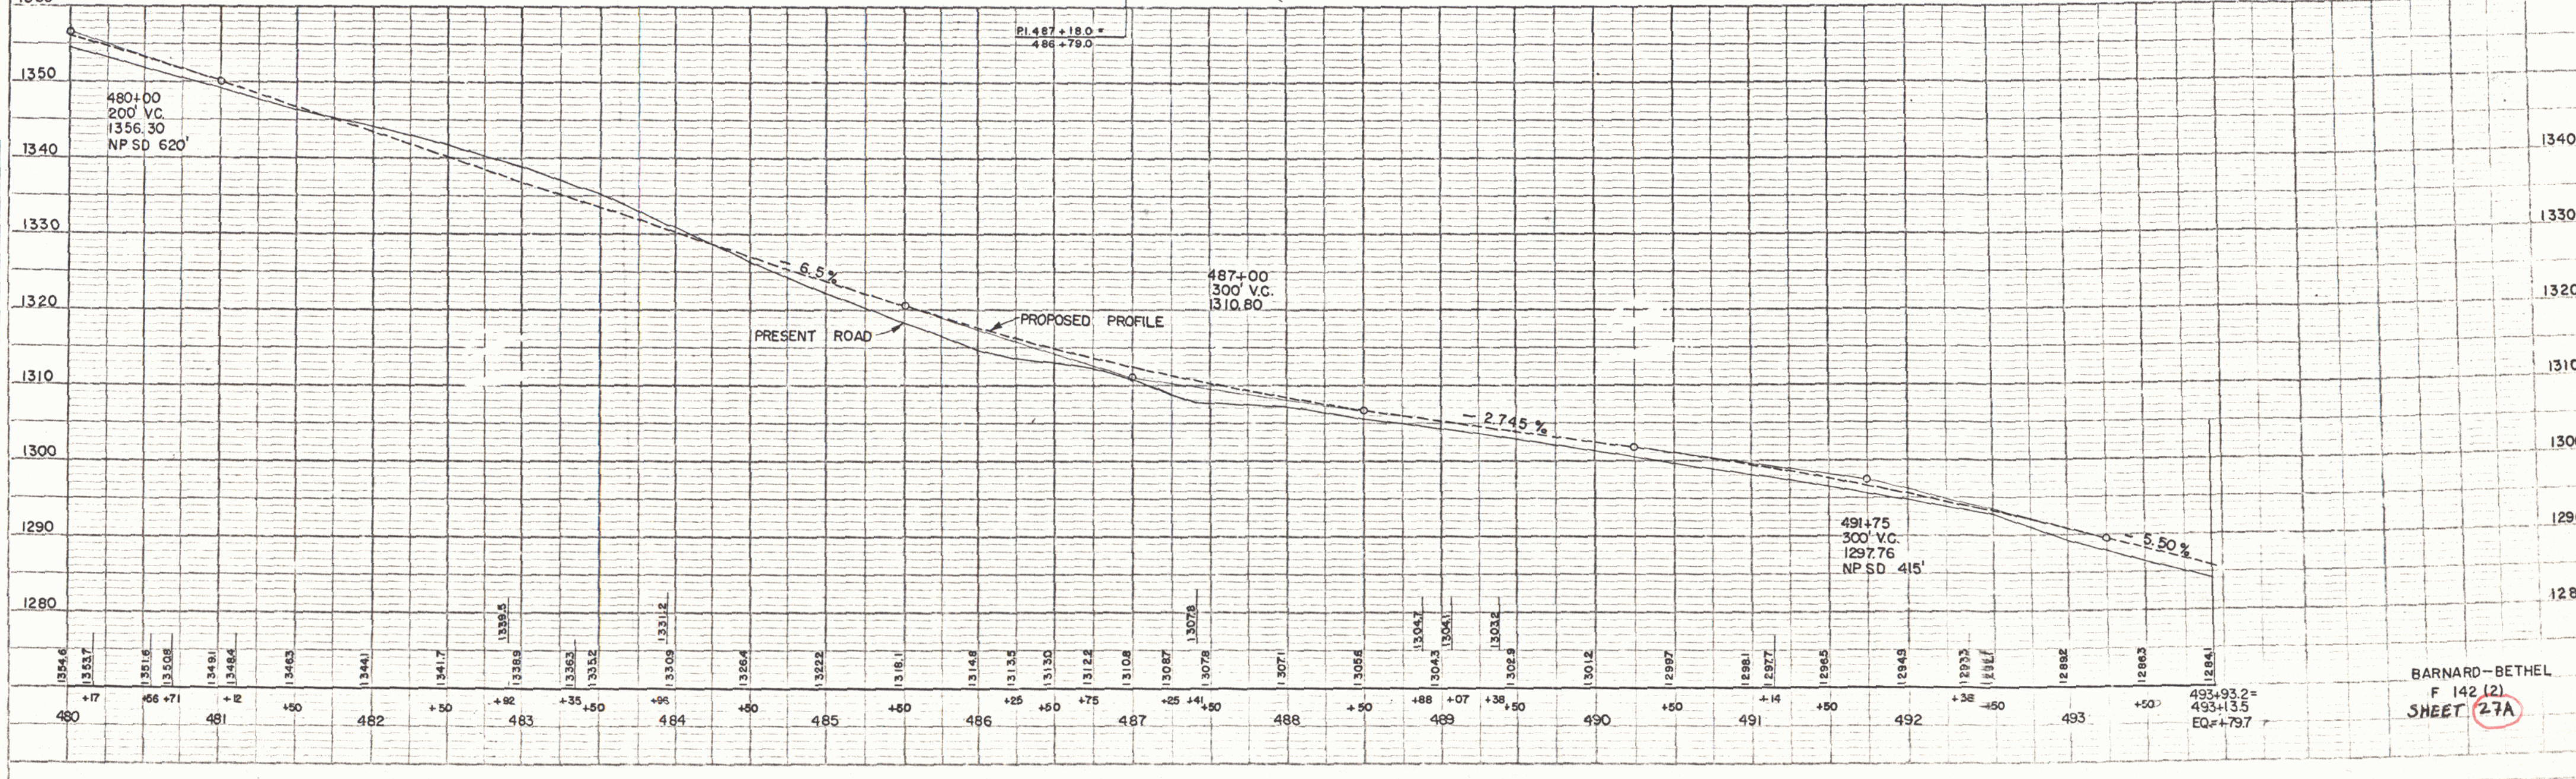
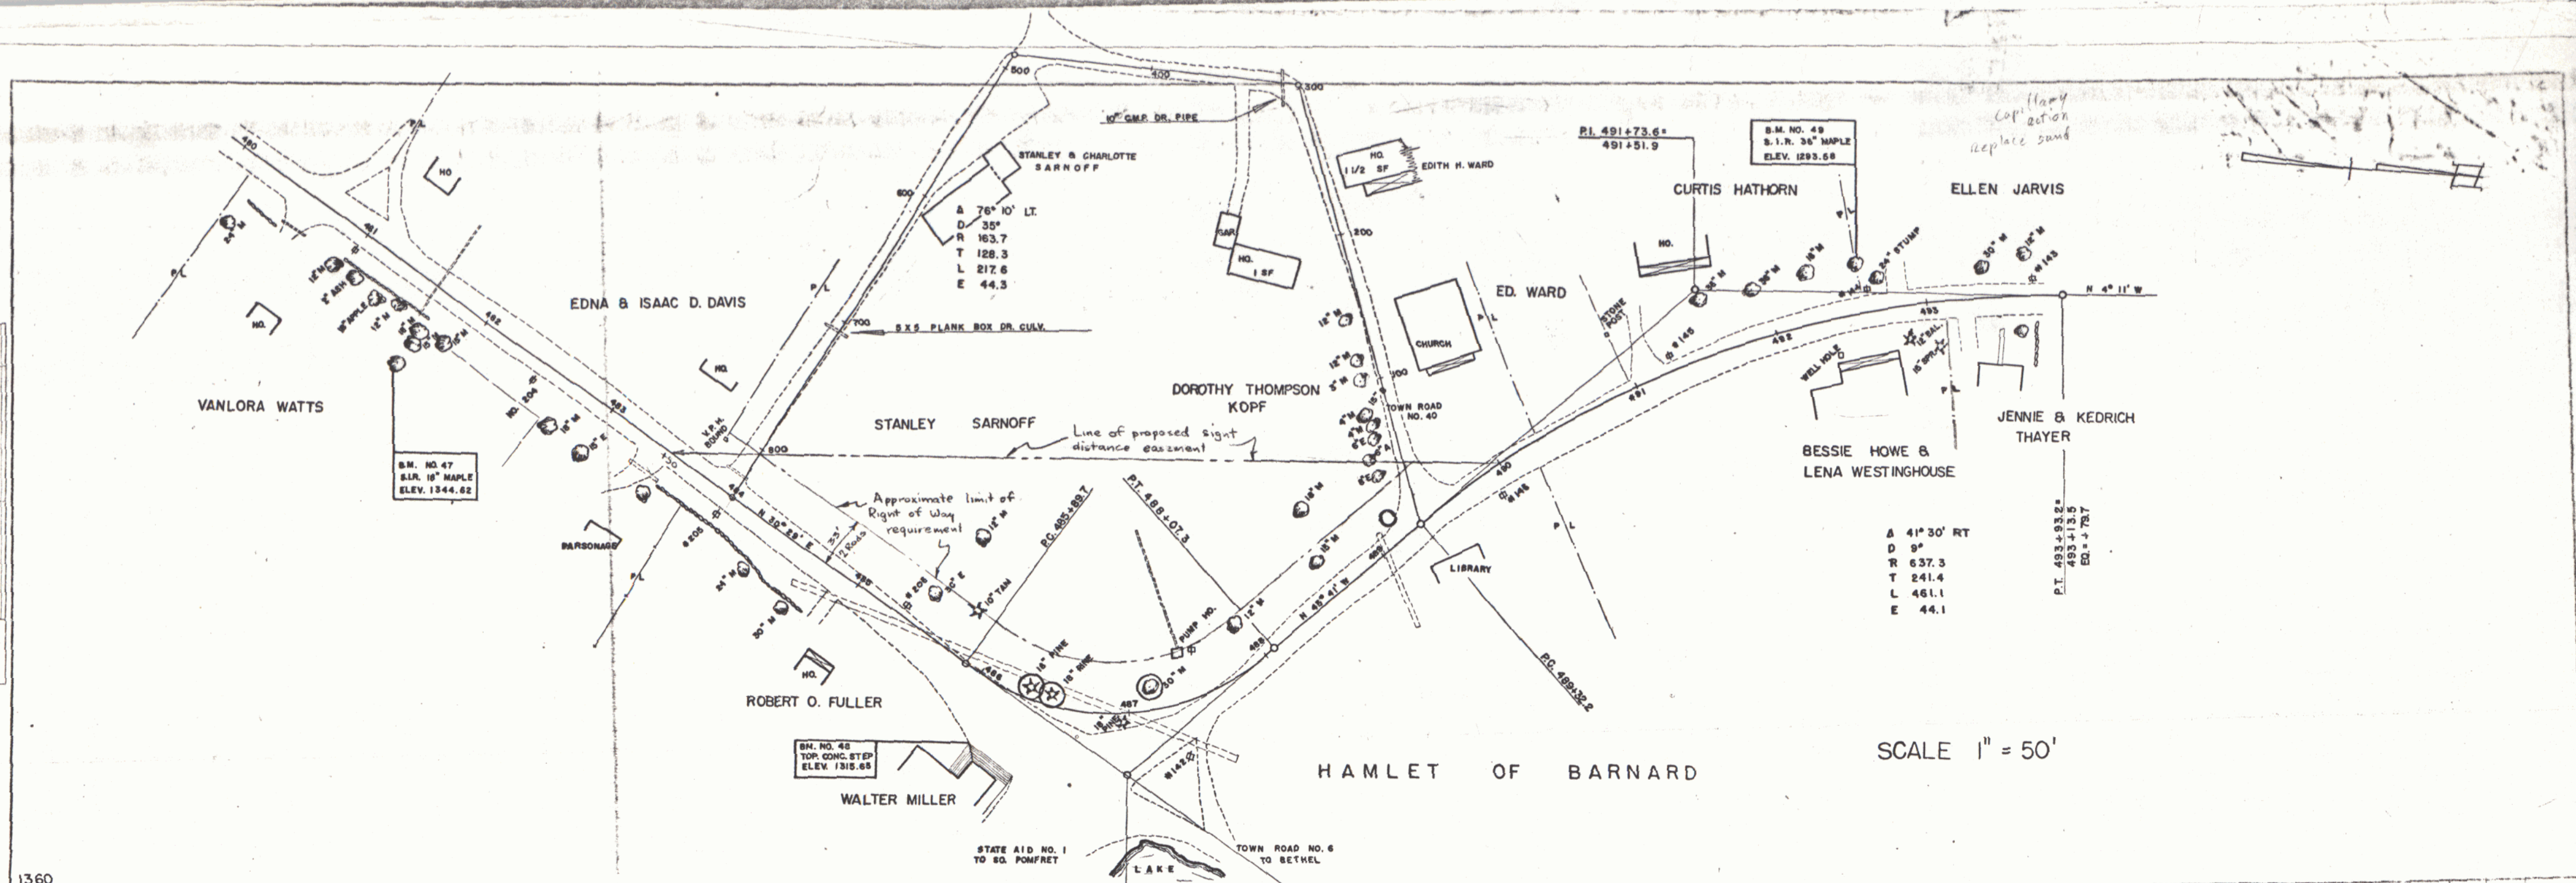


PLATE 1-PLAN PROFILE R. P. H. STANLAND
 ENGINEERING CO., CHICAGO-NEW YORK

BARNARD-BETHEL
 F 142 (2)
 SHEET 27A