



9-53
Speculating
A. Parker
11-53
Z.W. Espar

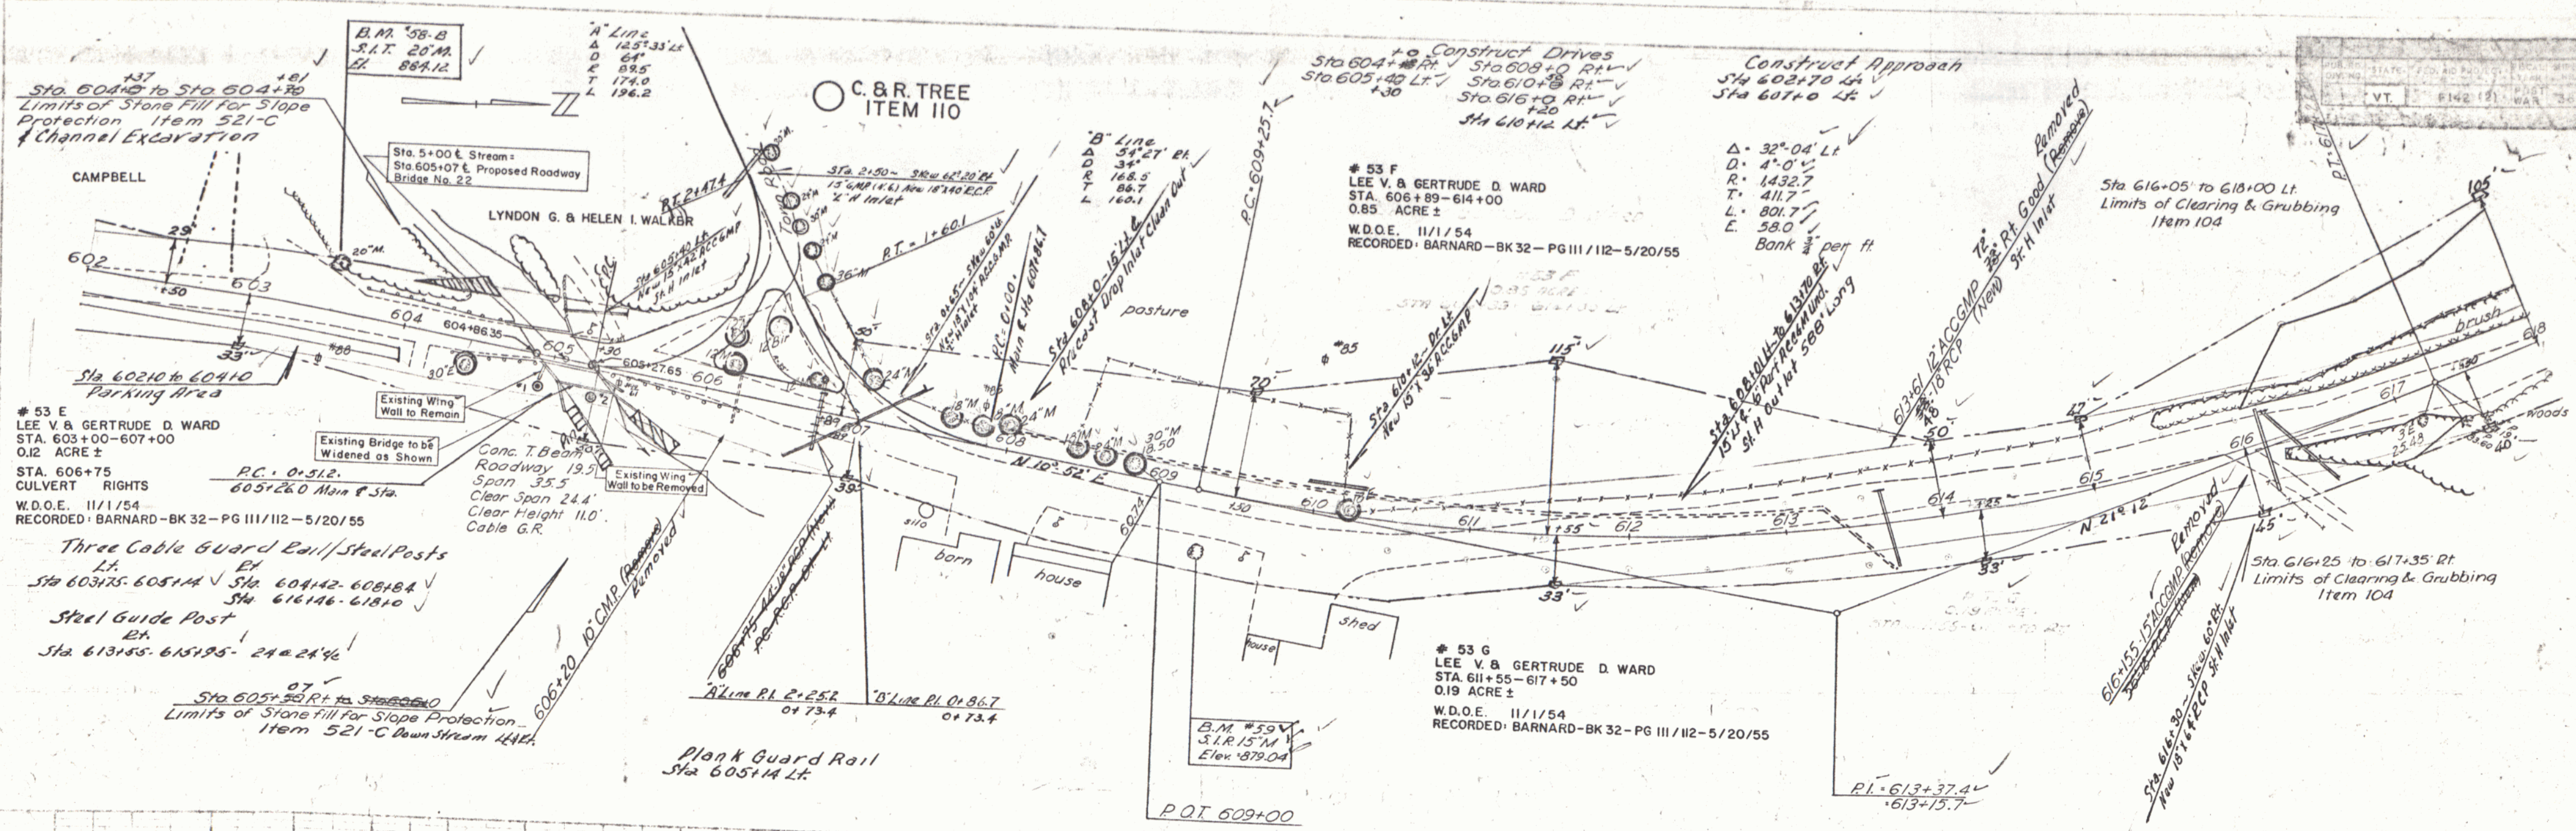

9-53
Speculating
A. Parker
11-53
Z.W. Espar

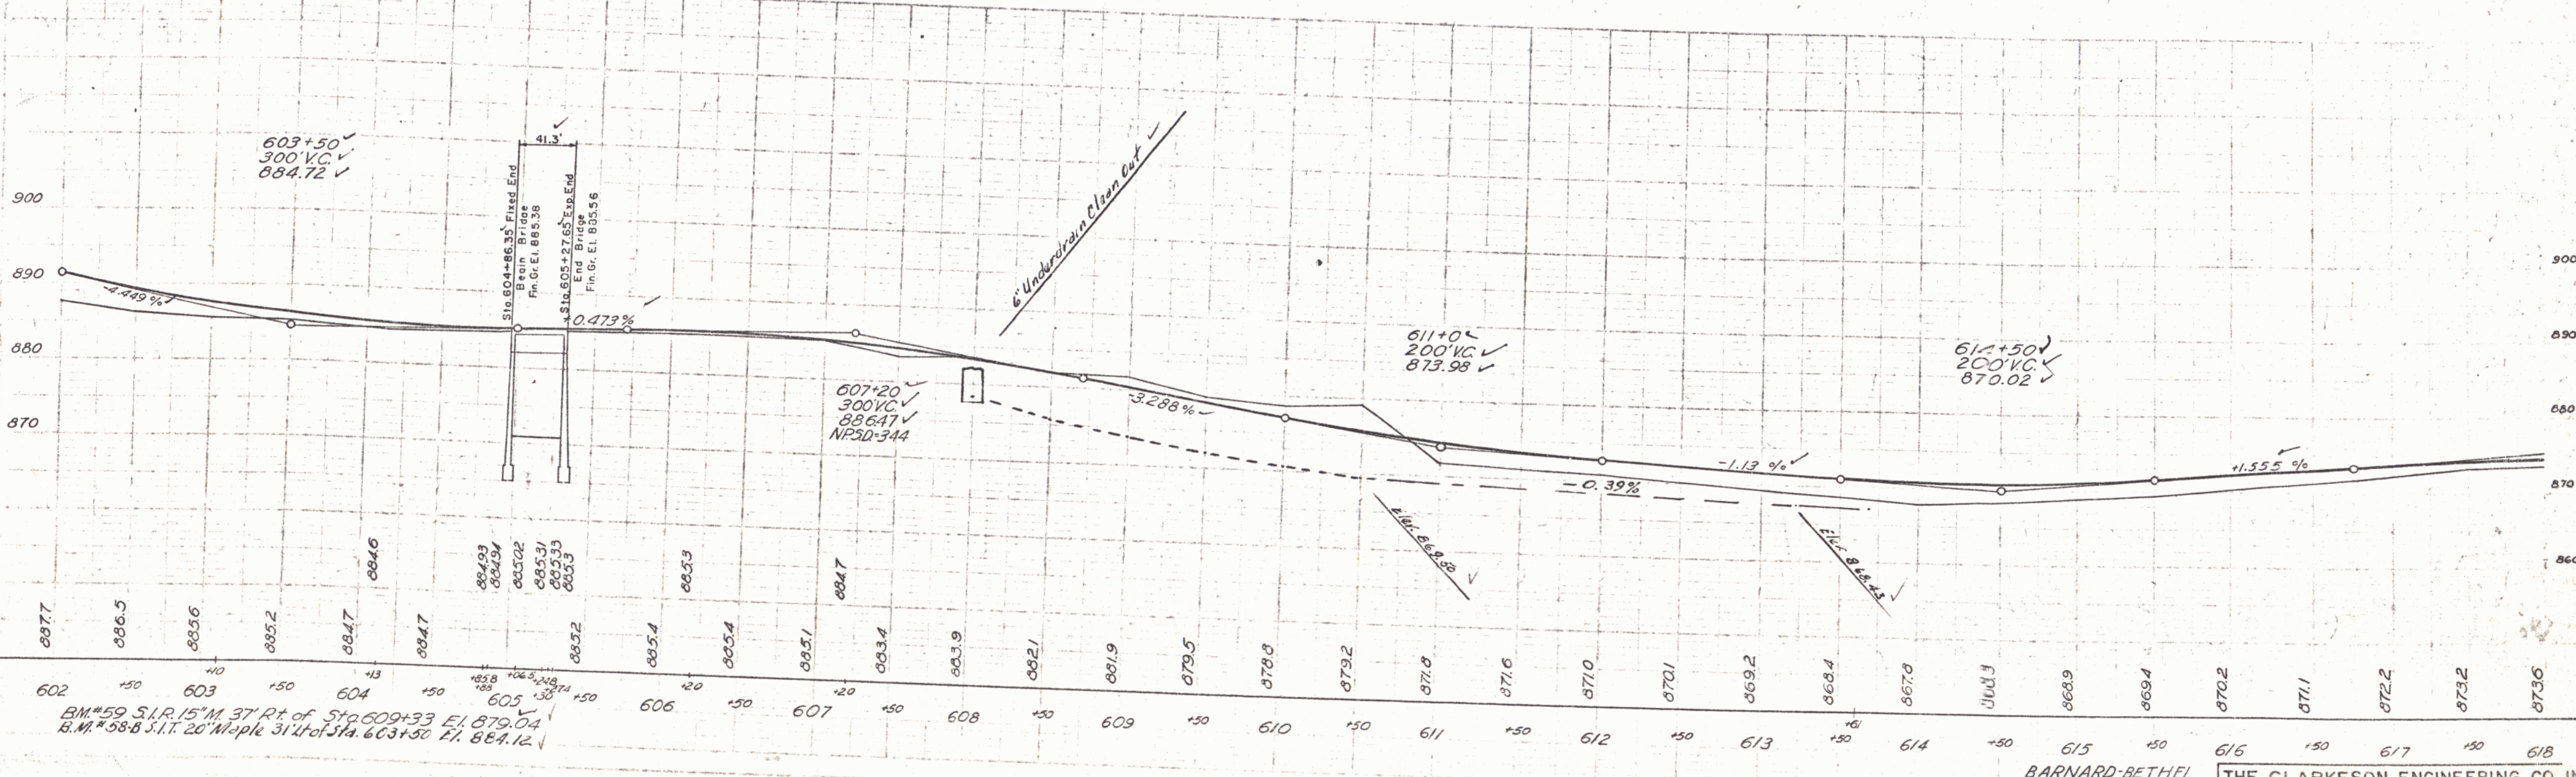

STATE OF VERMONT
 1942
 11-53

THE CLARKESON ENGINEERING CO., INC.
 CONSULTING ENGINEERS
 BOSTON MASSACHUSETTS