



VT F 142 (2) WAR 44 238

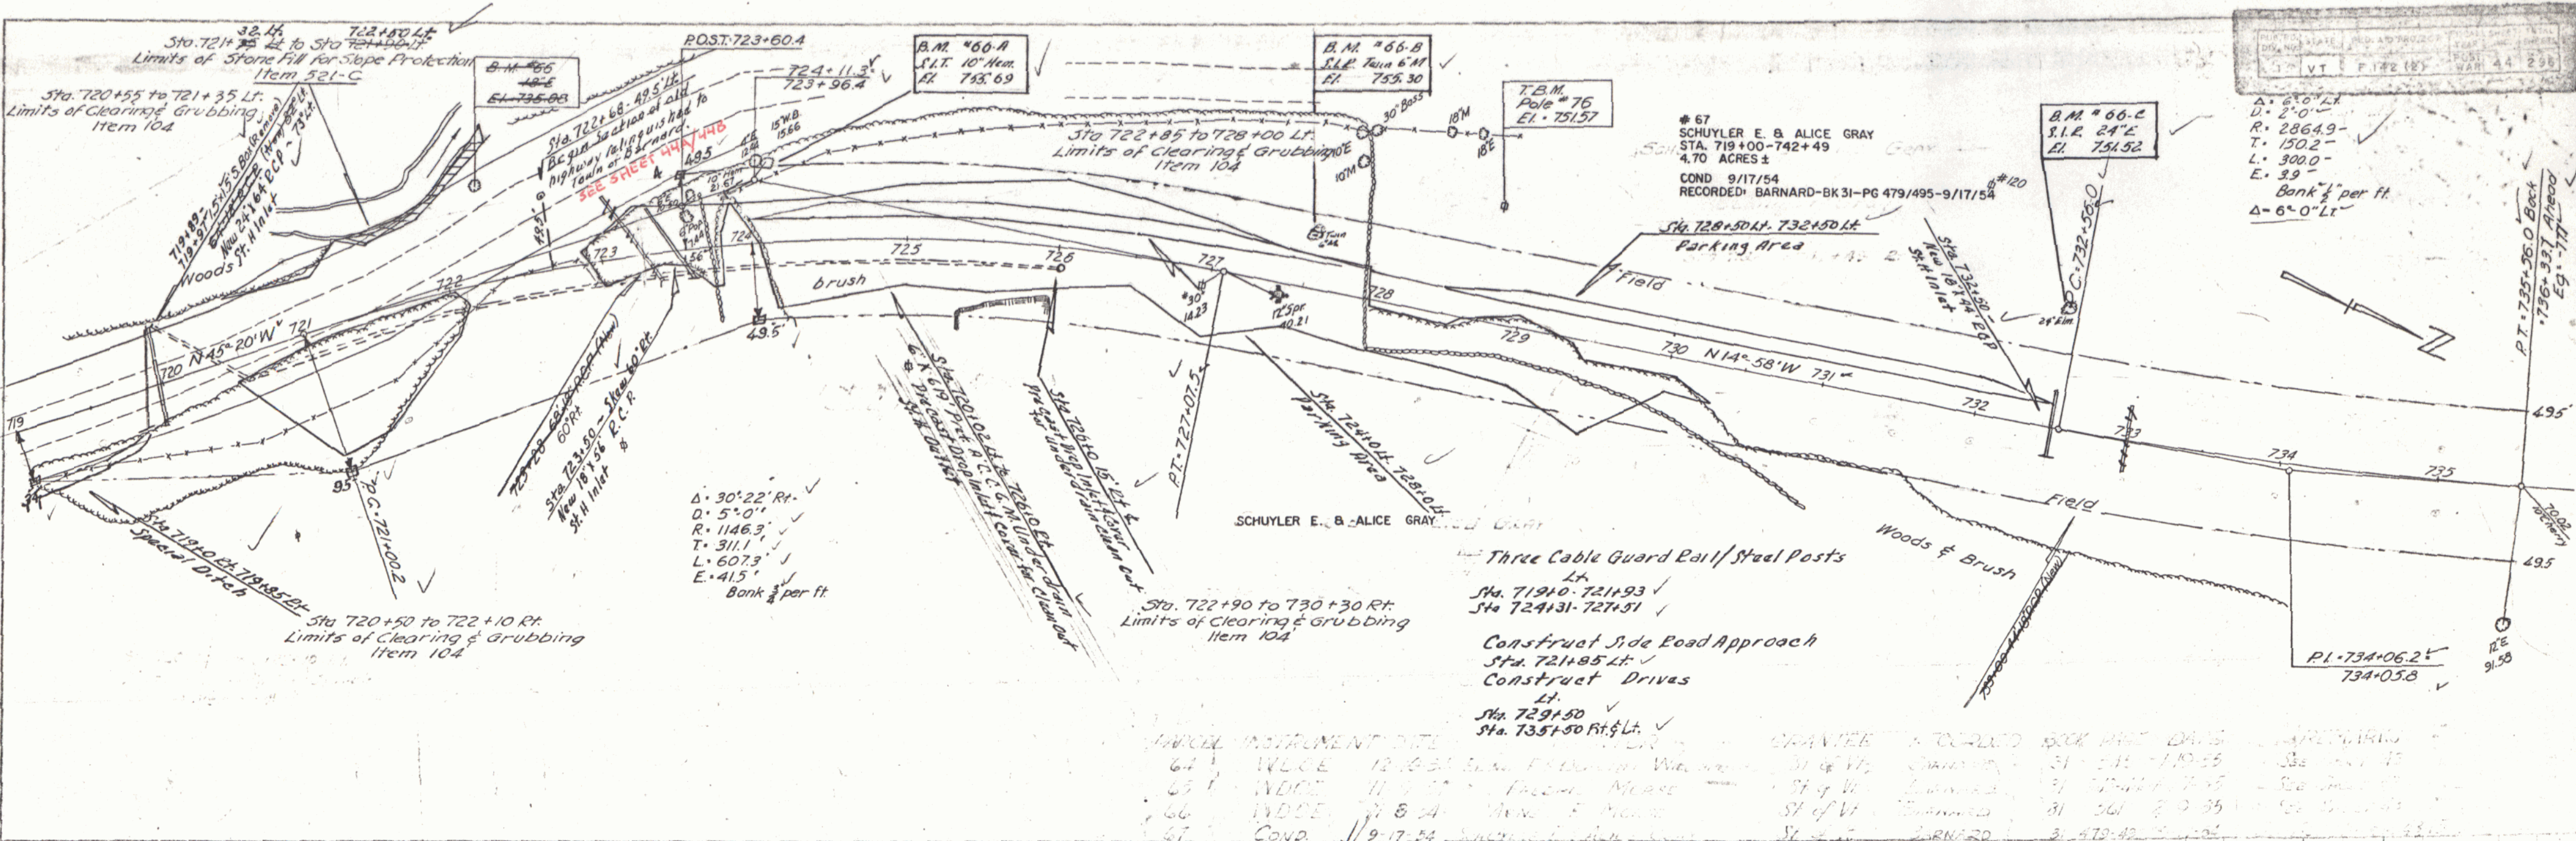

PARCEL INSTRUMENT DATE GRANTEE & RECORDED BOOK PAGE DATE

64	W.D.C.E.	12-18-51	Edw. F. Williams	31	511	1-19-55	See map
65	W.D.C.E.	11-2-51	Frederic Morse	27	511	7-15-55	See map
66	W.D.C.E.	7-8-54	James F. Morse	31	561	8-2-55	See map
67	COND.	9-17-54	BARNARD-BK 31-PG 479/495	31	479-495	9-17-54	

Control of section of old highway between Station 722+68-49.5 Lt. and Station 746+08-336 Lt. relinquished to Town of Barnard Recorded in Book 32, Page 714, of Highway Records. date, 3rd. December, 1957.

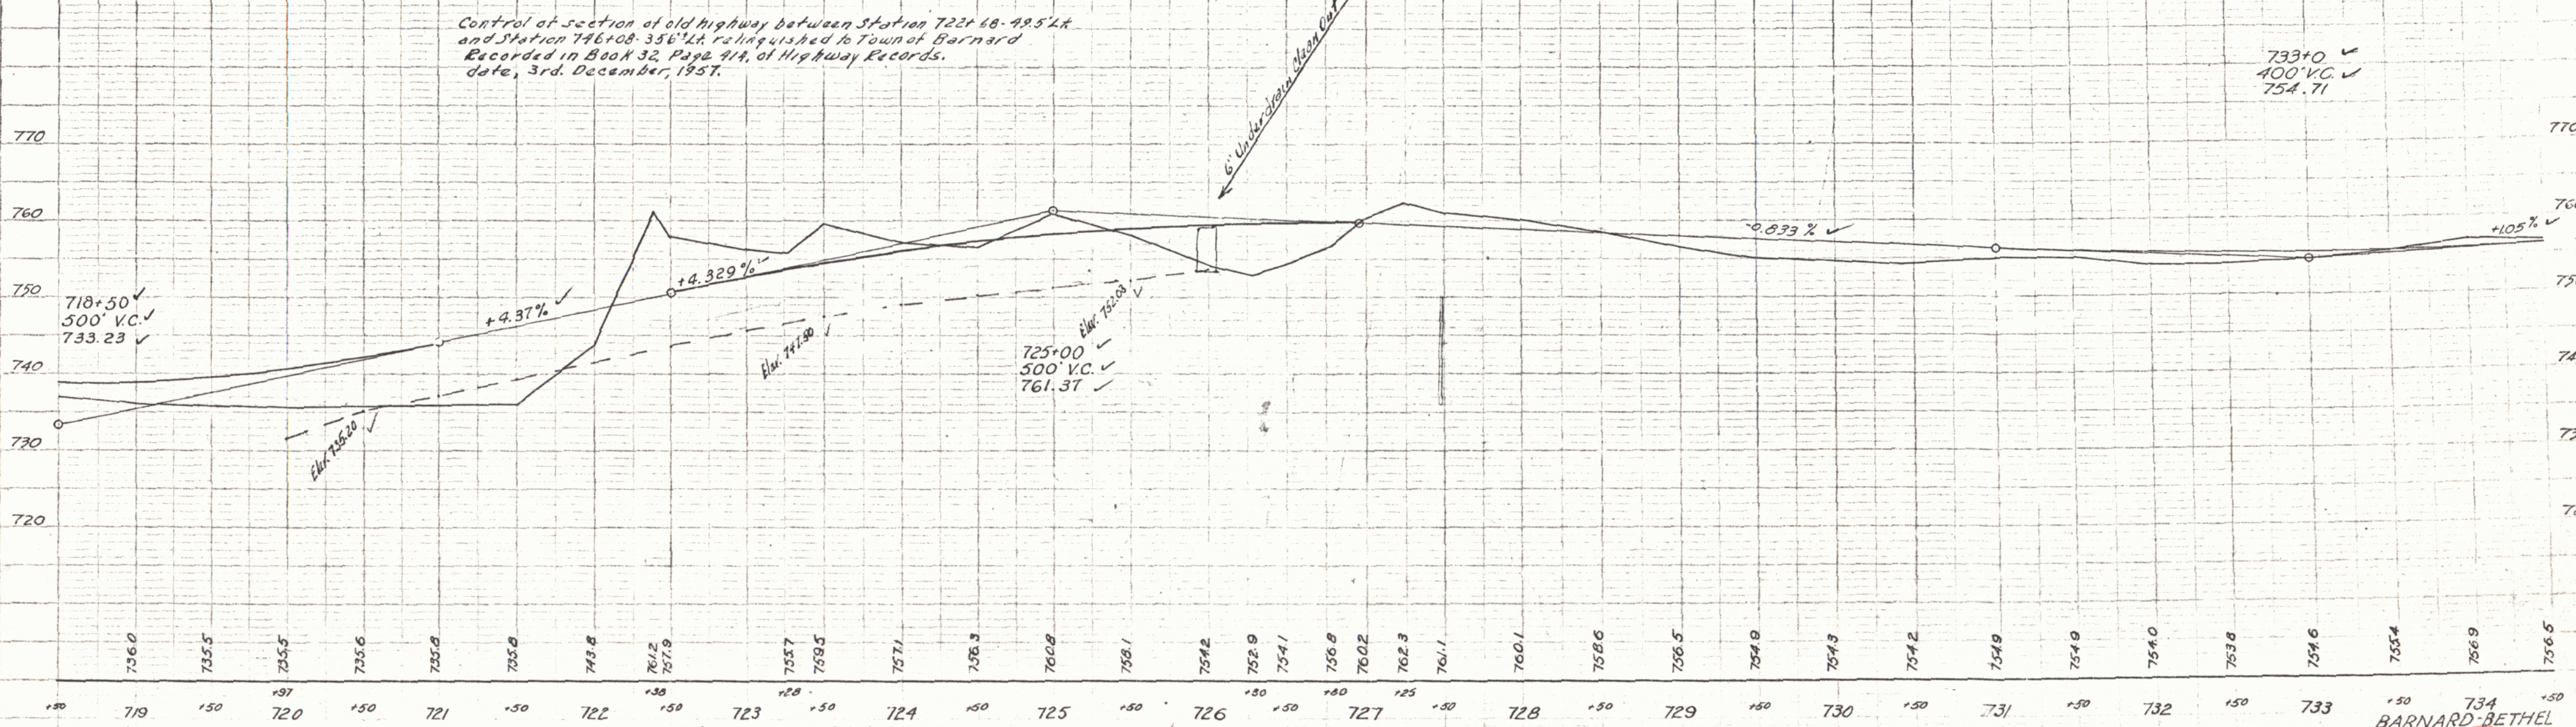

B.M. #66 S.I.T. 10' Hem. 35' Lt. of Sta. 723+80 El. 755.69
 B.M. #66-B S.I.R. Twp 6' M 35' Lt. of Sta. 727+00 El. 755.30
 B.M. #66-C S.I.R. 24' El. 01' Lt. of Sta. 732+50 El. 754.52