

○ C. & R. TREE
ITEM IIO

Three Cable Guard Rail / Steel Posts
Lt. Sta. 795+18-796+14
Rt. Sta. 796+92-797+08
Sta. 795+90-796+38
Sta. 797+16-797+48
Sta. 801+50-802+50

Plank Guard Rail
Lt. Sta. 797+08

Construct Drives
Sta. 794+20 Lt.
Sta. 794+70 Rt.

Non-Gov't Participation
2" Bituminous Concrete Paving
for Bridge Deck - Sta. 796+24 to 797+08
Three Cable Guard Rail / Steel Posts
Non-Gov't Participation

Sta. 797+35 to 798+45 Lt.
Limits of Clearing & Grubbing
Item 104

Construct Drives
Lt. Sta. 794+15
Rt. Sta. 794+75
Sta. 797+12 Lt.
Sta. 795+80 Rt.
Sta. 797+65 Rt.

#71 A
ROY J. & LAURA M. STILLWELL
Sta. 796+14-796+92 Lt. Sta. 796+38-797+16 Rt.
STA. 788+99-794+50
0.55 ACRE ±
W.D. 10/30/54
RECORDED: BETHEL-BK.40-PG.541-5/20/55
NOTE: SEE SHEET 49

Conc. I Beam Bridge
Cable Rail
Clear Height 10'
Clear Span 38.5'

#72 A
FLORENCE E. & CLARENCE A. SHARPE
Sta. 797+25-798+50
SLOPE RIGHTS

Sta. 798+01 Lt.-801+50 Rt.
Parking Area

Sta. 794+49 Skew 76° Rt.
4" x 40' Bit. Fib. bar Water Pipe Sleeve
Furnished by Property Owner
ROY J. & LAURA M. STILLWELL
off Sta. 3.

Sta. 794+49 Non Gov't Participation
Install sleeve for water pipe across
roadway, item 103. (Non Gov't)
Sleeve to be furnish by Property Owner.


#71 B
ROY J. & LAURA M. STILLWELL
Sta. 800+15-800+79
0.34 ACRE ±
W.D. 10/30/54
RECORDED: BETHEL-BK.40-PG.541-5/20/55

#73 A
GLENN M. & ANNA L. BULLARD
Sta. 800+66-809+50
1.45 ACRES ±
W.D.O.E. 11/1/54
RECORDED: BETHEL-BK.40-PG.543-5/20/55

STA. 794.49 = STA. 6+91

B.M. #71
Conc. Post
Elev. 605.26

NO.	DATE	BY	RECORDED	DATE	REMARKS
71 A	10-30-54	ROY J. & LAURA M. STILLWELL	BETHEL	40	5-20-55 See Also Sheet 49
72 A	11-1-54	FLORENCE E. & CLARENCE A. SHARPE	BETHEL	40	5-20-55 See Also Sheet 51
73 A	11-1-54	GLENN M. & ANNA L. BULLARD	BETHEL	40	5-20-55 See Also Sheet 51
73 B	11-1-54	GLENN M. & ANNA L. BULLARD	BETHEL	41	5-20-55 See Also Sheet 51

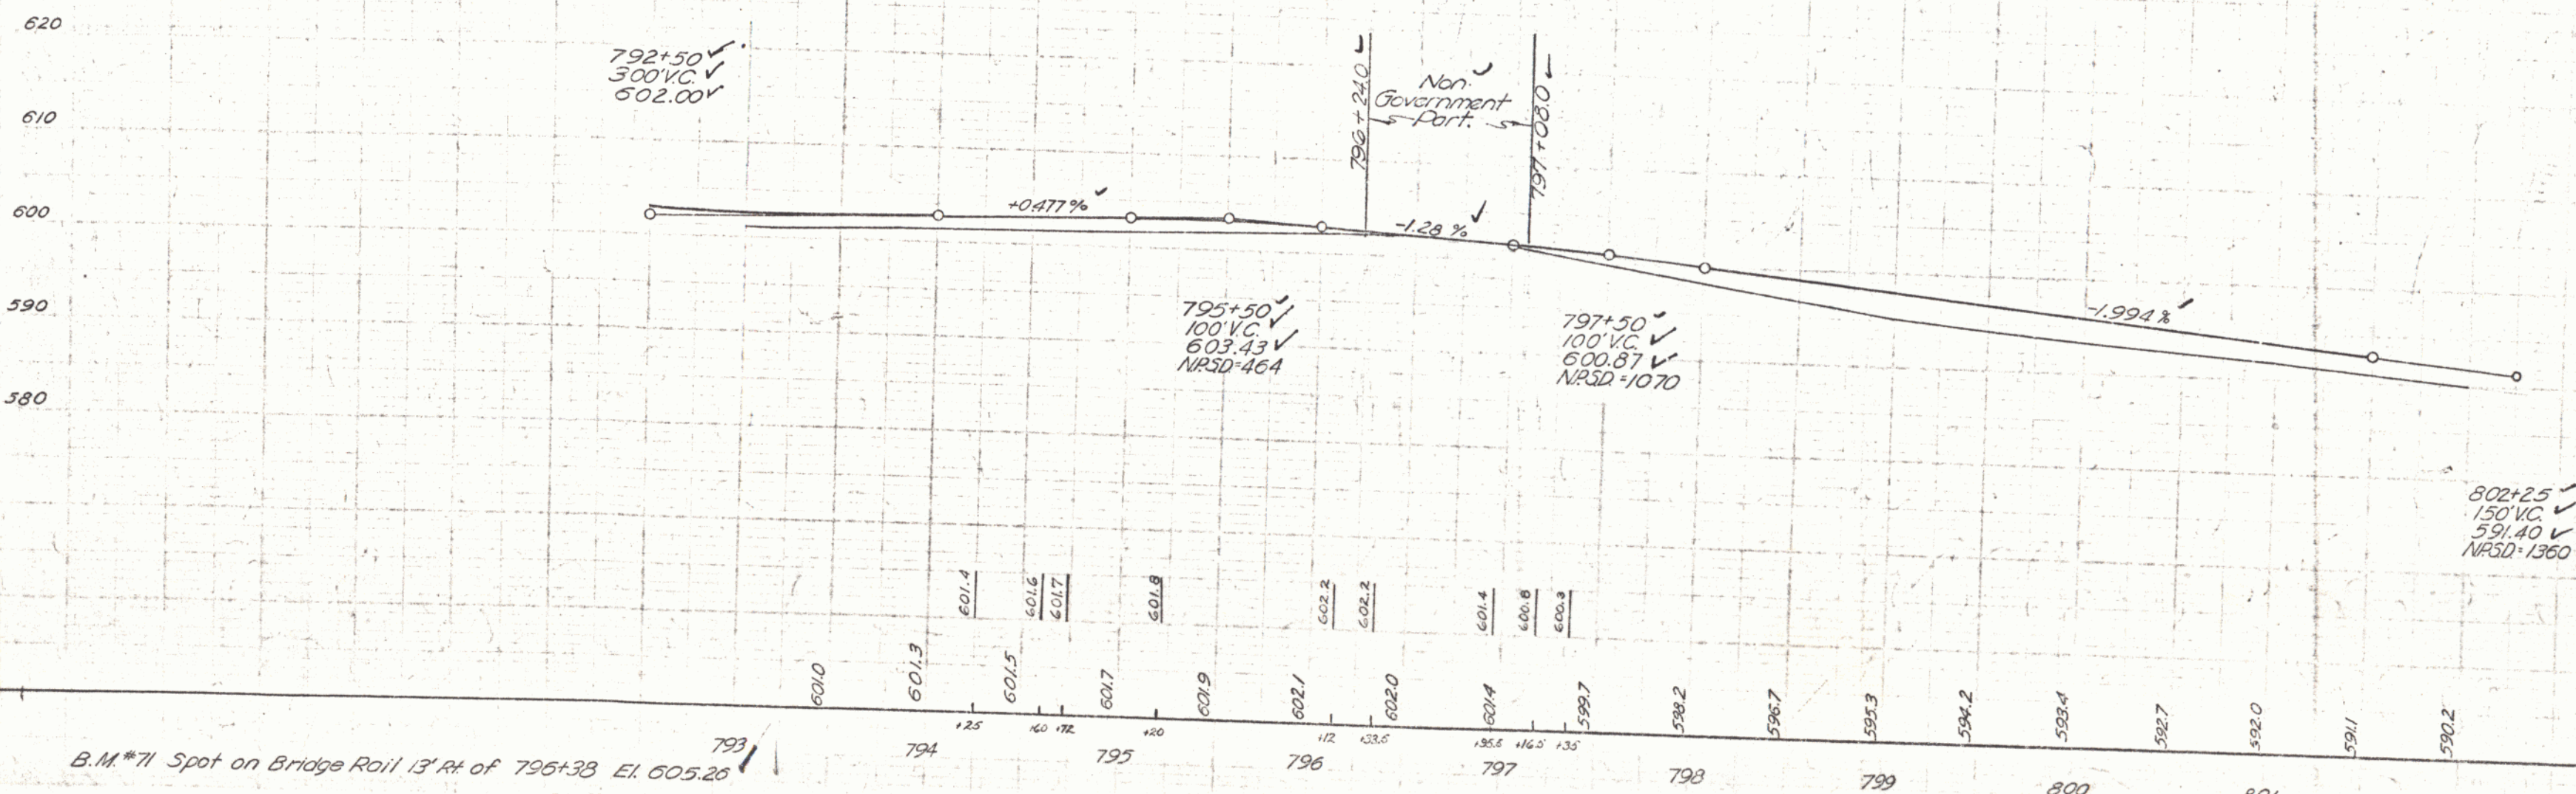

B.M. #71 Spot on Bridge Rail 13' Rt of 796+38 El. 605.26

BARNARD-BETHEL