


PLAN
 DATE: 12/31/74
 DRAWN BY: [illegible]
 CHECKED BY: [illegible]
 PROJECT: [illegible]

PROFILE
 DATE: 12/31/74
 DRAWN BY: [illegible]
 CHECKED BY: [illegible]
 PROJECT: [illegible]

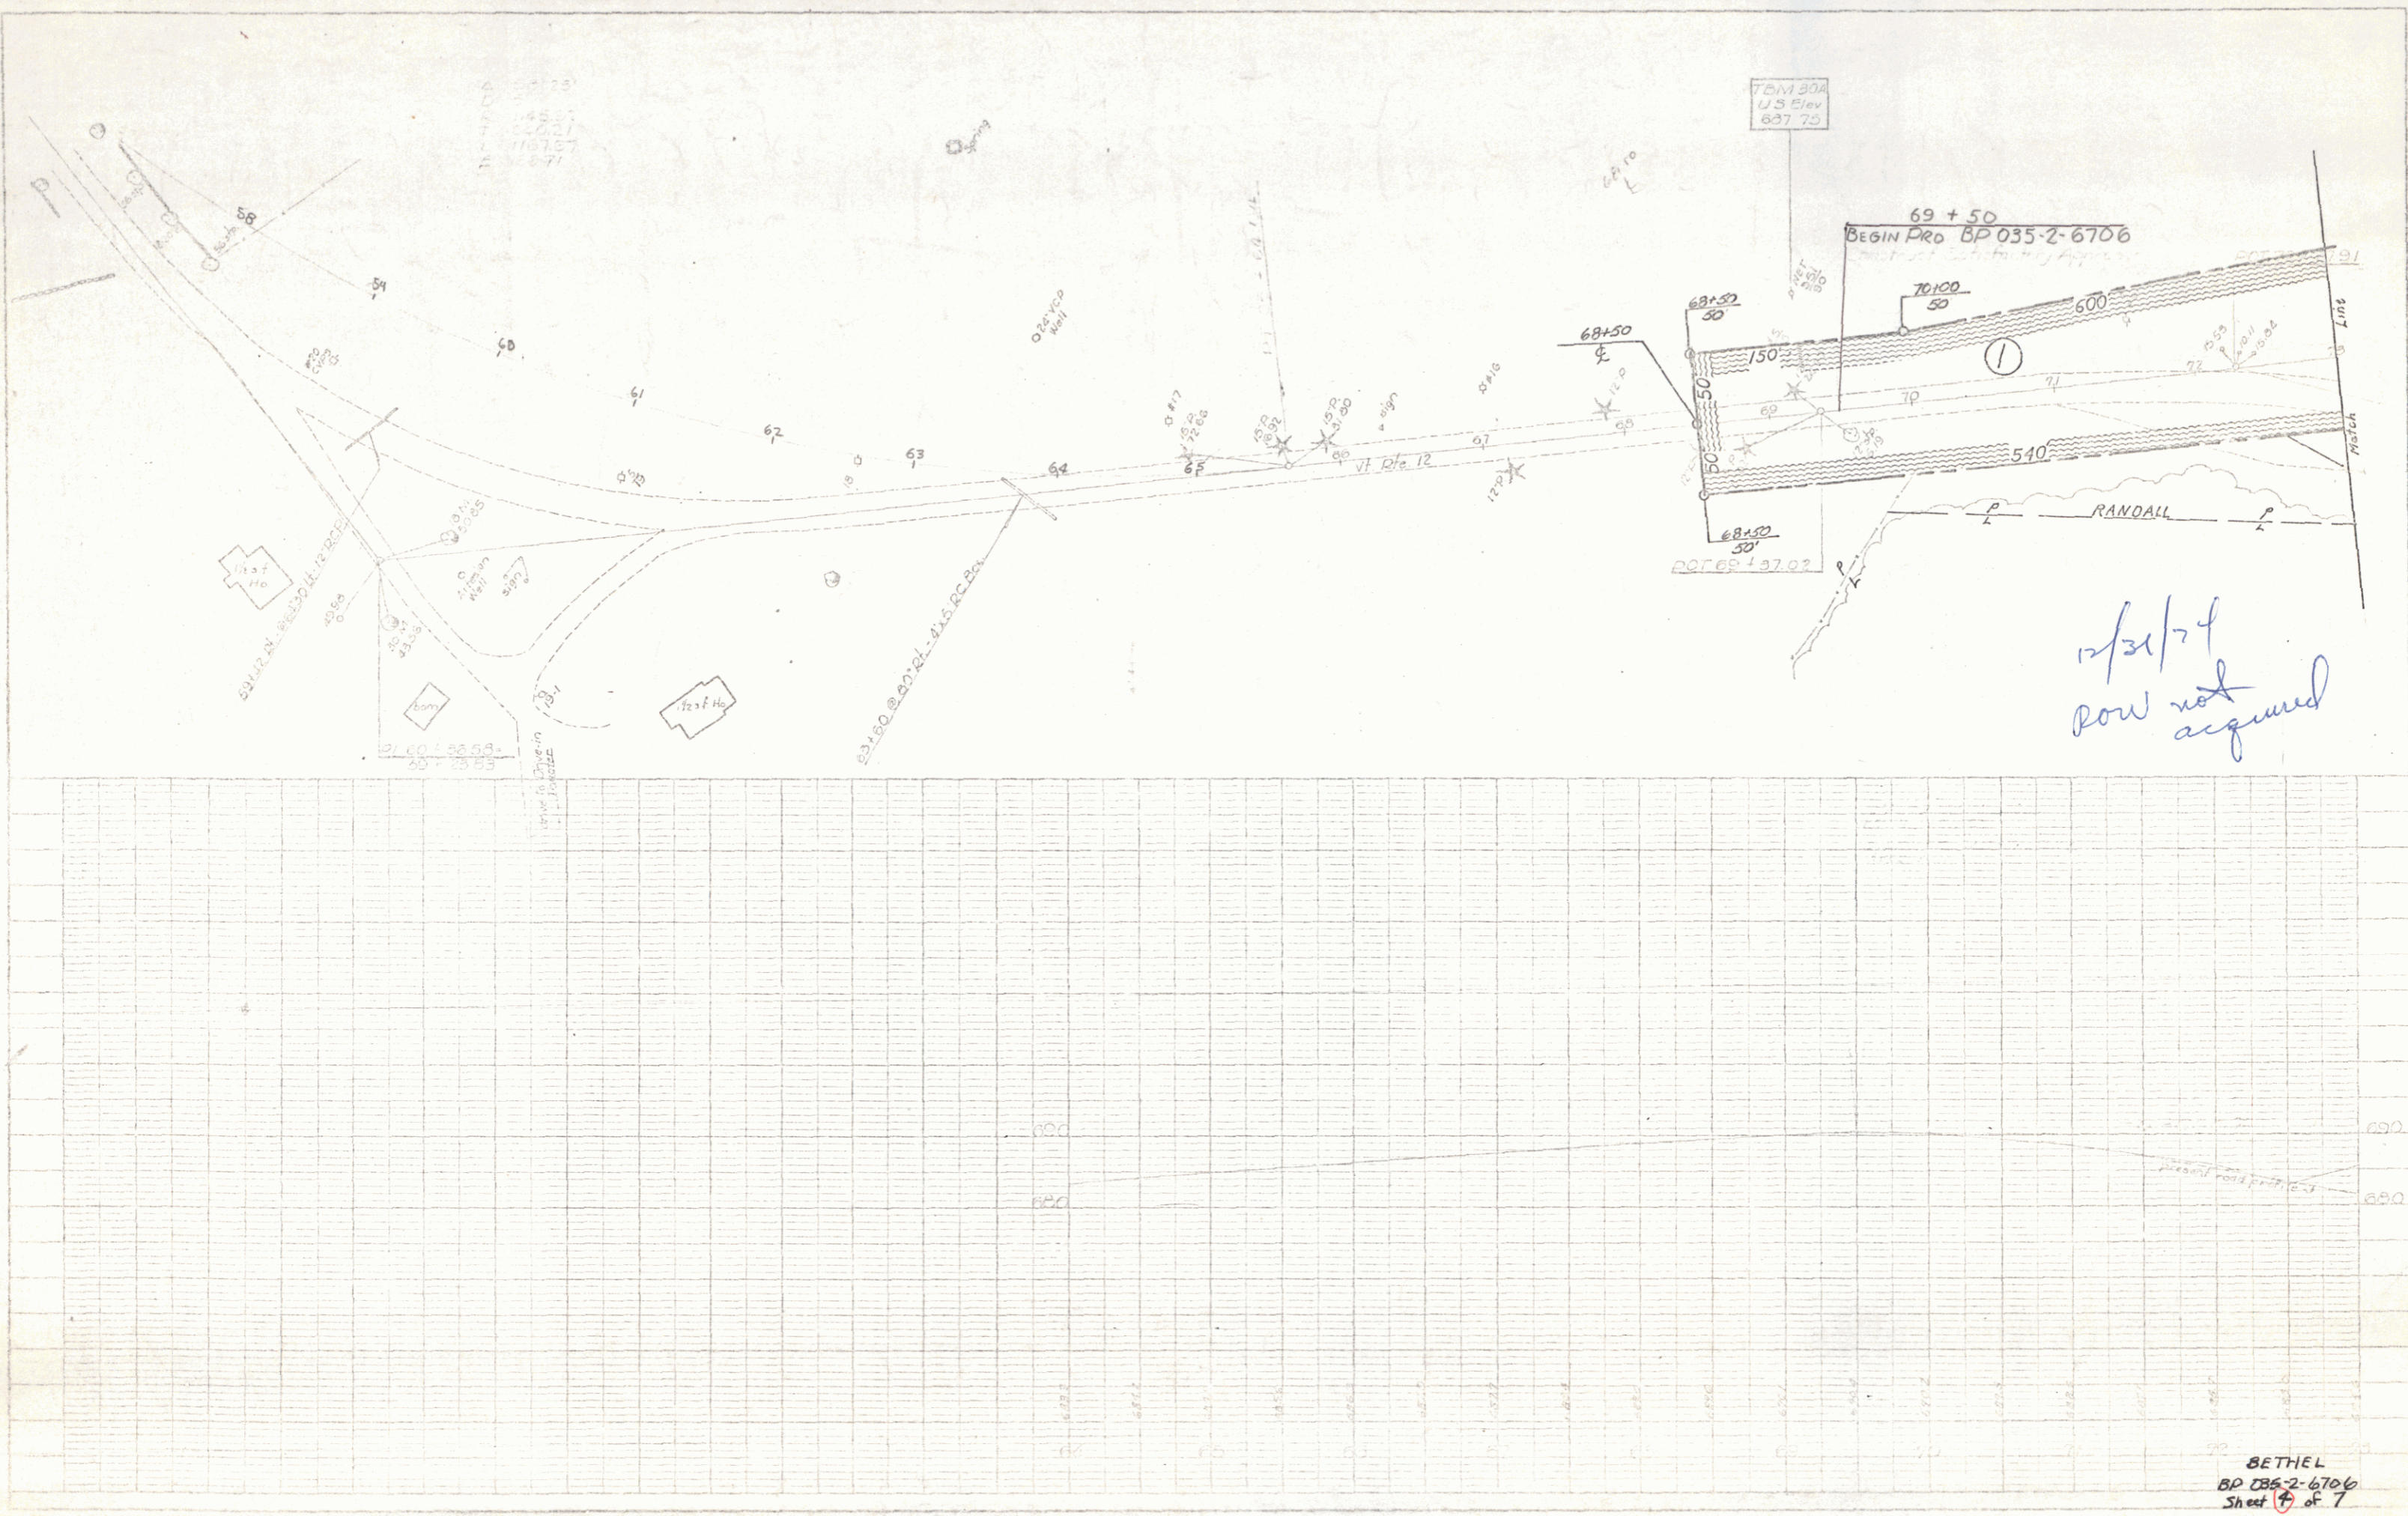

12/31/74
 ROW not
 acquired

BETHEL
 BP 035-2-6706
 Sheet 6 of 7