


Construct Approach
73+00 - 75+50 RA.

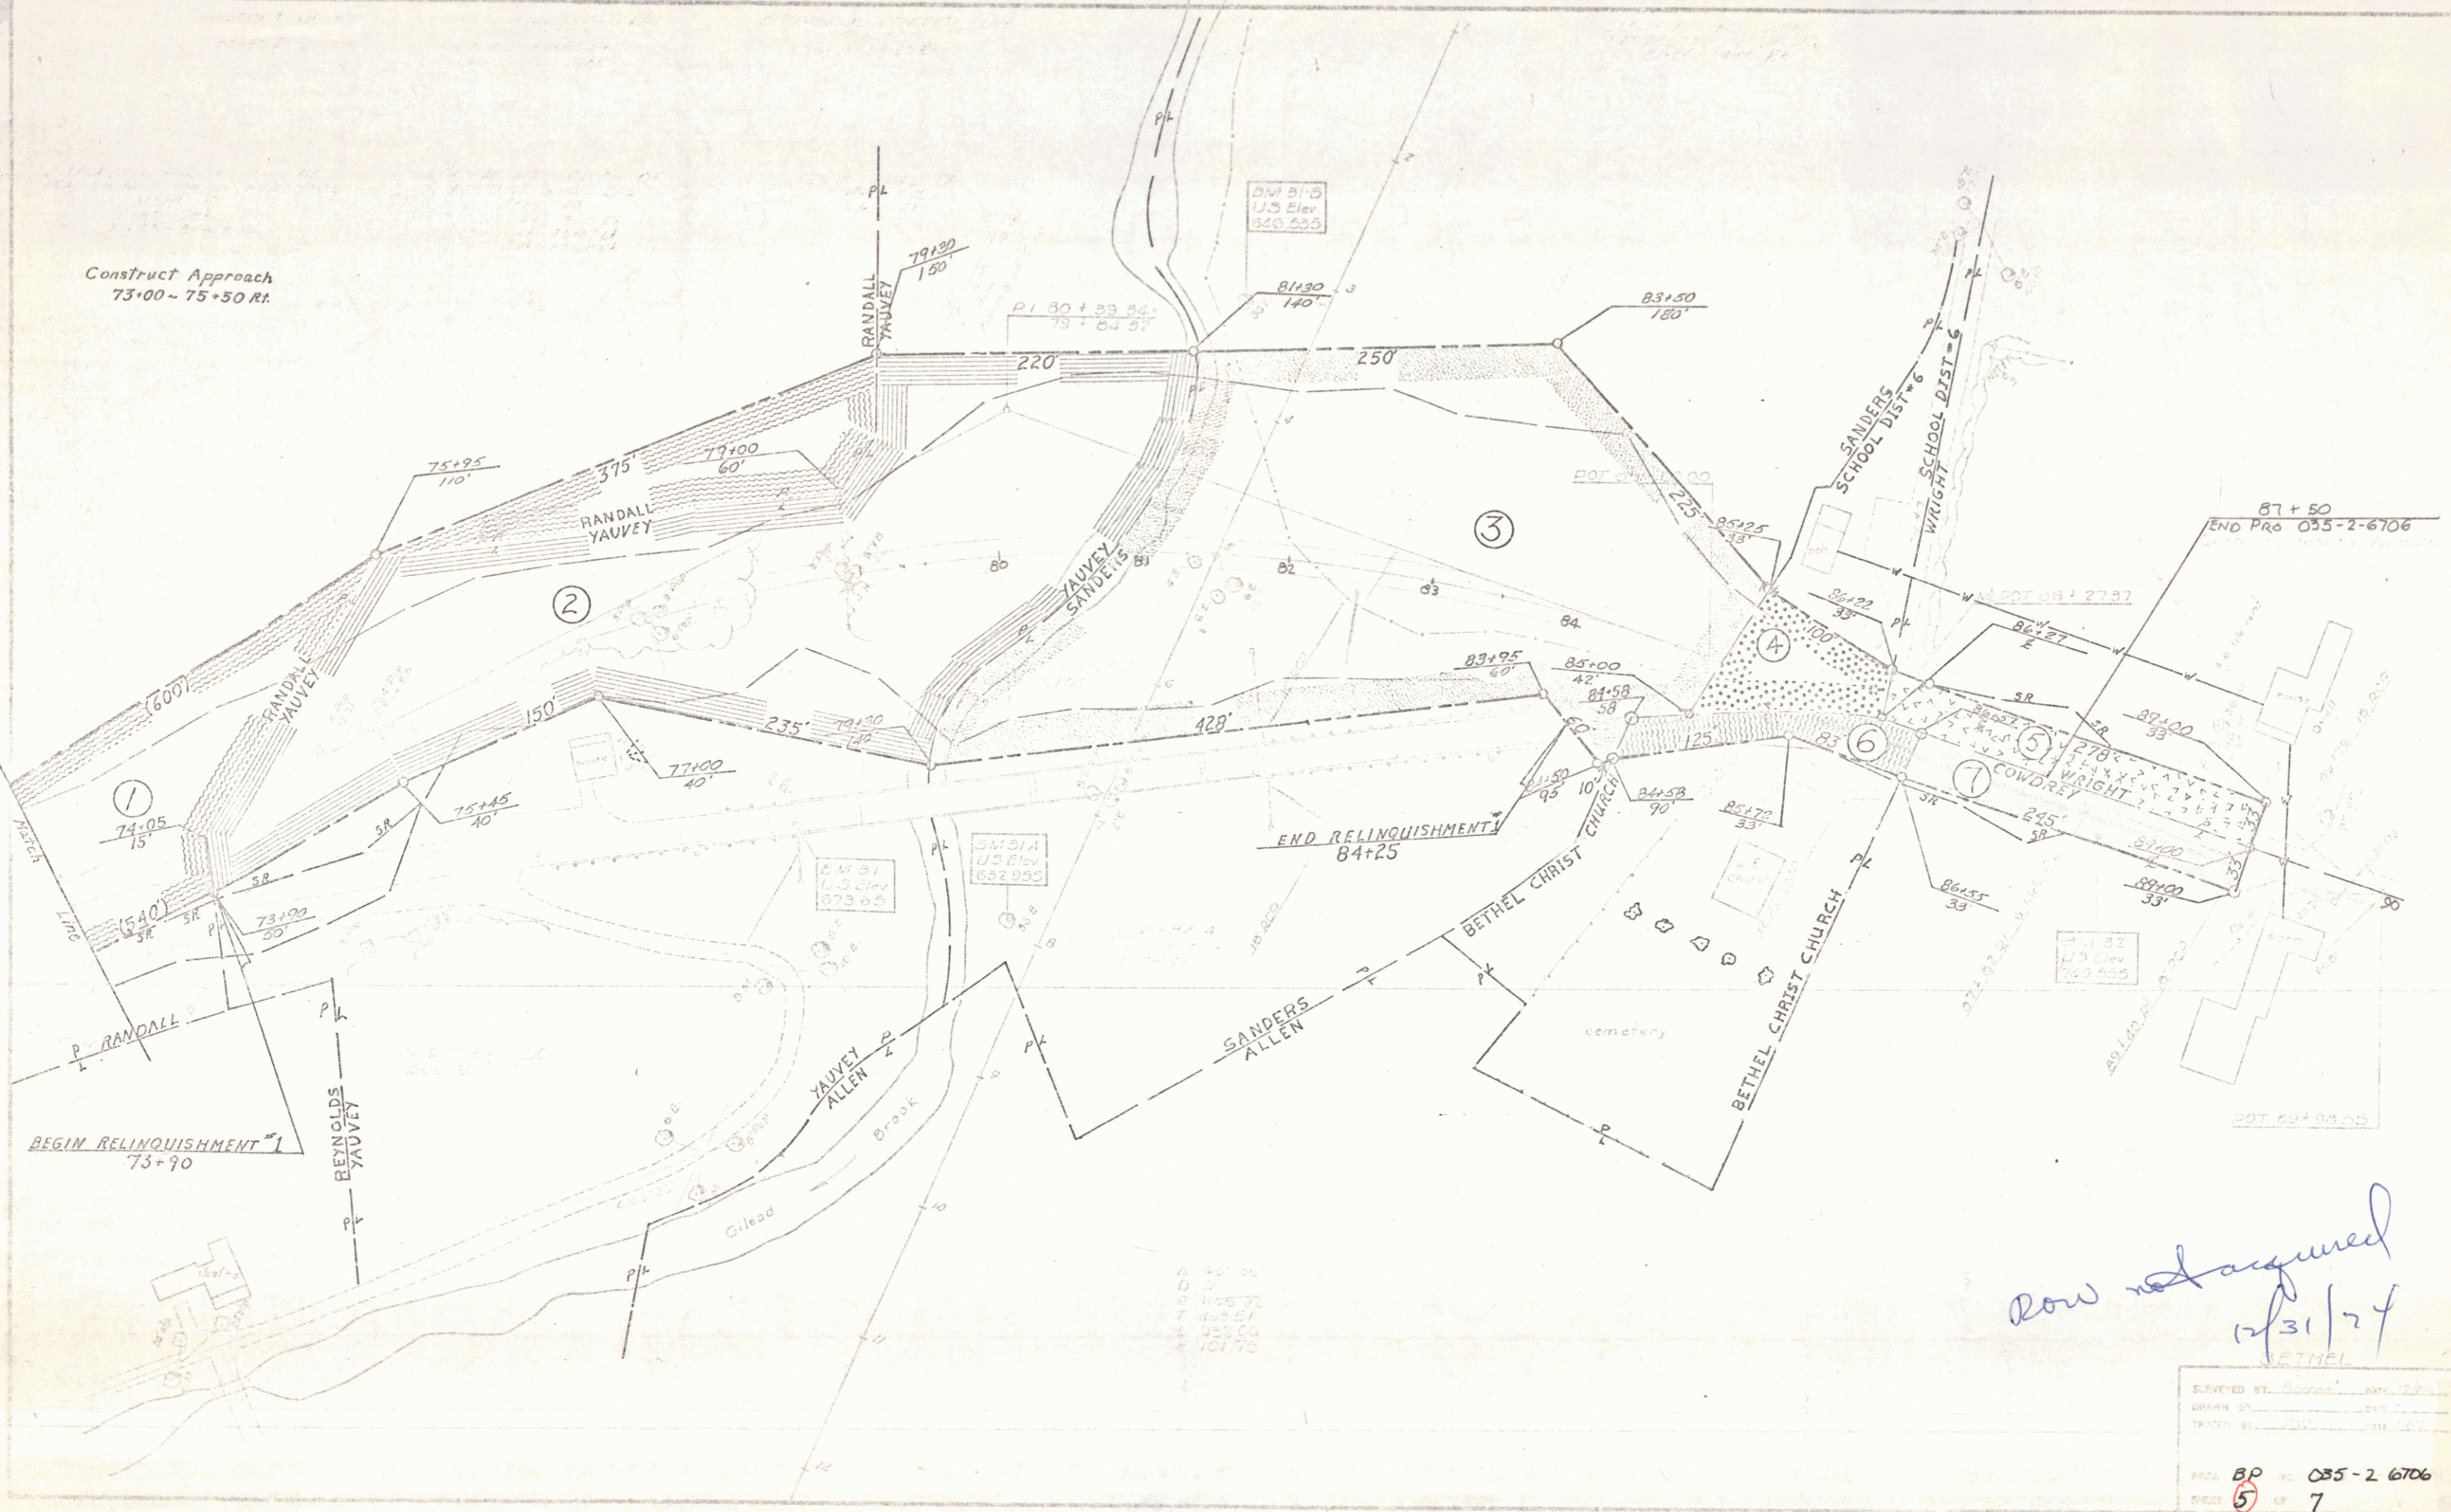

ROW not acquired
12/31/74

SURVEYED BY: _____ DATE: _____
DRAWN BY: _____ DATE: _____
TRACED BY: _____ DATE: _____
PROJ. NO. 035-2-6706
SHEET 5 OF 7