


PLAN
 DATE: 12/31/74
 DRAWN BY: [illegible]
 CHECKED BY: [illegible]
 PROJECT: [illegible]


PROFILE
 DATE: 12/31/74
 DRAWN BY: [illegible]
 CHECKED BY: [illegible]
 PROJECT: [illegible]

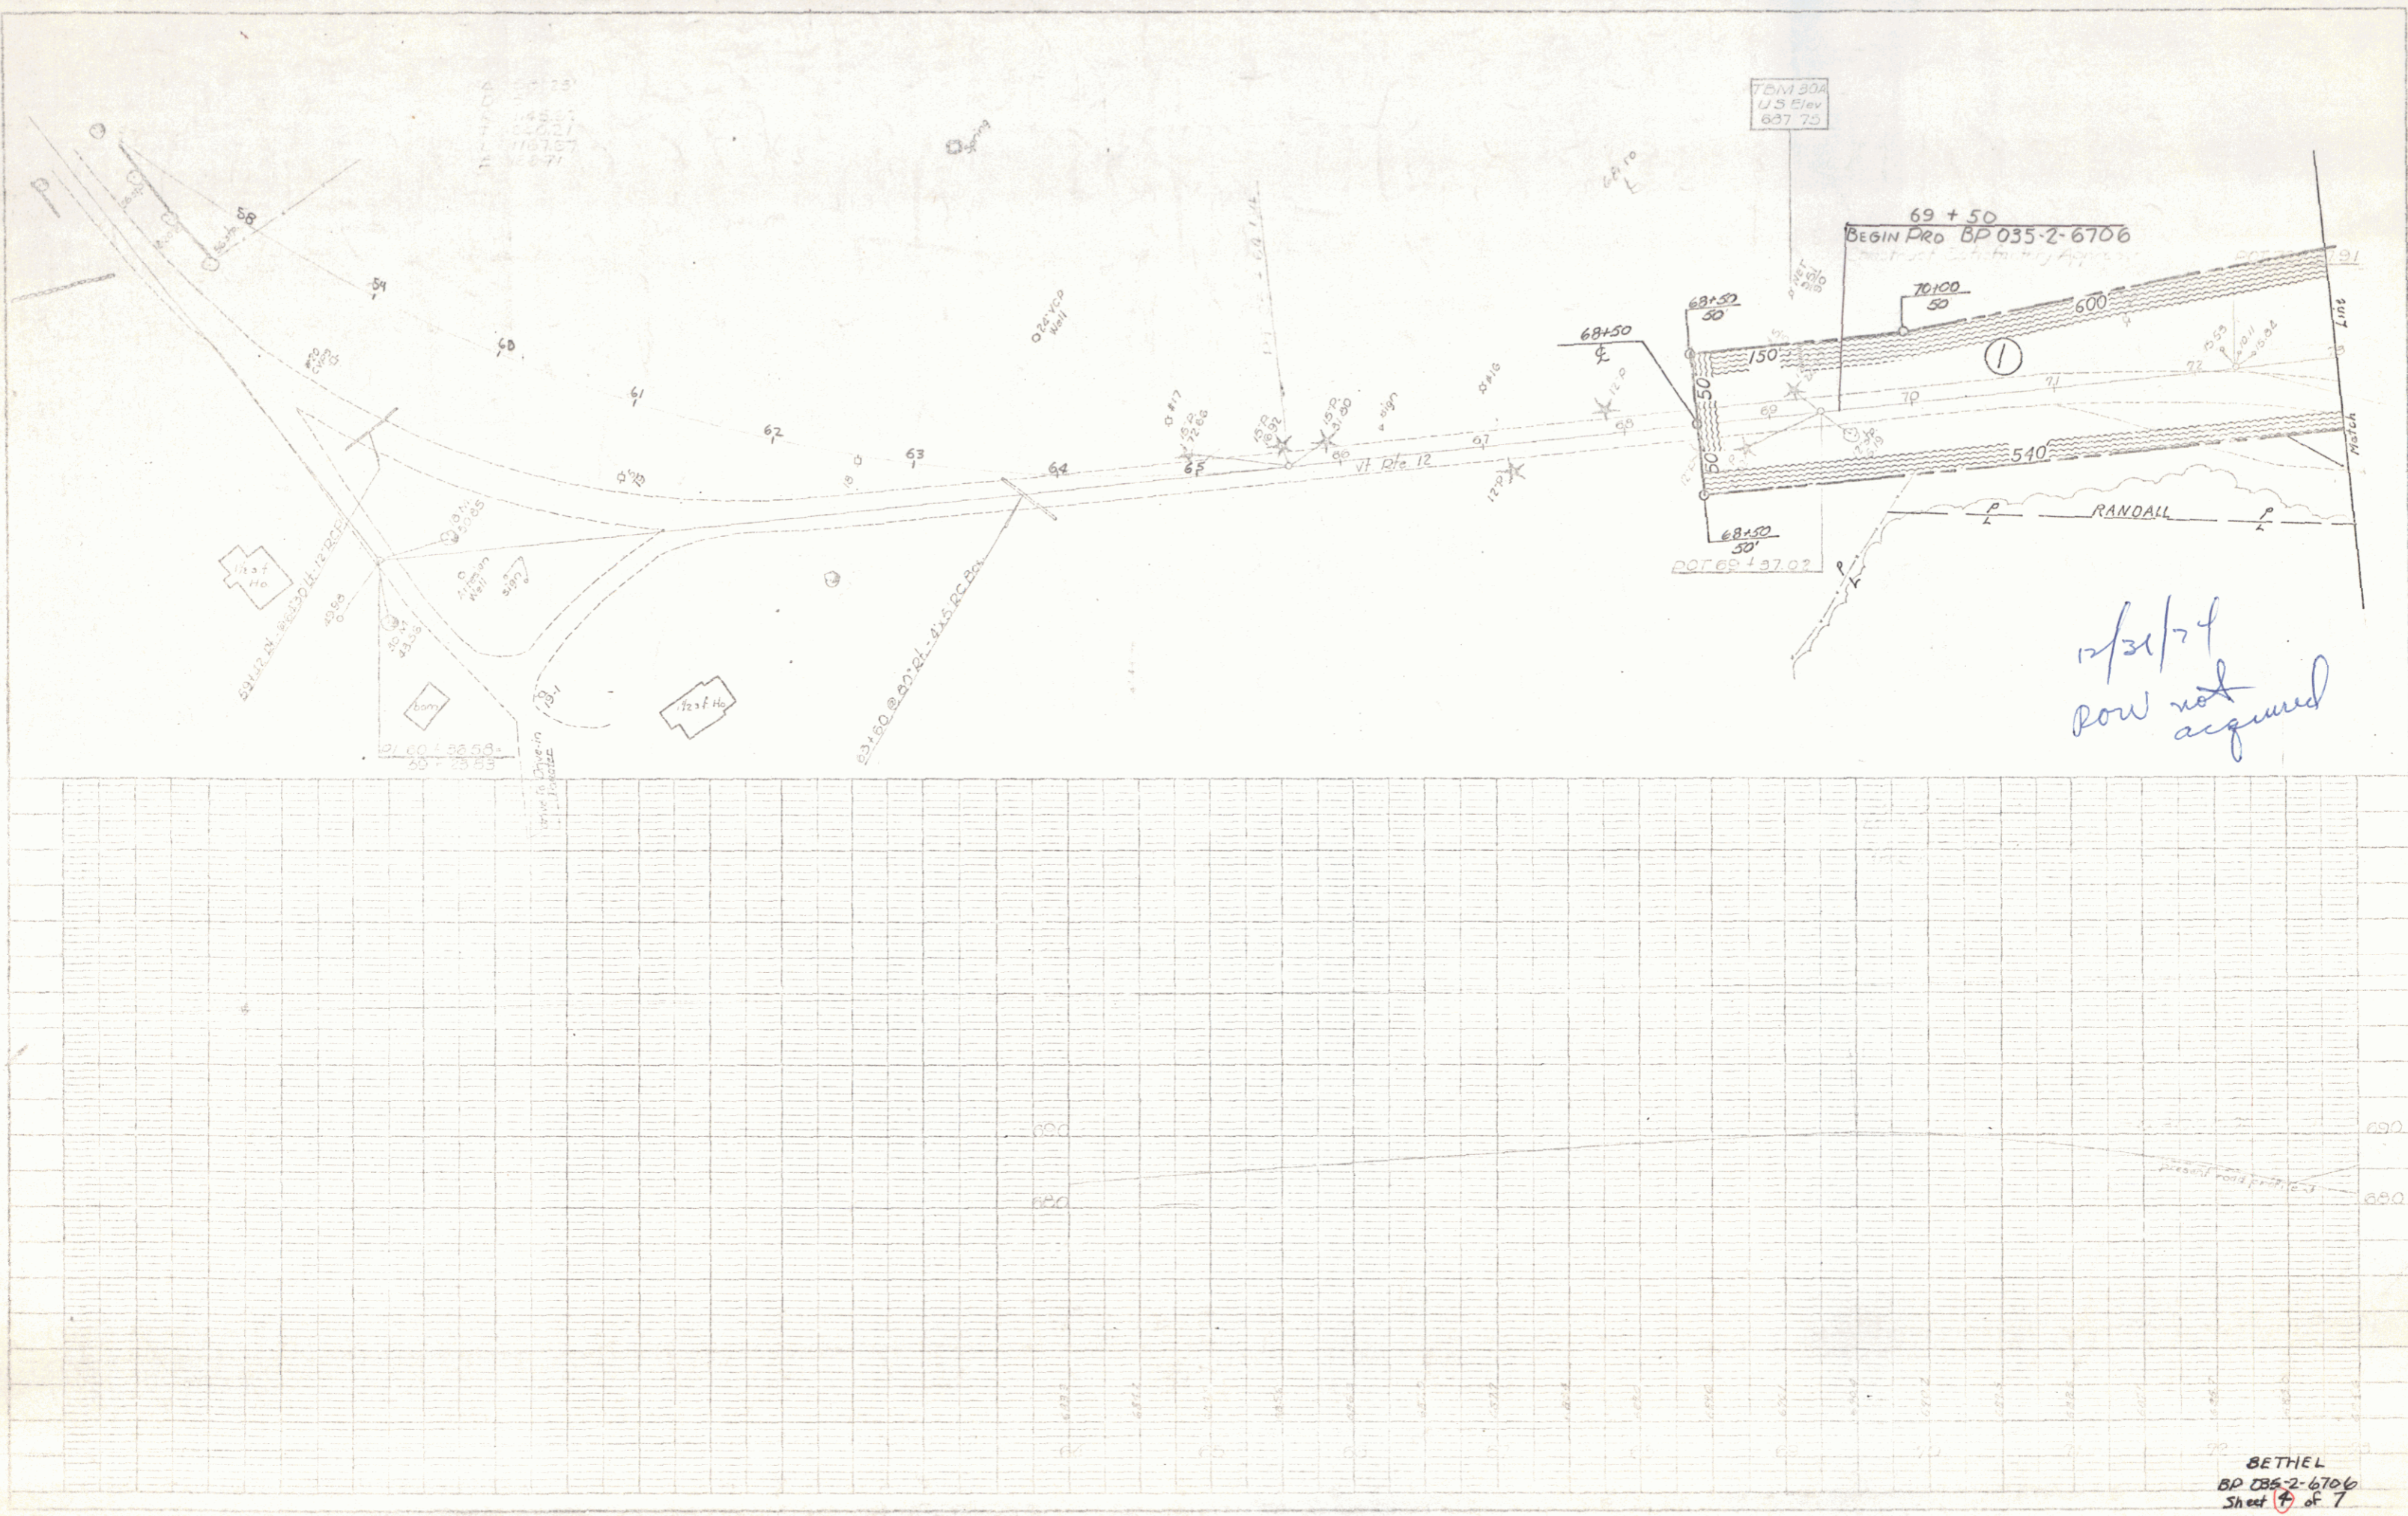

12/31/74
 ROW not
 acquired

BETHEL
 BP 035-2-6706
 Sheet 6 of 7

Construct Approach
73+00 - 75+50 RA.

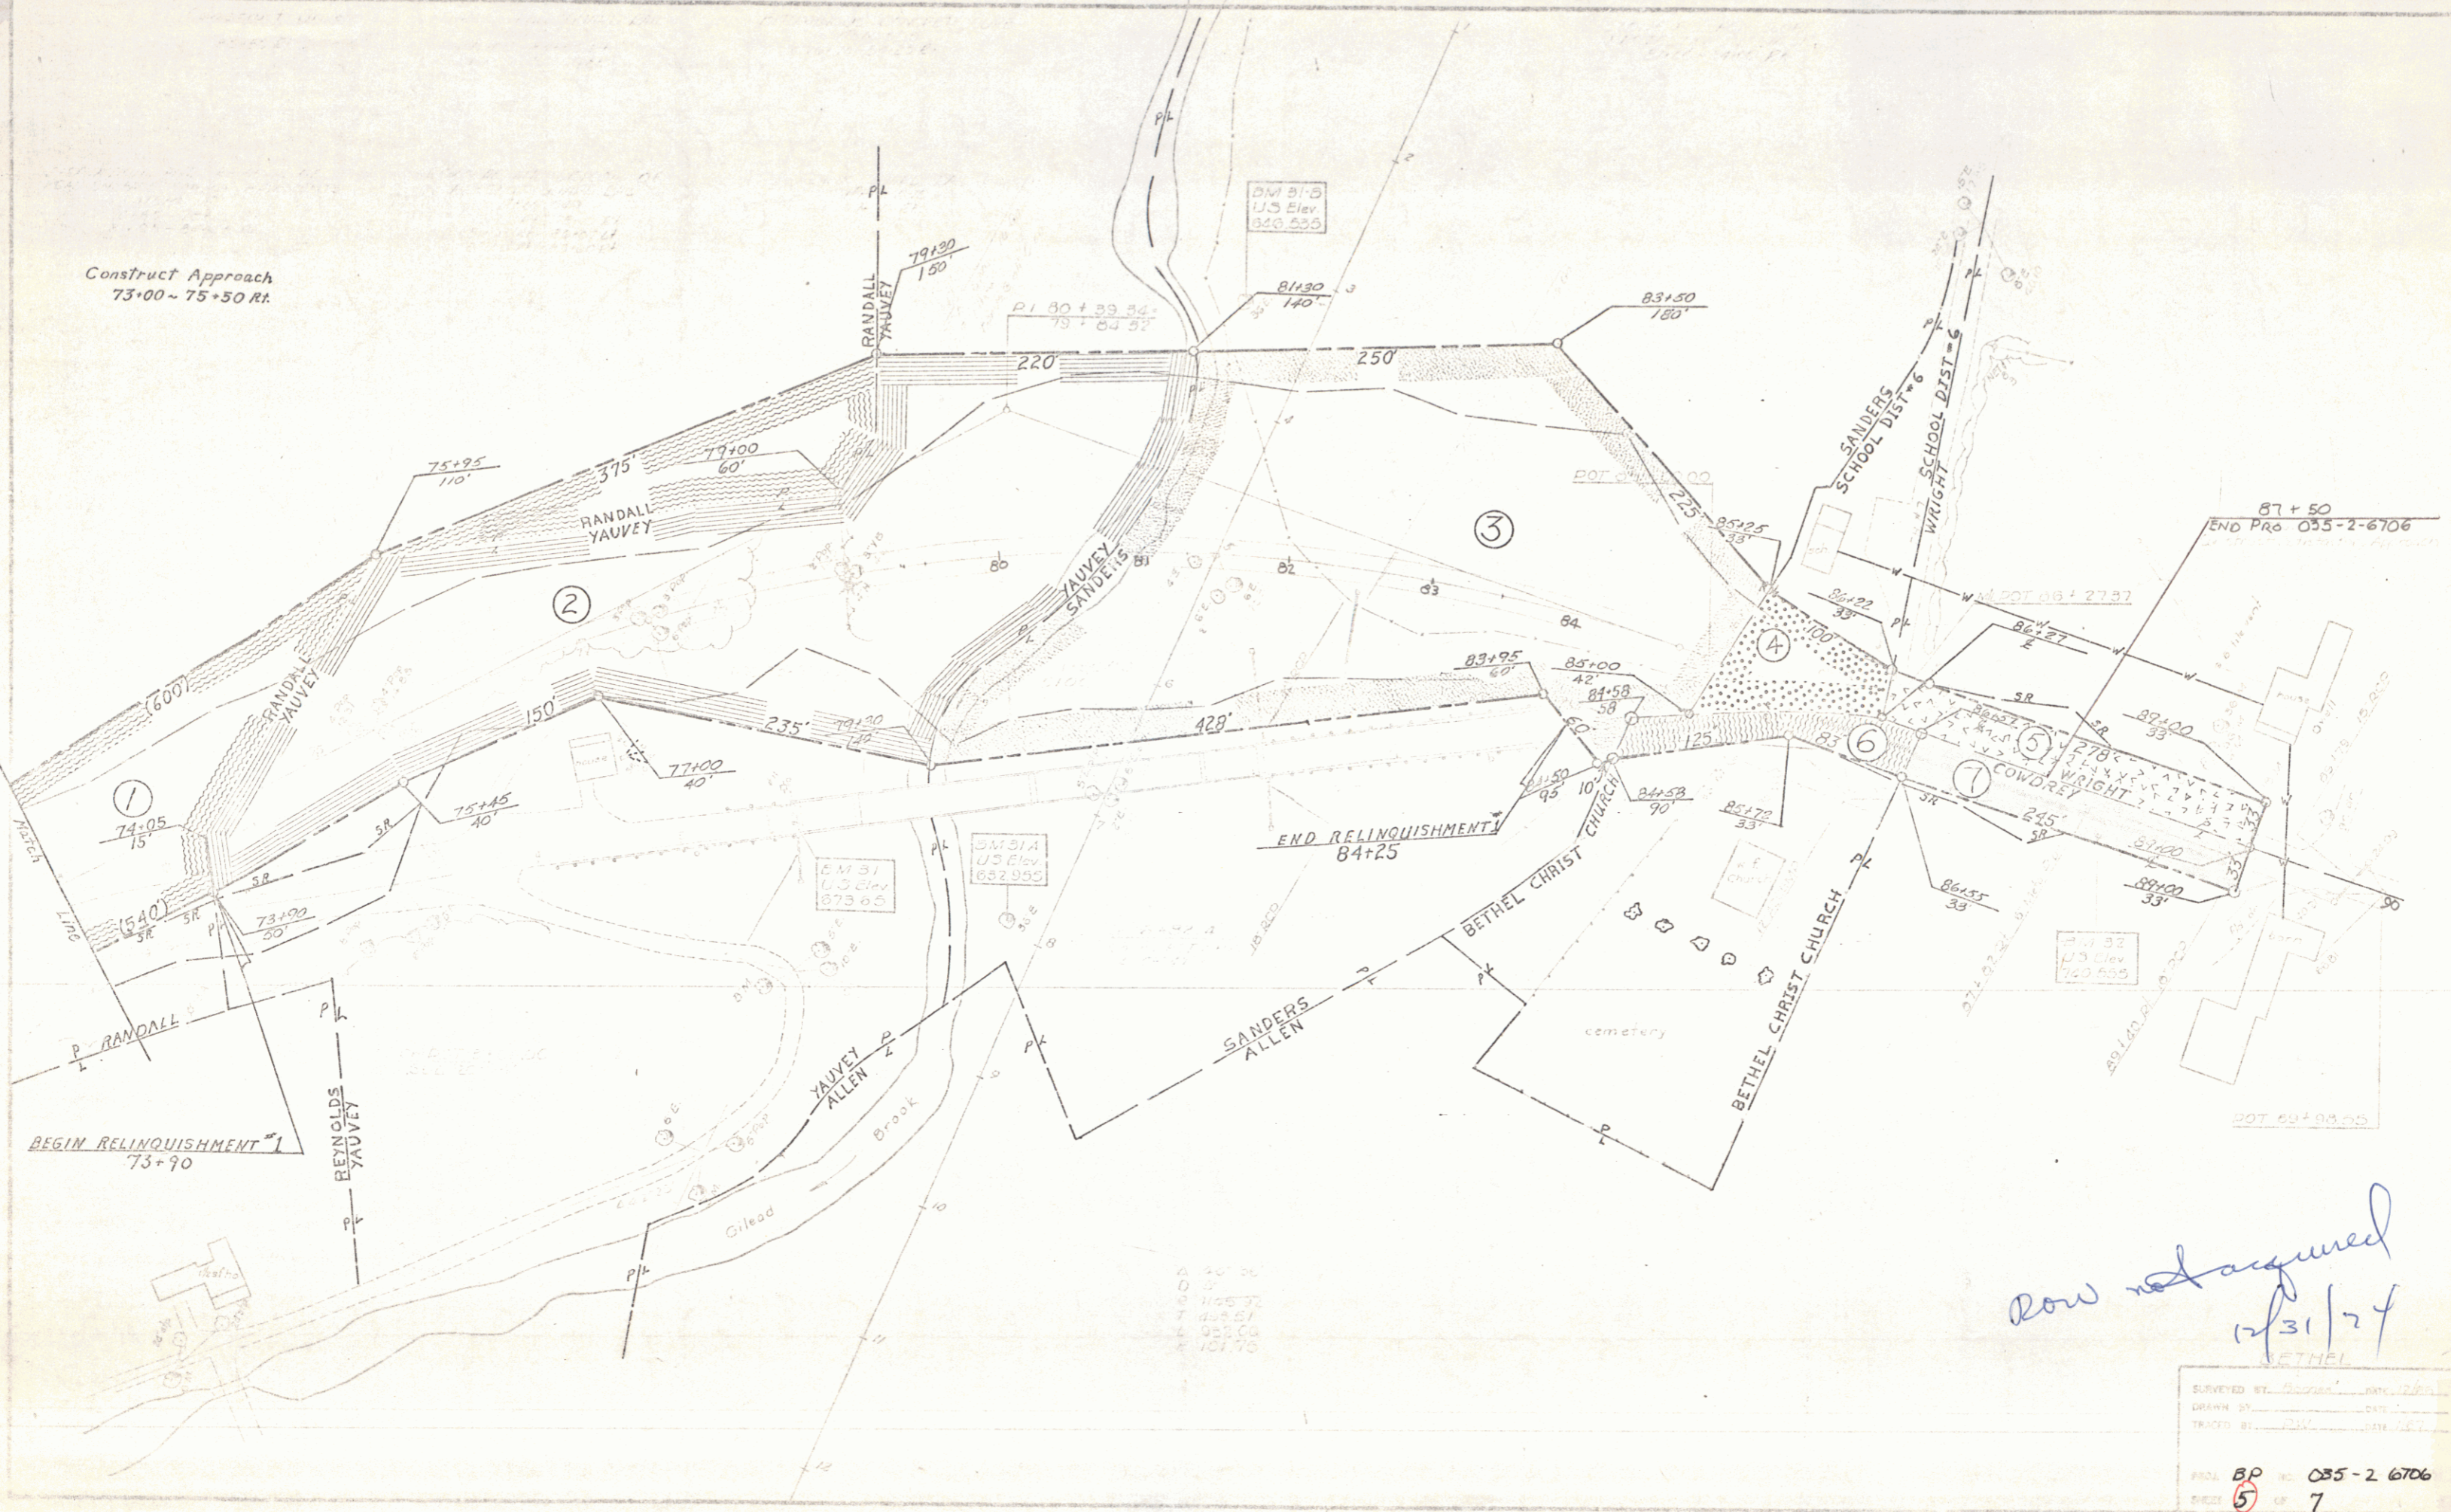

Row not acquired
12/31/74

SURVEYED BY: _____ DATE: _____
DRAWN BY: _____ DATE: _____
TRACED BY: _____ DATE: _____
SCALE: 80' = 1"
SHEET 5 OF 7