
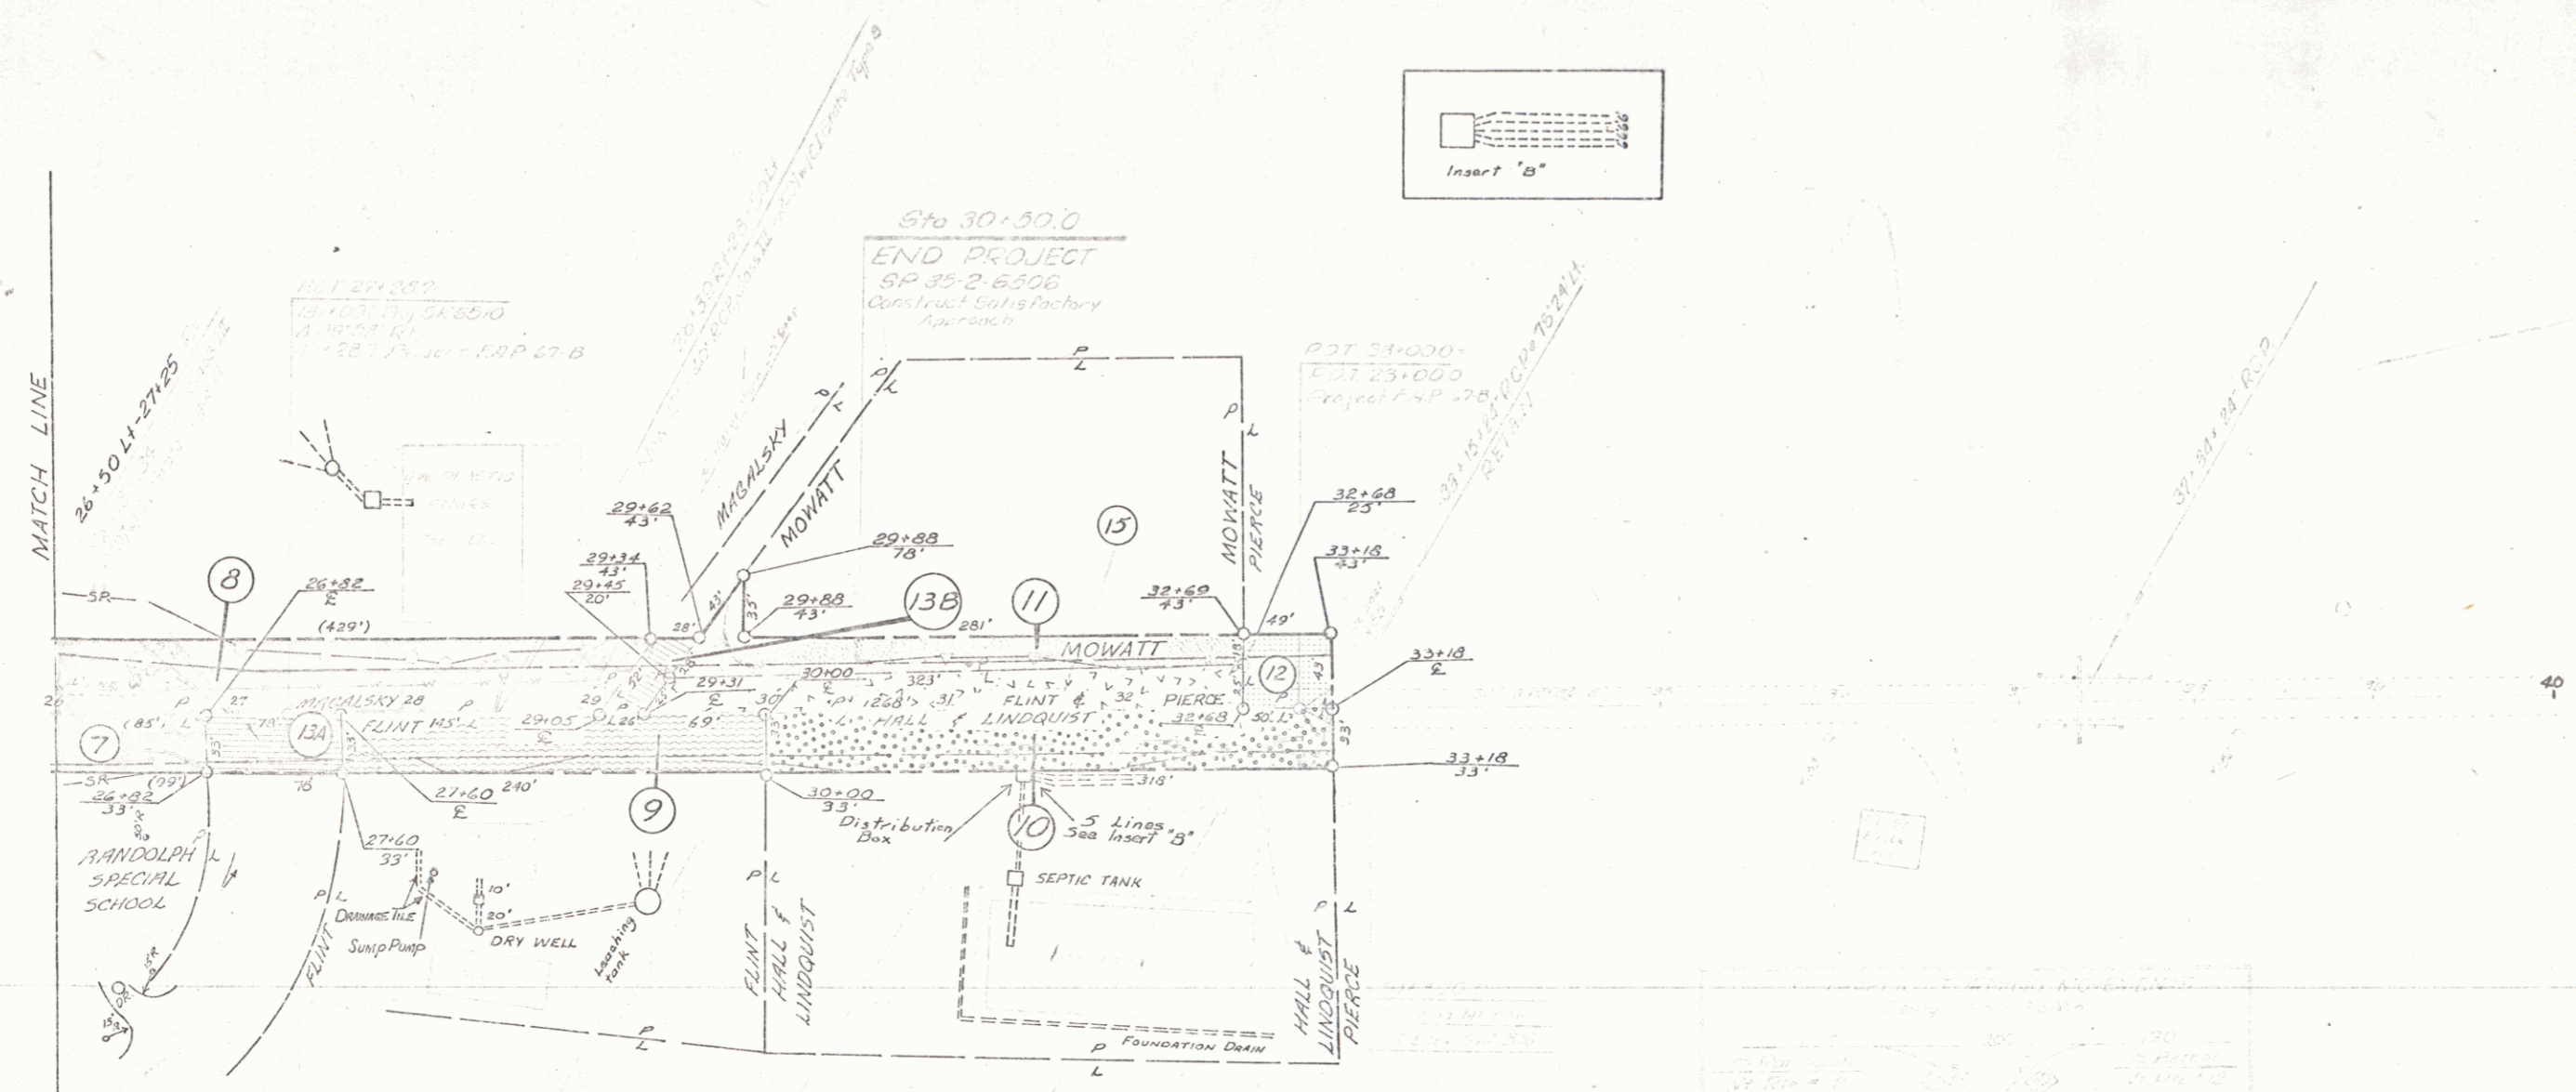


GRANITE CURB	GRANITE SLOPE EDGING	CONSTRUCT DRIVE	CONSTRUCT APPROACH	THREE CABLE GUARD RAIL WITH STEEL POSTS	PAVED GUTTER
LI 26+50.00 27+00.00 27+50.00	RI 27+00.00 27+50.00 28+00.00	LI 28+00.00 28+50.00 29+00.00	RI 28+50.00 29+00.00 29+50.00	LI 29+50.00 30+00.00 30+50.00	RI 30+00.00 30+50.00 31+00.00

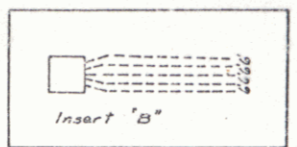

MATCH LINE

Sta 30+50.0  
END PROJECT  
SP 35-2-6508  
Construct Satisfactory  
Approach

RANDOLPH  
SPECIAL  
SCHOOL

DESIGNED BY: [Signature]  
DRAWN BY: [Signature]  
CHECKED BY: [Signature]  
DATE: [Date]  
PROJECT NO. 35-2-6508  
SHEET NO. 10