

INDEX OF SHEETS

STATE OF VERMONT
DEPARTMENT OF HIGHWAYS

PROPOSED IMPROVEMENT

FEDERAL AID SECONDARY

TOWN OF RANDOLPH

COUNTY OF ORANGE

VERMONT ROUTE 12

BETHEL - MONTPELIER ROAD

Pin# 99R944

R.O.W. PLANS

BEGINNING AT A POINT APPROXIMATELY 300 FEET
WEST OF THE RANDOLPH VILLAGE LINE AND
EXTENDING IN AN EASTERLY DIRECTION 0.114 MILE

LENGTH OF PROJECT 600.00 FEET = 0.1135 MILES
LENGTH OF ROADWAY 567.76 FEET = 1.062 MILES
LENGTH OF BRIDGE 32.24 FEET = 0.061 MILES
LENGTH OF R.O.W. PROJECT = 1050 FEET = 0.199 MILES

1975 ADT =
1995 ADT =
1995 DHV =
D =
T =
V = 40 MPH


BEGIN R.O.W. PROJECT MP 2.991

BRF RF 035-2(2) STA. 18+00

END R.O.W. PROJECT

BRF RF 035-2(2) STA. 28+50

MP 3.190

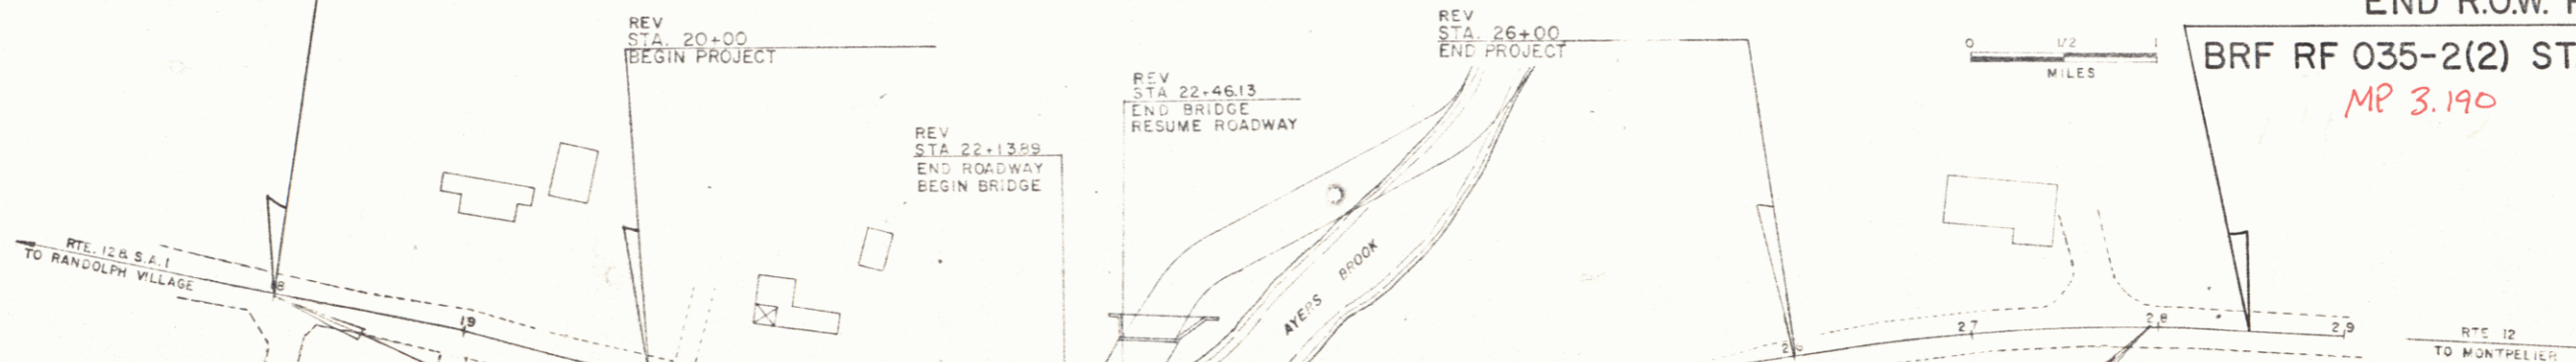

CONVENTIONAL SIGNS

POINT OF ACCESS	X
LIMITS OF ACCESS	---
COUNTY LINE	---
TOWN LINE	---
FENCE LINE	---
STONE WALL	---
UNFENCED PROPERTY	---
GUARD RAIL	---
TRAVELED WAY	---
RAILROAD	---
RETAINING	---
CEN	---
SURVEY	---
CULVERT	---
DROP INLET	---
TROLLEY POLE	---
POWER POLE	---
TELEPHONE POLE	---
TREES	---
HEDGE	---
FA. CONSTRUCTION IDENTIFICATION SIGNS	A

SLOPE RIGHTS	SR
GROUND ELEVATION	DATUM
GRADE ELEVATION	DATUM
CURVE DATA	D
DEFLECTION OF ANGLE	D
DEGREE OF CURVE	D
RADIUS OF CURVE	R
TANGENT DISTANCE	T
LENGTH OF CURVE	L
EXTERNAL DISTANCE	E
POINT OF INTERSECTION	P.I.
POINT OF CURVE	P.C.
POINT OF TANGENT	P.T.
POINT ON TANGENT	P.O.T.
POINT ON SUB-TANGENT	POST
R.O.W. LIMITS	---

FOR RIGHT OF WAY DETAILS,
SEE RIGHT OF WAY PLANS FOR THIS PROJECT.

BENCH MARKS BASED ON ELEVATIONS



CONSTRUCTION LIMITS
18+00 TO 28+00

THESE PLANS ARE SUBJECT TO SUCH REVISIONS AS MAY BE
REQUIRED BY THE BUREAU OF PUBLIC ROADS OR THE COMMISSIONER
OF HIGHWAYS.
CONSTRUCTION IS TO BE CARRIED ON IN ACCORDANCE WITH
THESE PLANS AND THE STANDARD SPECIFICATIONS FOR HIGHWAY AND BRIDGE
CONSTRUCTION DATED APRIL 1964, AS APPROVED BY THE BUREAU OF
PUBLIC ROADS ON OCTOBER 12, 1964, INCLUDING ALL SUBSEQUENT
APPROVED REVISIONS AND SUCH REVISED SPECIFICATIONS AND SPECIAL
PROVISIONS AS ARE INCORPORATED IN THESE PLANS.

FEB 29 1980

APPROVED: *Wayne R. [Signature]*
SECOND DIRECTOR OF RIGHT-OF-WAY
DATE: 3-6-75

APPROVED: *D.O. [Signature]*
FILE ENGINEER
DATE: 5-6-75

DEPARTMENT OF COMMERCE
BUREAU OF PUBLIC ROADS

PROJECT: RANDOLPH

APPROVED

DIVISION: ENGINEER

DATE:

PROJECT: BRF RF 035-2 (2)

SHEET 1 OF 5 SHEETS