


*Under ground
from 485' Post
Elev. 345.70*

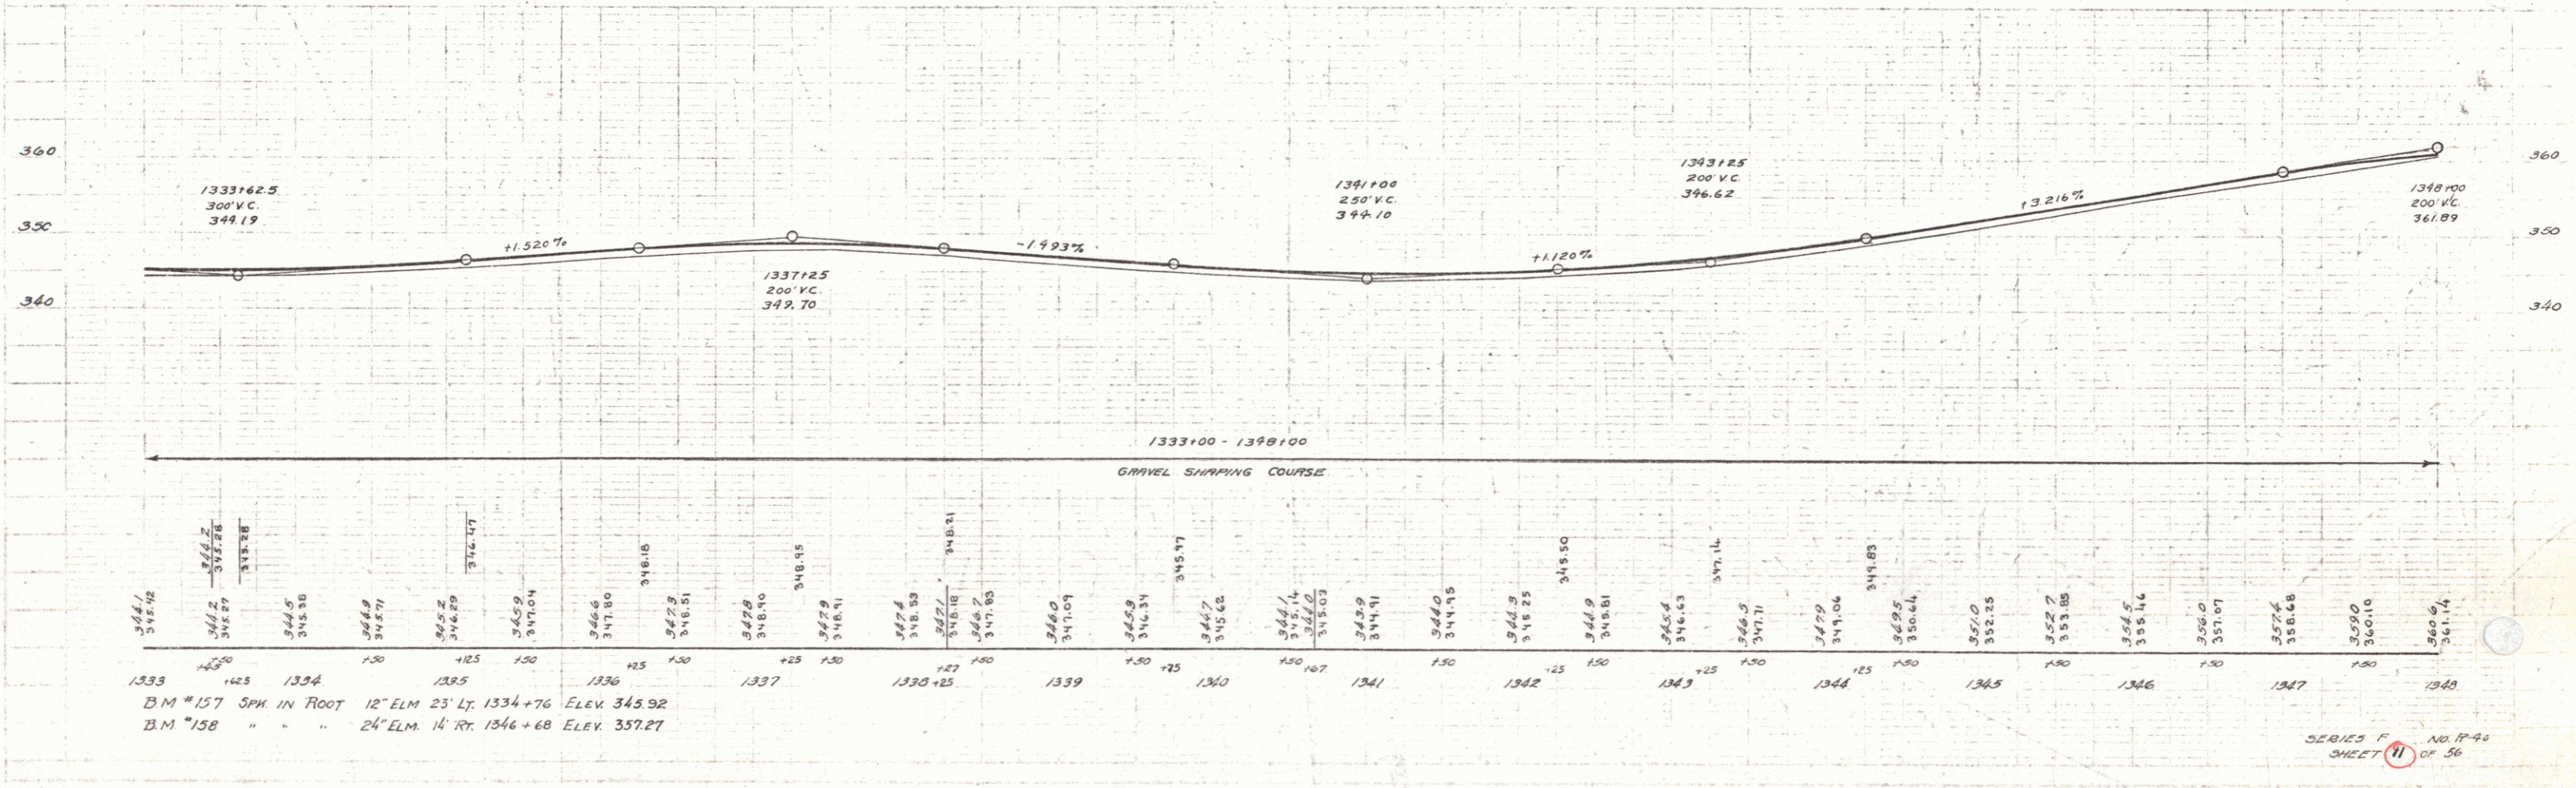

BM #157 5PK IN ROOT 12" ELM 25' LT. 1334+76 ELEV. 345.92
 BM #158 " " " 24" ELM. 14' RT. 1346+68 ELEV. 357.27