
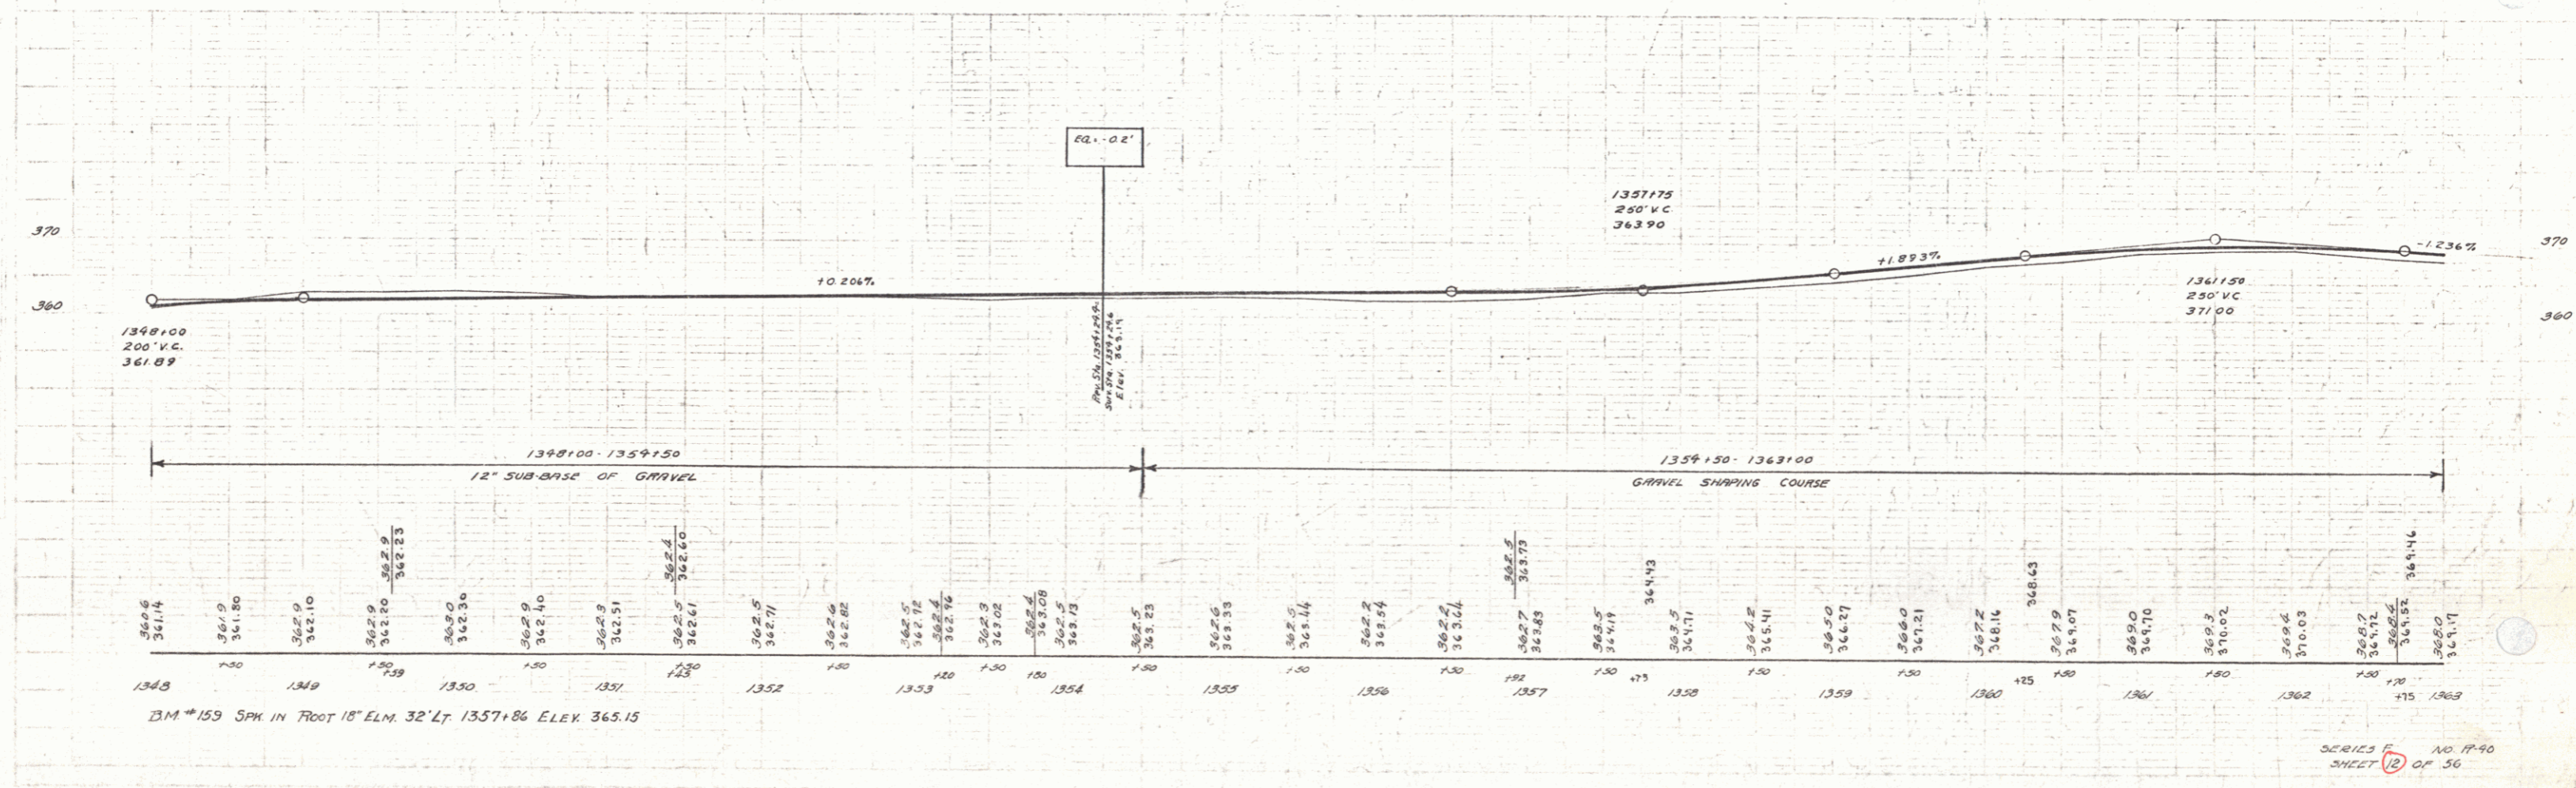


1354-92

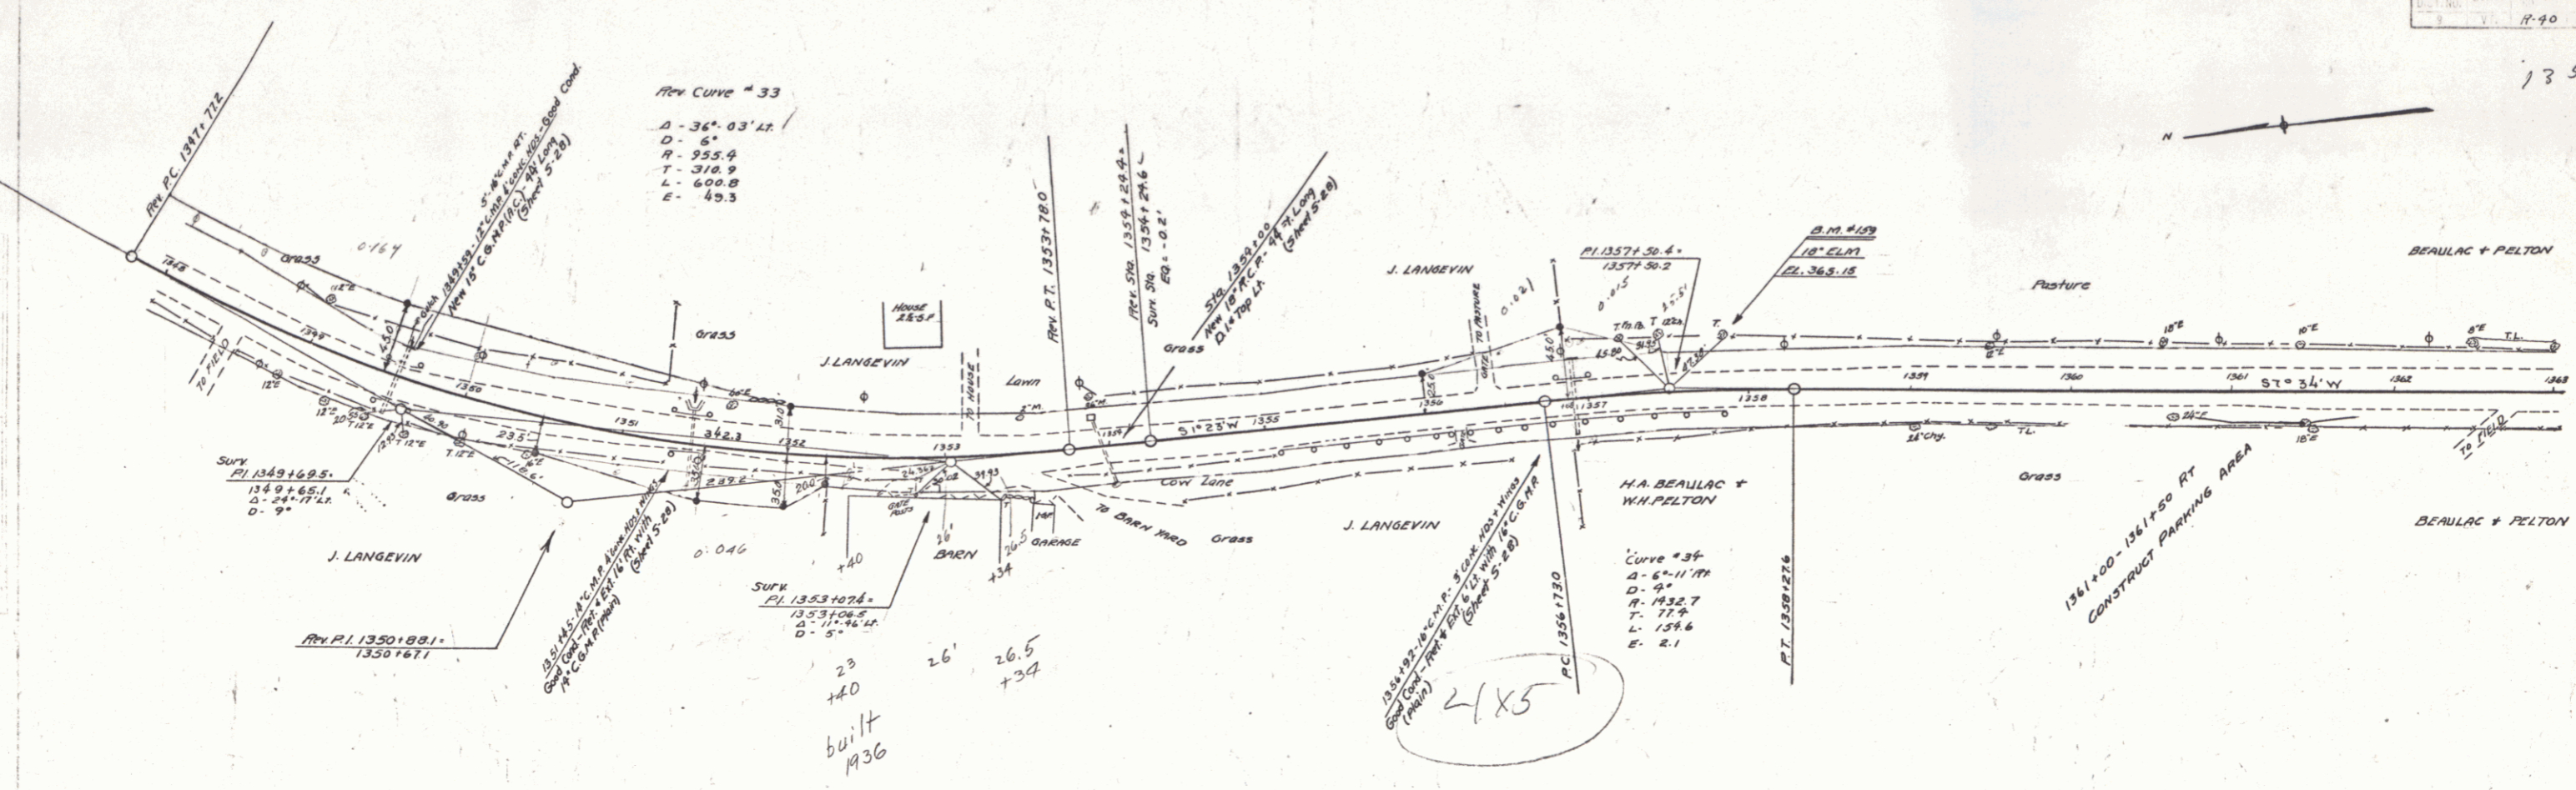

9