



DESIGNED BY  
 JOHN J. MALONEY  
 D. M. MACCHI  
 TEACED

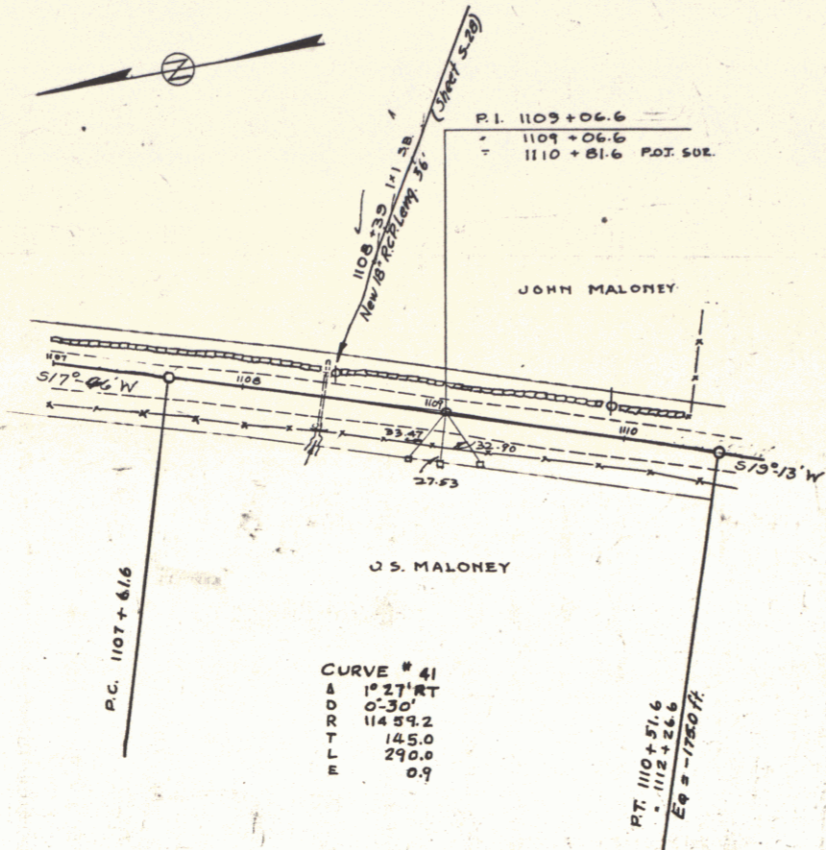

CURVE # 41  
 Δ 1° 27' RT  
 Δ 0-30'  
 R 145.82  
 L 145.0  
 T 290.0  
 E 0.9

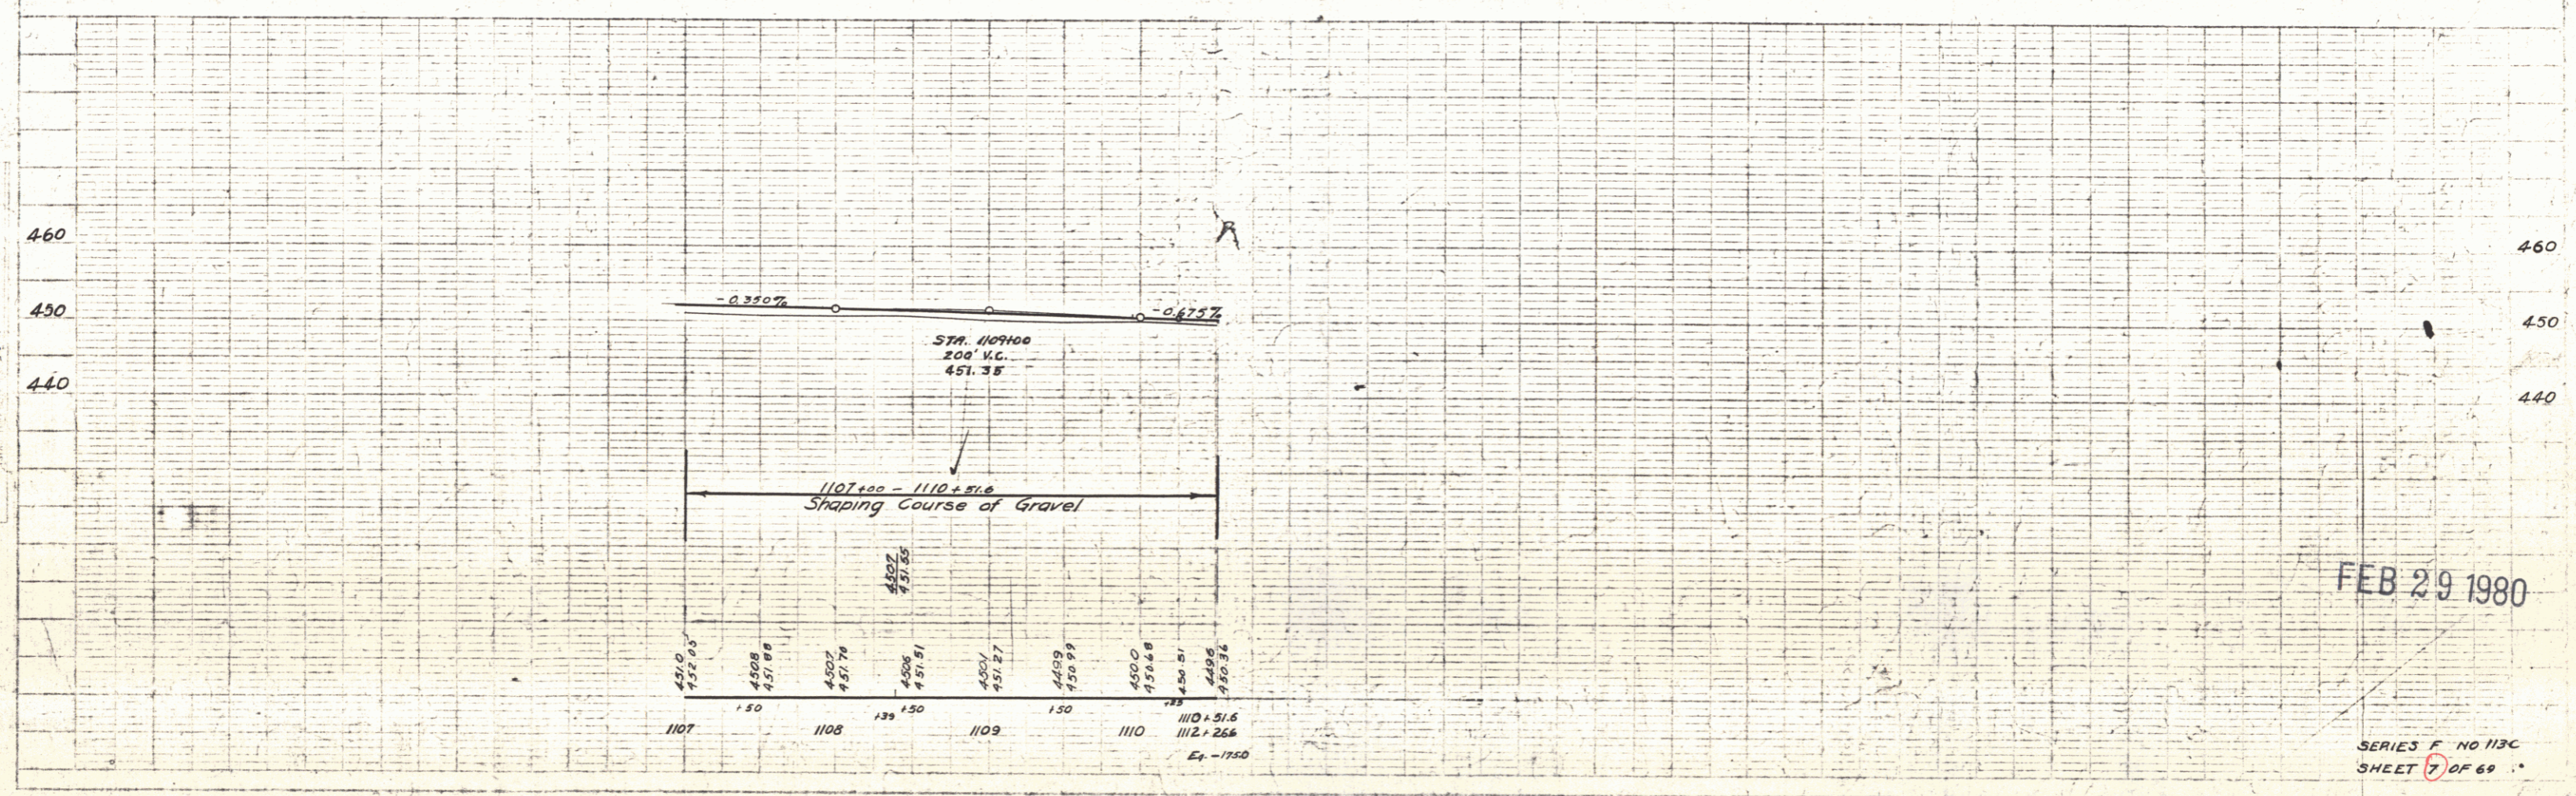

FEB 29 1980

SERIES F NO 113C  
 SHEET 7 OF 69